


Dimensions 135 x 24 x 143 mm

A circular ink stamp. The outer ring contains the text "J. P. RENHOLDSON &amp; SONS" at the top and "SOUTH SHIELDS" at the bottom. Inside the ring, the word "ENGINEERS" is at the top, "AND" is in the center, and "SHIP BUILDERS" is at the bottom. There are handwritten numbers "17/76" on the left and "18/73" on the right, flanking the central "AND".

Scale  $\frac{3}{4}$  - one foot

Hatchways liners & rivets  

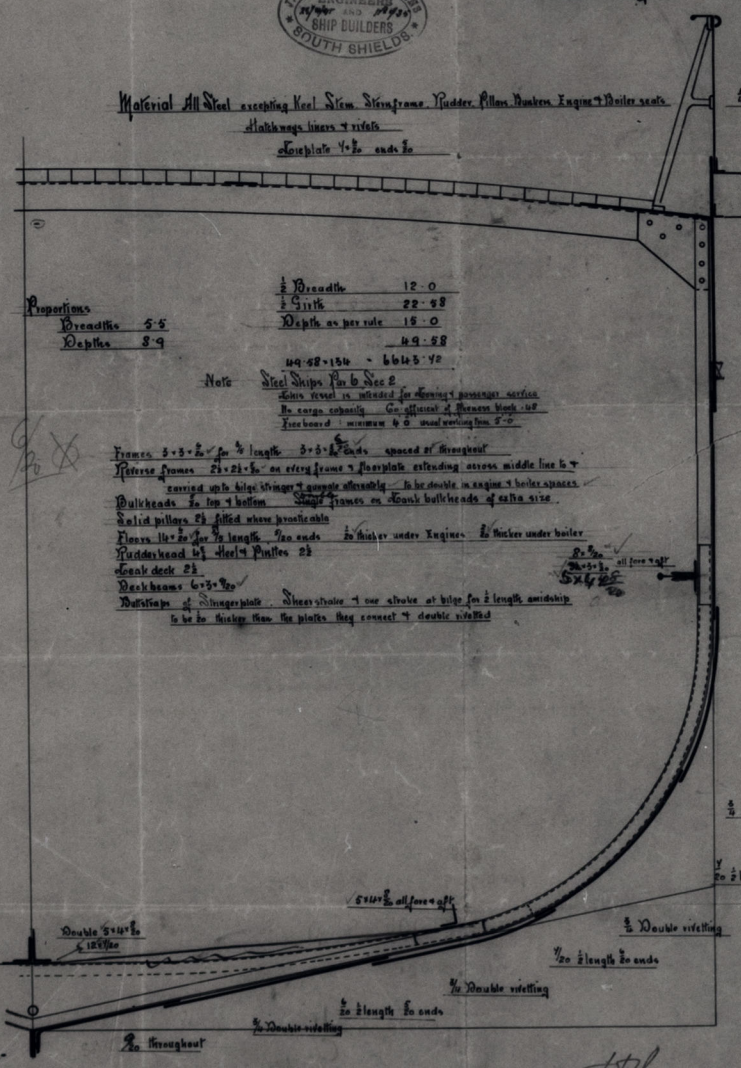

*Wm. H. Robinson*  
*with Mr. J. C.*  
*Robinson*

2/2

J.F.L.  
20/5/95