


23.4.95
30.4.95
30.5.95



4.95
4.95

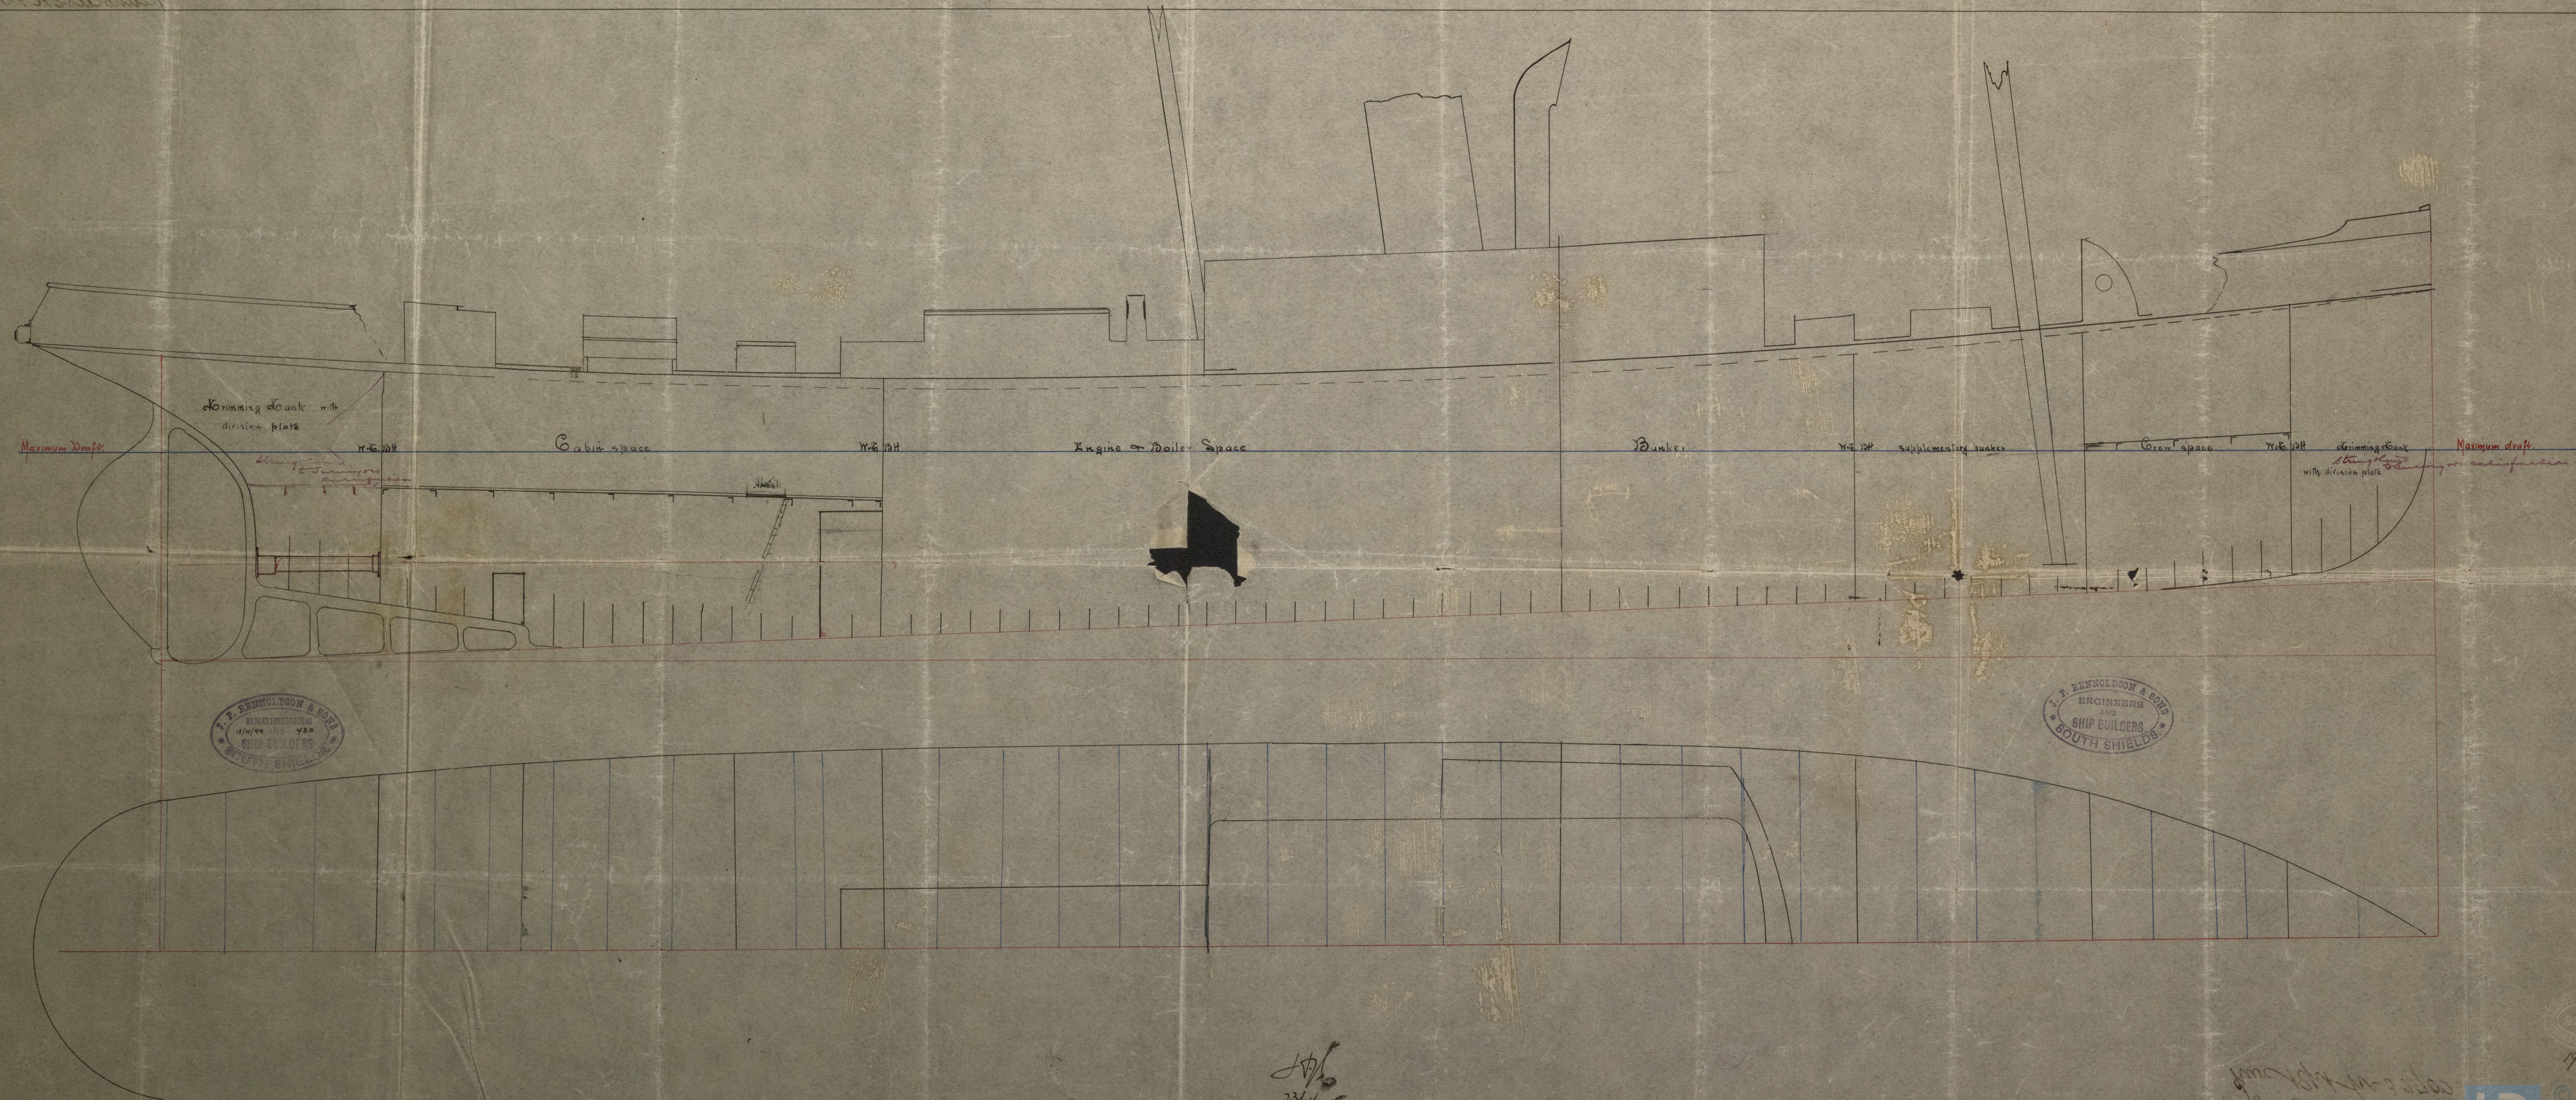

J. P. REMOLDSON & SONS
ENGINEERS
SHIP BUILDERS
SOUTH SHIELDS

J. P. REMOLDSON & SONS
ENGINEERS
AND
SHIP BUILDERS
SOUTH SHIELDS


29/4/95

28.6.1900
No 108
10000 tons



No 168-
Renoldson & Sons.



20 4 81
20 4 83

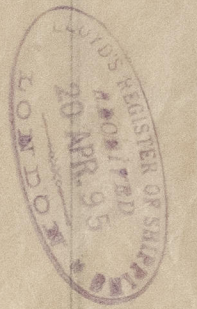

NW 844 - 0169

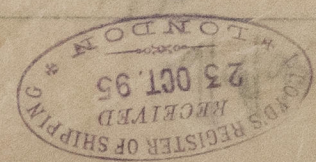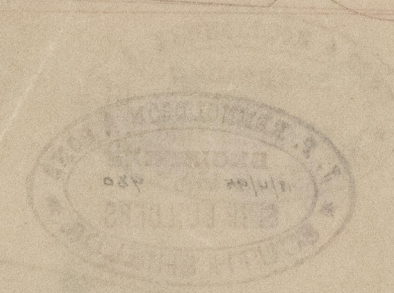


20/11/02

74/1

Renoldson & Sons
No 168.
S/s Champion
Auc Rpt no 32702

GEN ARRG

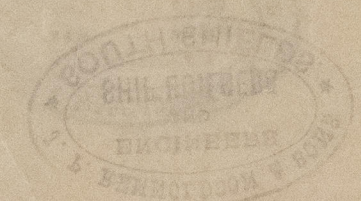

NWC8070169

10/11/02

10/11/02

10/11/02

10/11/02