



27.9.95

# BULKHEAD 65.

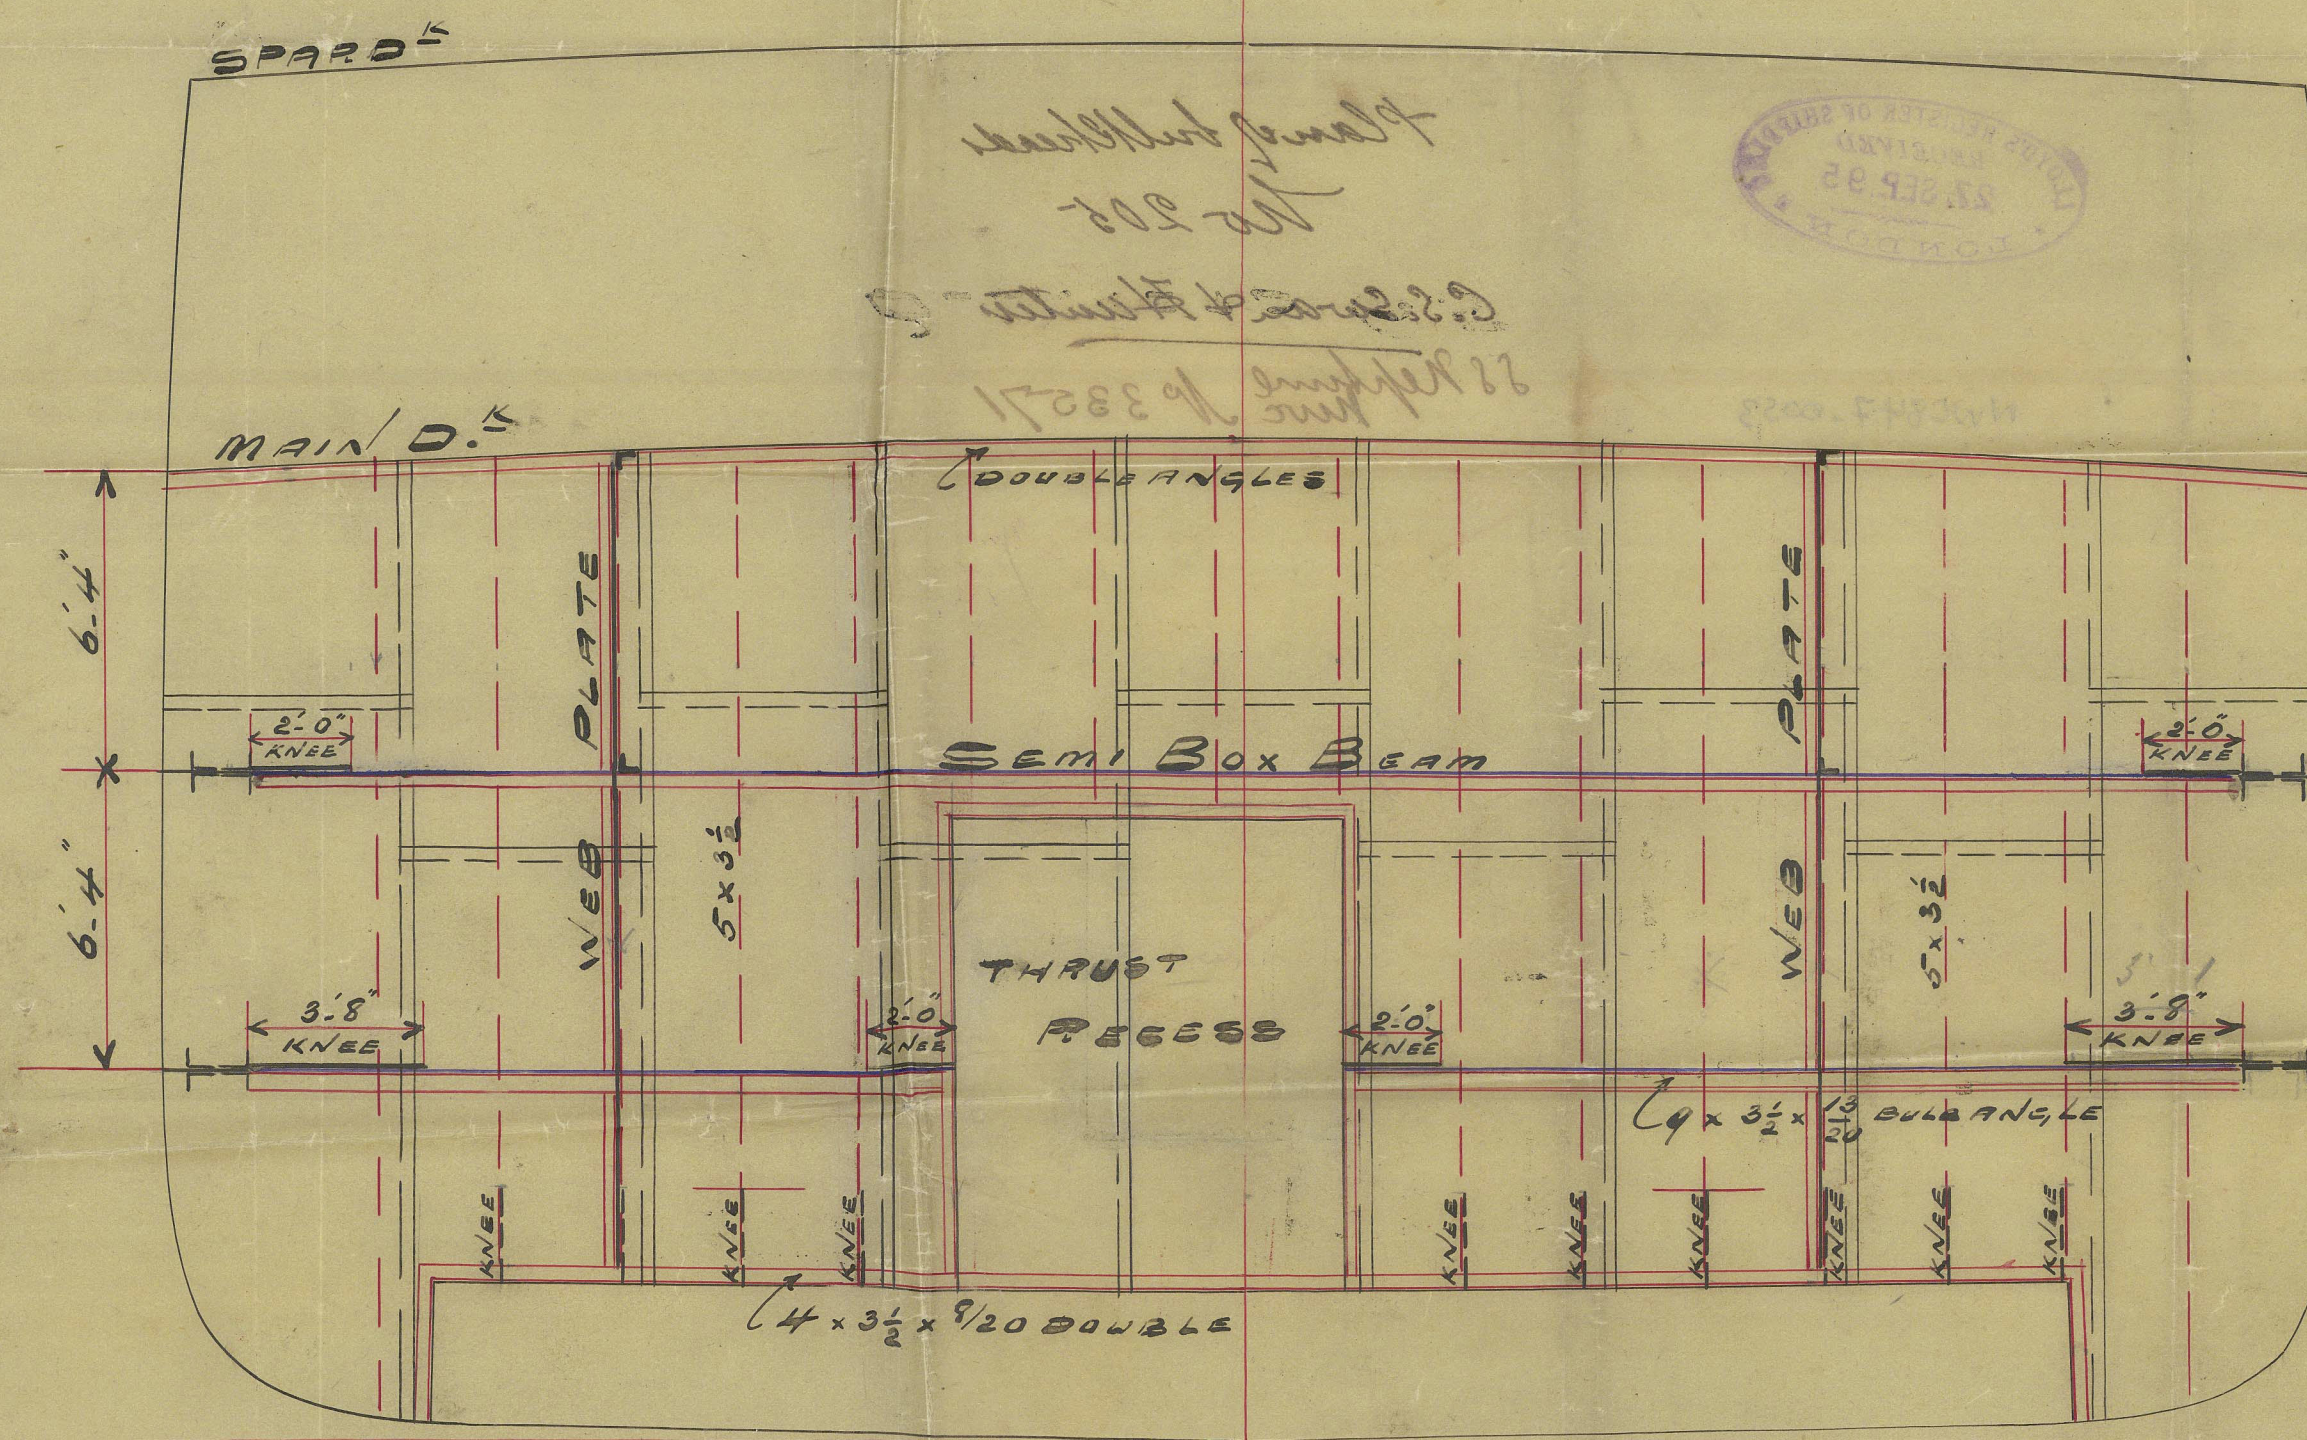


## SECTION OF BULKH<sup>d</sup> 65.

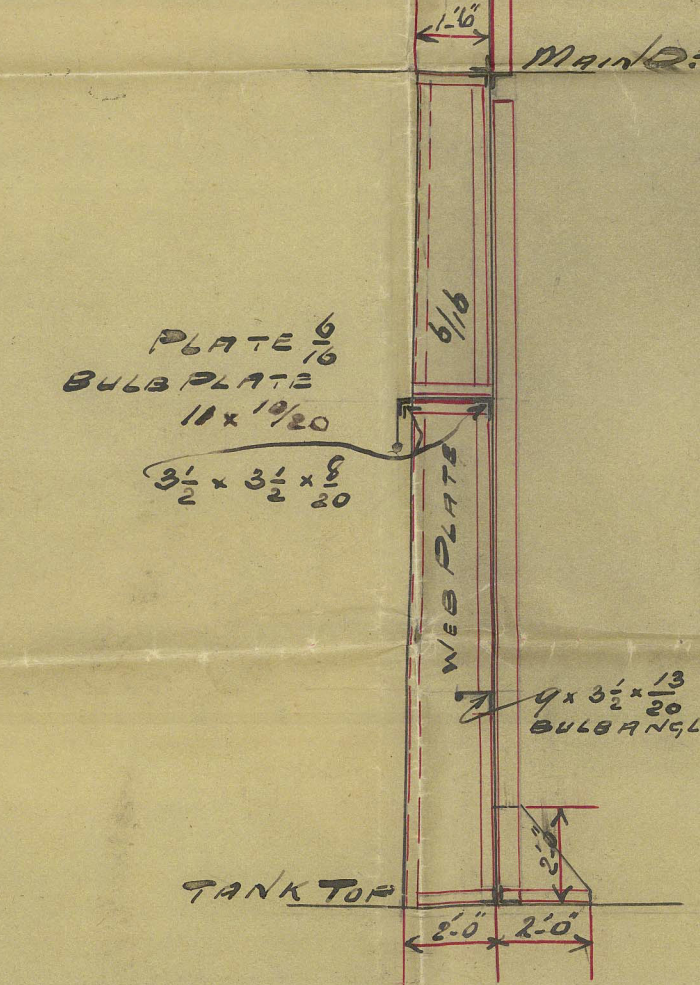


# PROPOSED STIFFENING OF BULKHEADS.


S.S. 205.  
BULKHEAD 85.

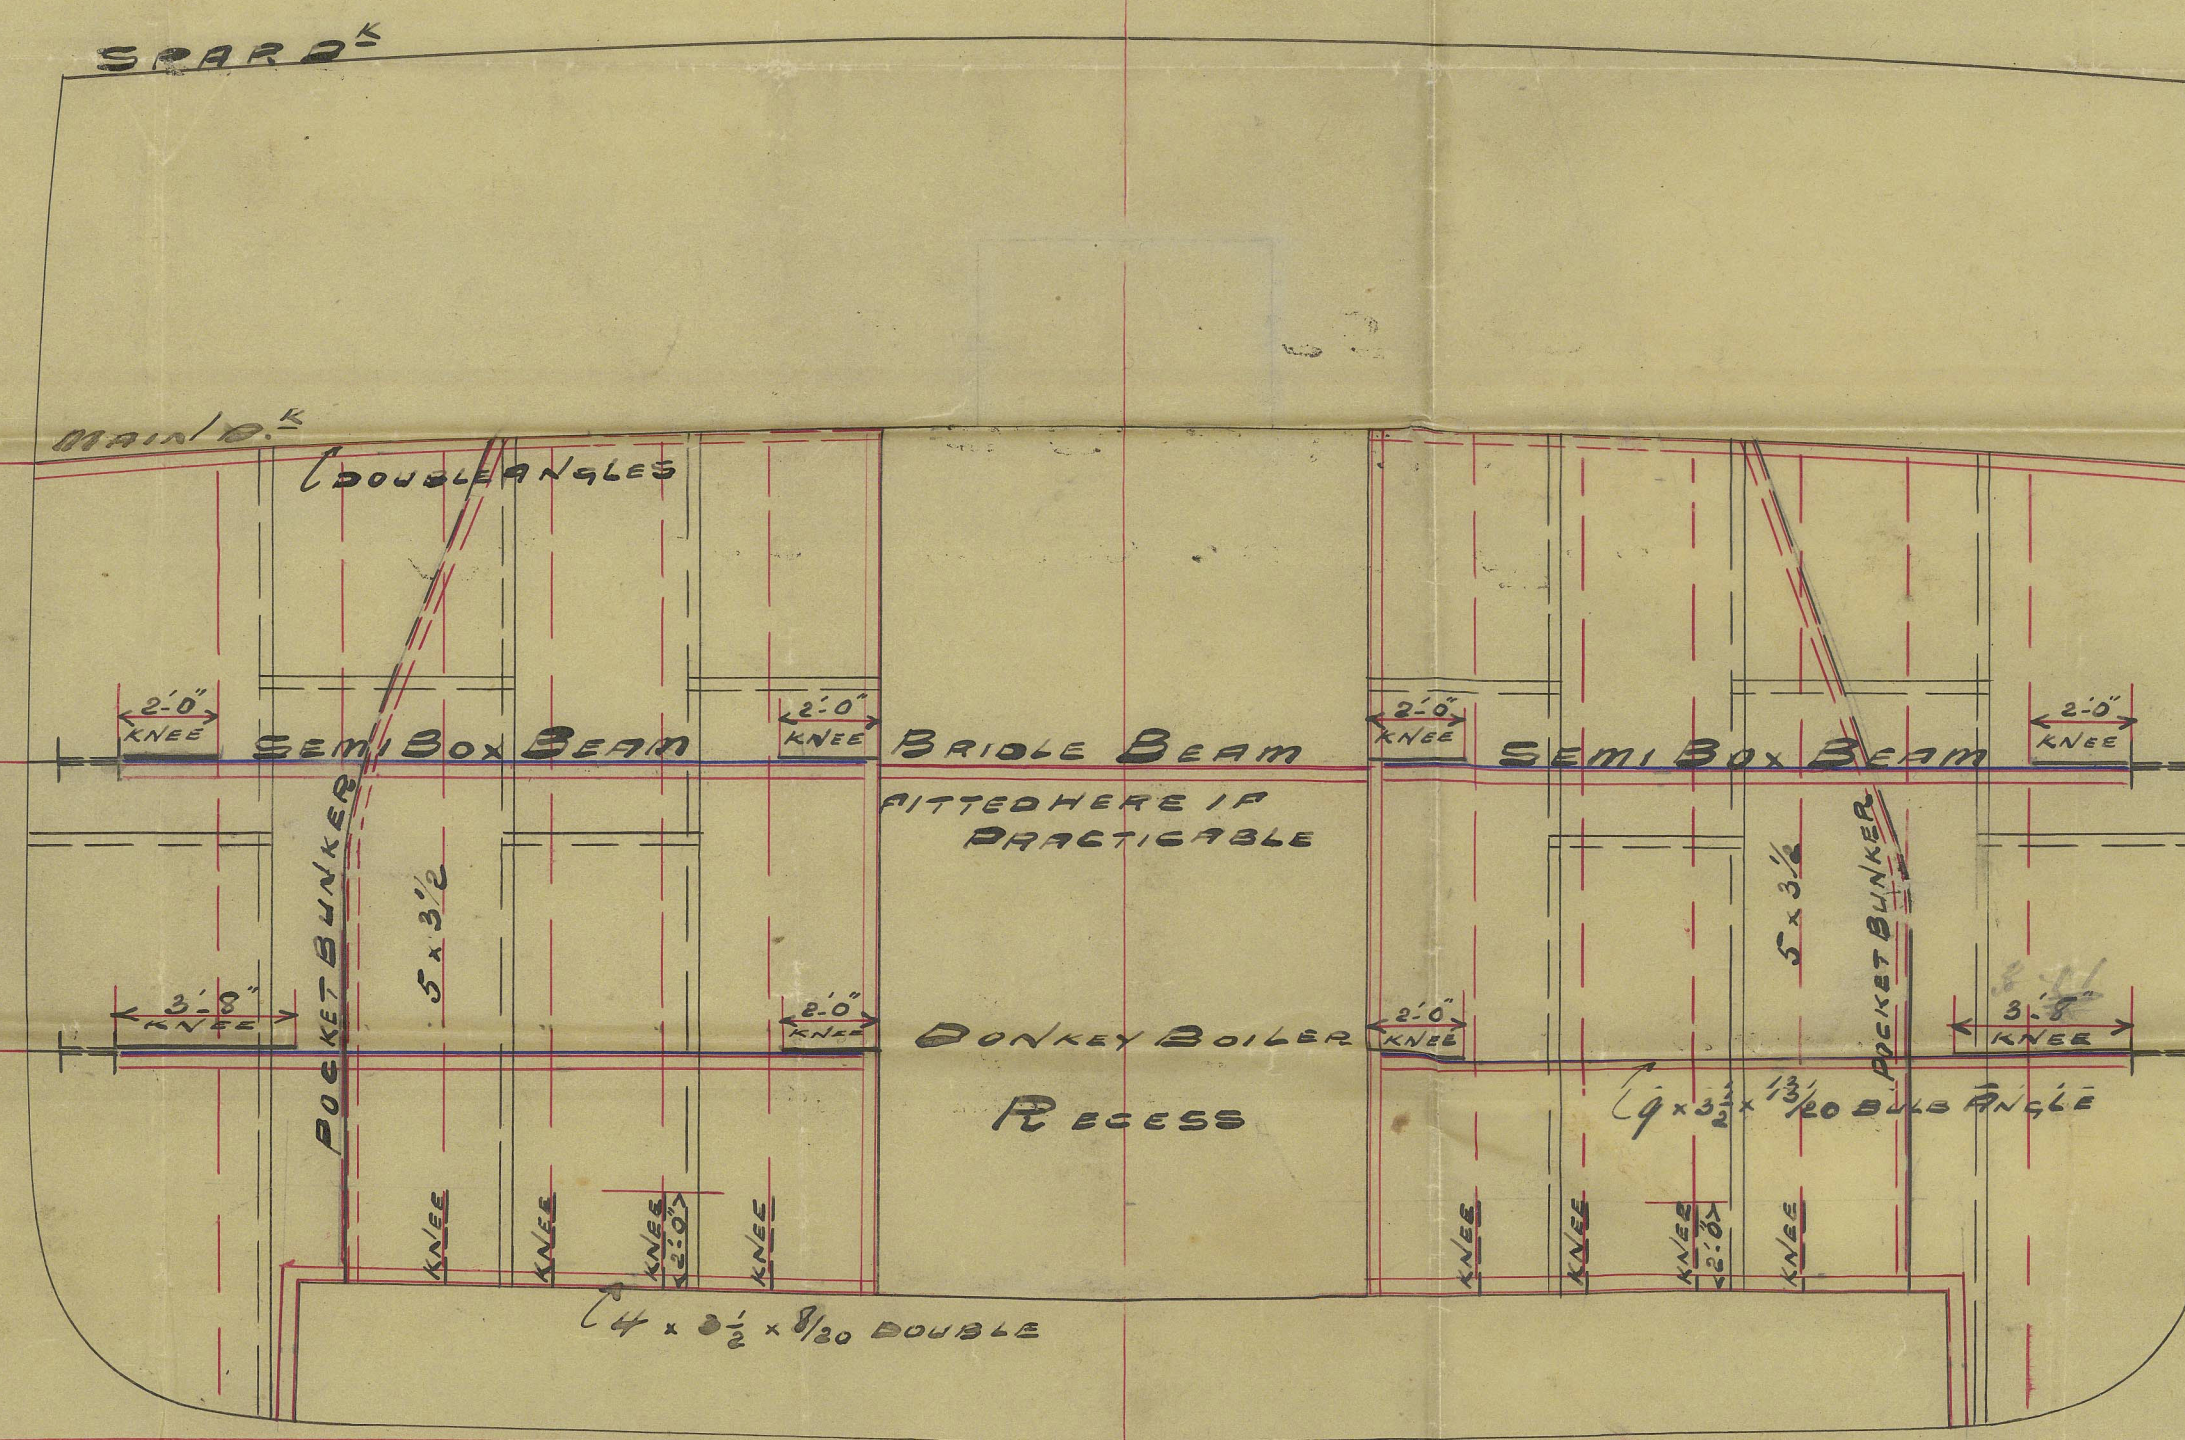


# BULKHEAD 125.

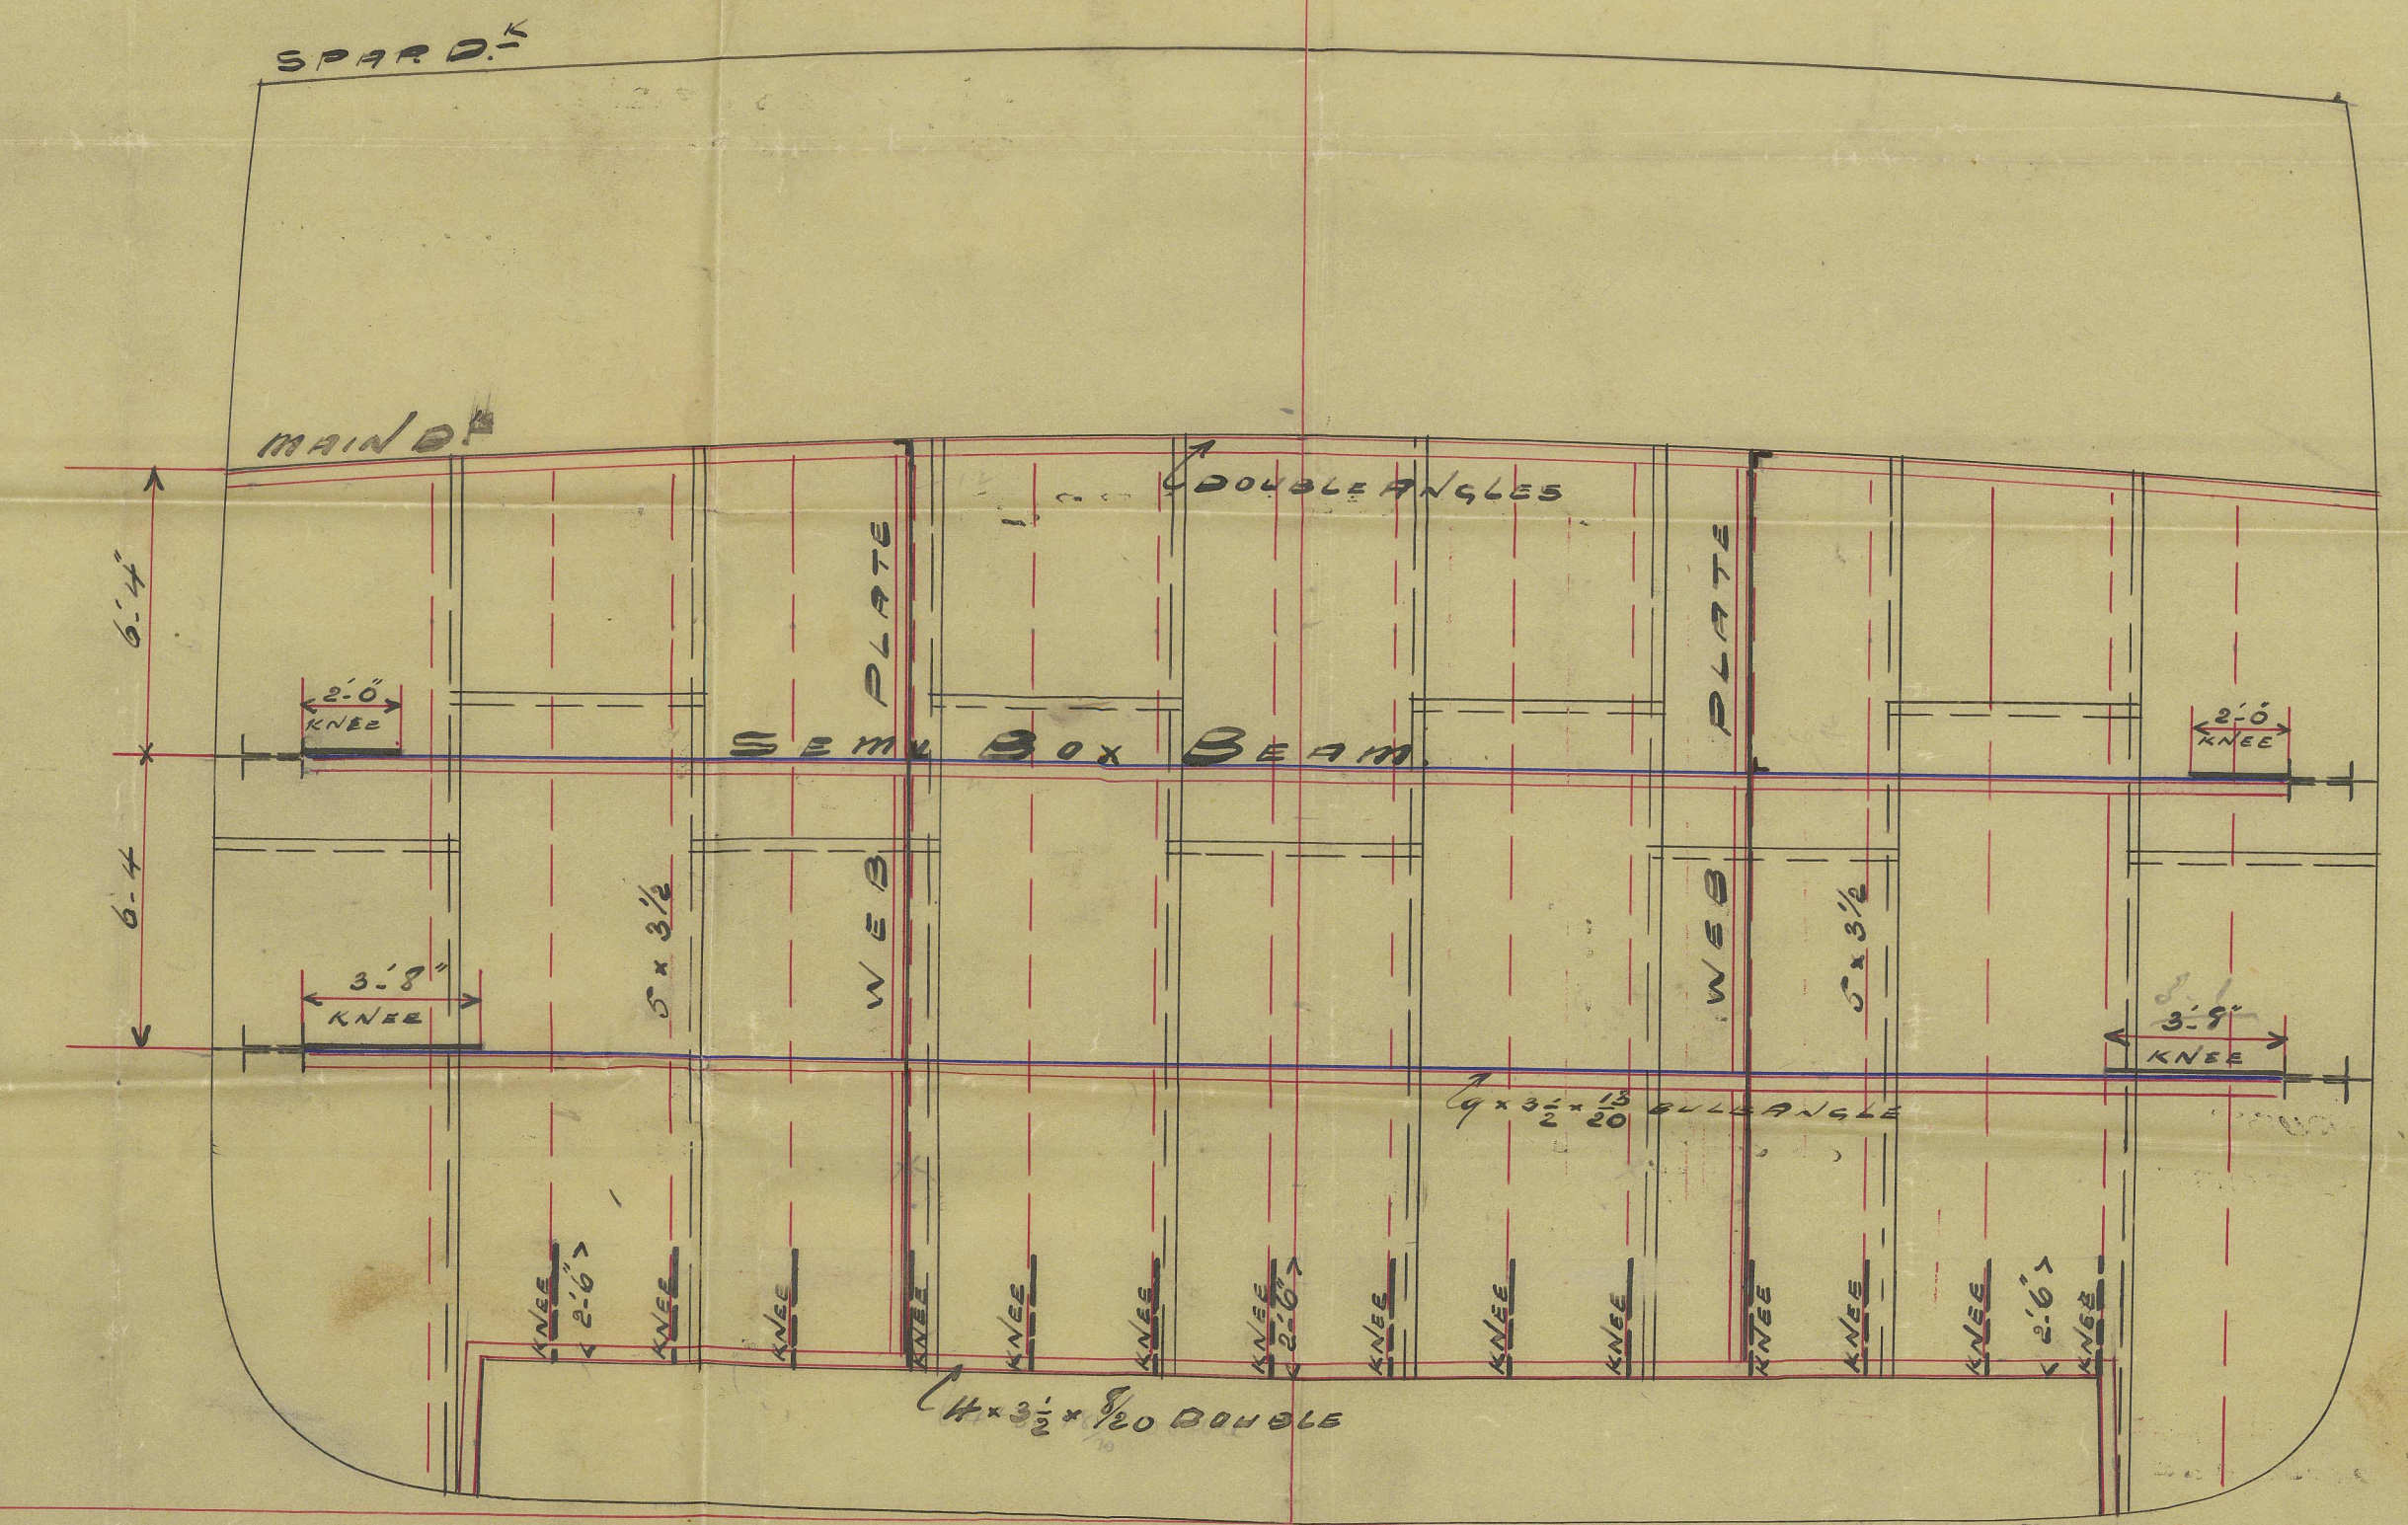

## SECTION OF BULKH<sup>d</sup> 125.

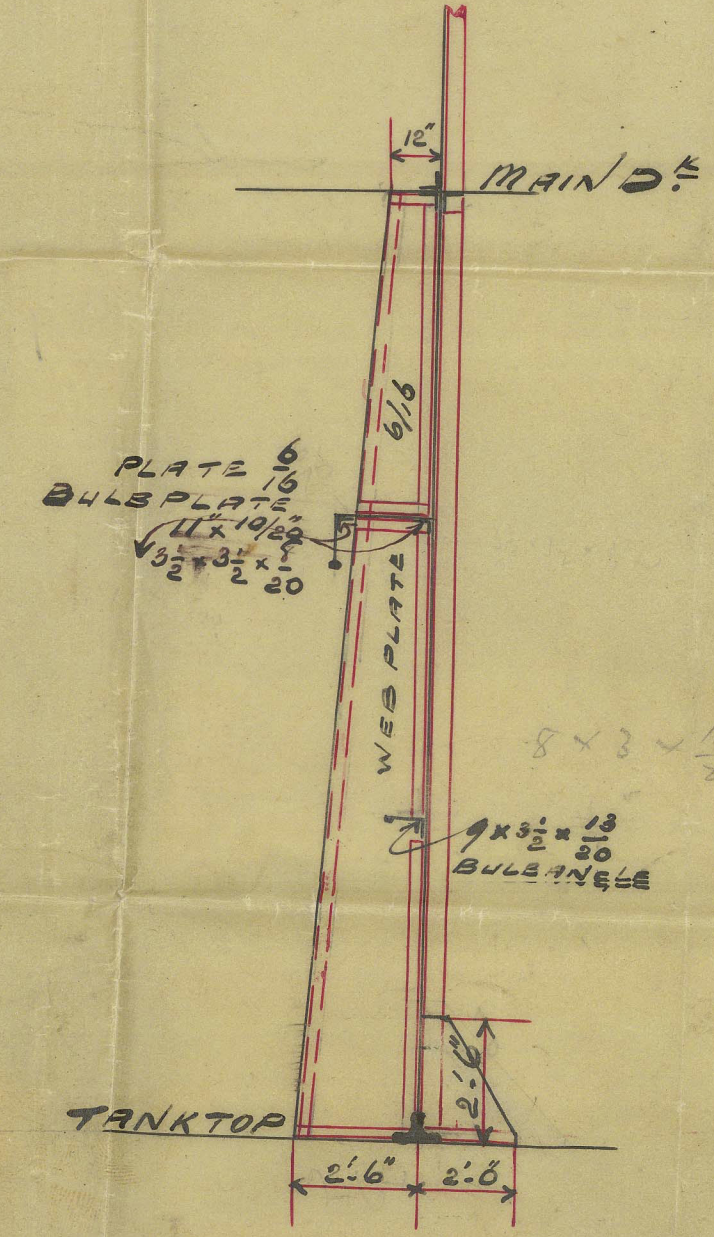


26/9/95

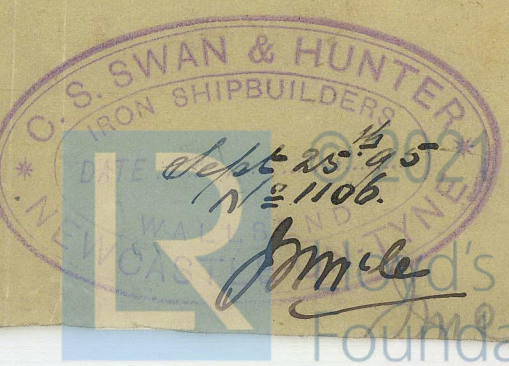

Register  
Foundation



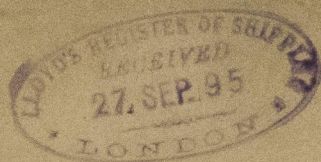

Plan of bulkheads  
No 205

C. S. Swan & Hunter  
SS Neptune No 33571

NWC847-0053



© 2021

Lloyd's Register  
Foundation