

Lloyd's Register of British and Foreign Shipping.

(Report on Vessel No. _____ Port **NEWCASTLE-ON-TYNE**)No. **3081**

SHIP FORGINGS OR CASTINGS.

I have to report that the undermentioned Iron ~~or Steel~~ Forgings ~~or Castings~~,
 manufactured by **The Palmers S & S Co**

of **Jarrow** for the Vessel No. **206**, being built
 by **Messrs Swan & Hunter** of **Wallsend**

have been inspected by me as set forth below, and found to be, so far as can be seen,
sound


Mark on Forgings.

Lloyd's

No. **4888B****JB****John C Craig****Newcastle**

	STERN FRAME.	RUDDER FRAME.	STEM.
Material*	Scrap Iron	Scrap Iron	Scrap Iron
How made	Forged	Forged	Forged
Dimensions	11-6	9-4 1/2	10 1/2-2 3/4
Progress on Inspection	Forged & Smithed	Forged & Smithed	Smithed
Date when Inspected	September 24 Oct 11-15-17-22 Nov 1/95	December 2-16-23/25 Jan 7-17-29 Feb 6/26	November 1/95

SKETCHES OF FRAMES SHOWING POSITION AND DESCRIPTION OF WELDS OF FORGINGS, OR PARTICULARS OF TESTS APPLIED TO CASTINGS.

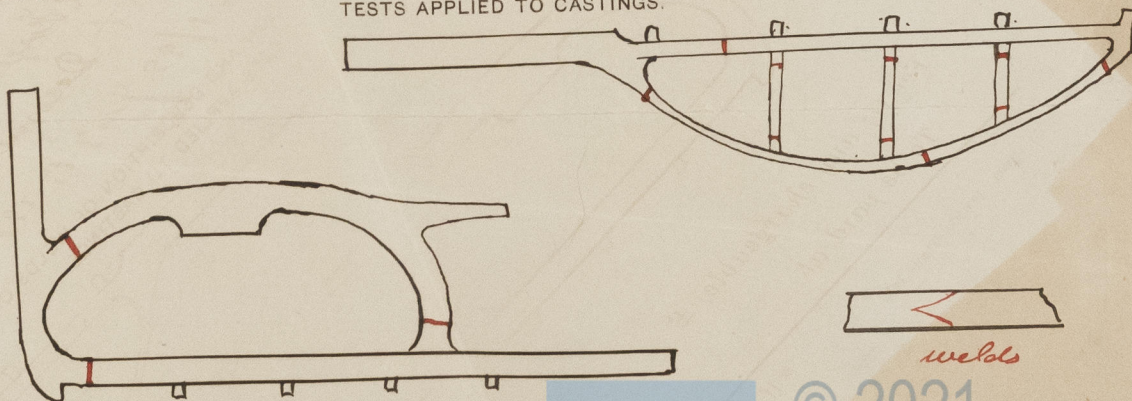

Fee (if any chargeable) £ : :

To be paid at _____

* If of Iron, state whether scrap or puddled Iron.

Dr Hs 205
8/8 Neptune
Dec 10 33571



© 2021

Lloyd's Register
Foundation