



JOHN READHEAD & SONS.
Engineers, Boiler Makers,
Iron & Steel Shipbuilders,
SOUTH SHIELDS.

10:9:96

Nov 2nd 1896
10:9:96

Pumping Arrangement ^{s/s} N^o 318.

TONNAGE
UNDER DE 2343.79

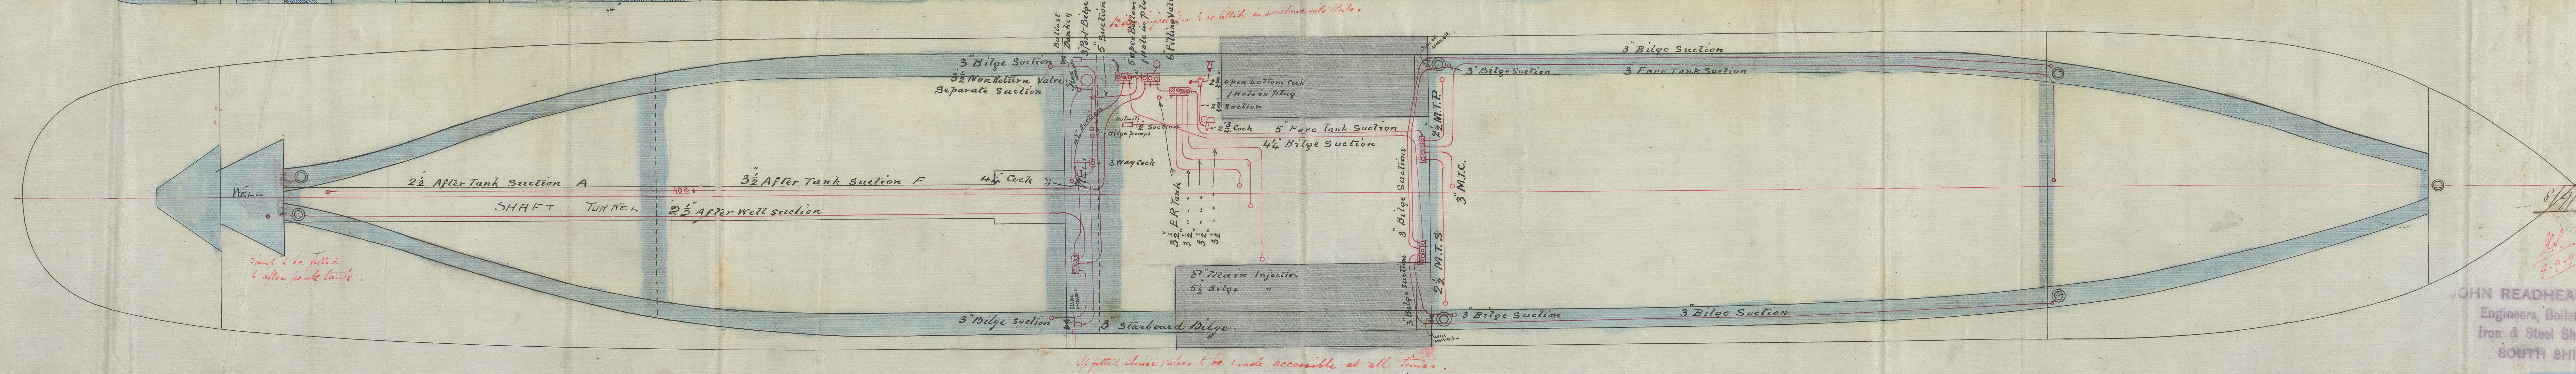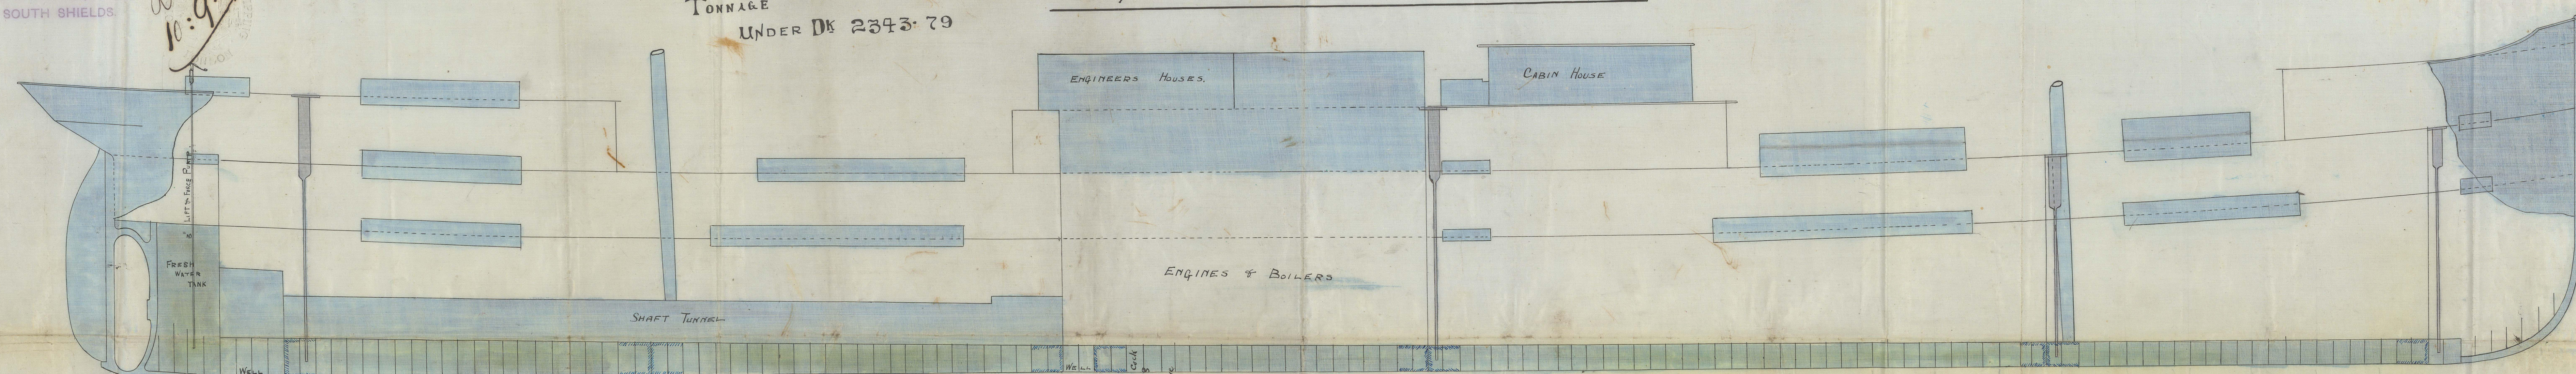

8/10/96
10:9:96
JOHN READHEAD & SONS.
Engineers, Boiler Makers,
Iron & Steel Shipbuilders,
SOUTH SHIELDS.

NW 849-0086

No 318 "Savan"
J. Readhead & Sons
Pumping plant.

Rec. T.E. Rpt No 33961

UNDER NO 5243: 59

IMAGE

© 2021

Lloyd's Register
Foundation