


Cast Steel
Single Plate
Rudder


23.1.96 No 318

JOHN READHEAD & SONS,
ENGINEERS, BOILER MAKERS,
AND
IRON & STEEL SHIP BUILDERS
SOUTH SHIELDS.

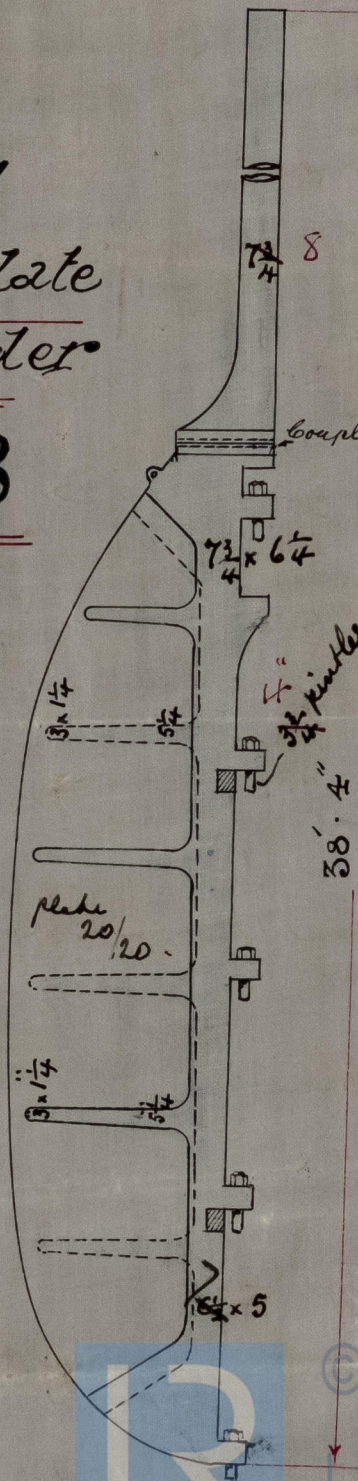

Handwritten notes:
Spec of rudder
to be made
out of cast steel

Handwritten:
J.R.H.
23/1/96

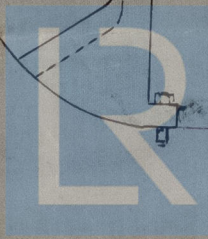

© 2021

Lloyd's Register
Foundation

Mr J Readhead & Co
318
Cast steel rudder frame
of Savan
No 33961



© 2021

Lloyd's Register
Foundation

NWC849-0087