

Lloyd's Register of British and Foreign Shipping.

(Report on Vessel No. 33961 Port NEWCASTLE-ON-TYNE)

No. 3080 SHIP FORGINGS OR CASTINGS.

The words FORGINGS or CASTINGS, IRON or STEEL, should be struck out as may be required.

I have to report that the undermentioned Iron ~~or Steel~~ Forgings ~~or Castings~~,
 manufactured by Messrs J March & Co
 of Dunston for the Vessel No. 318, being built
 by Messrs J Readhead & Sons of South Shields
 have been inspected by me as set forth below, and found to be, so far as can be seen,
sound



Mark on Forgings.

Lloyd's
 No. 5253A
86

John B Craig
Newcastle

| | STERN FRAME. | RUDDER FRAME. | STEM. |
|------------------------|---|---------------|----------------------|
| Material* | <u>Scrap Iron</u> | / | <u>Scrap Iron</u> |
| How made | <u>Forged</u> | | <u>Forged</u> |
| Dimensions | <u>10 - 5 1/2</u> | | <u>10 - 2 1/2</u> |
| Progress on Inspection | <u>Forged & Smelted</u> | | <u>Smelted</u> |
| Date when Inspected | <u>January 13-22-24-31</u> <u>February 11-20-27/96</u> | | <u>January 13/96</u> |

SKETCHES OF FRAMES SHOWING POSITION AND DESCRIPTION OF WELDS OF FORGINGS, OR PARTICULARS OF TESTS APPLIED TO CASTINGS.

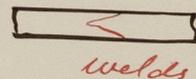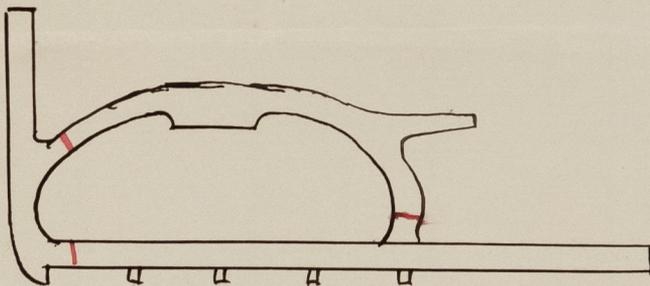

Fee (if any chargeable) £ : :

To be paid at



© 2021

Lloyd's Register
 Foundation

* If of Iron, state whether scrap or puddled Iron.