


S. S. Cornwall N^o 339.

4 No: 340 app
19/2/9


TO CLASS 100A1 AT LLOYD'S THREE DK RULE

420'-0" x 54'-0" x 32'-0" MLD

— SCALE $\frac{1}{2}$ IN. = 1 FT. —

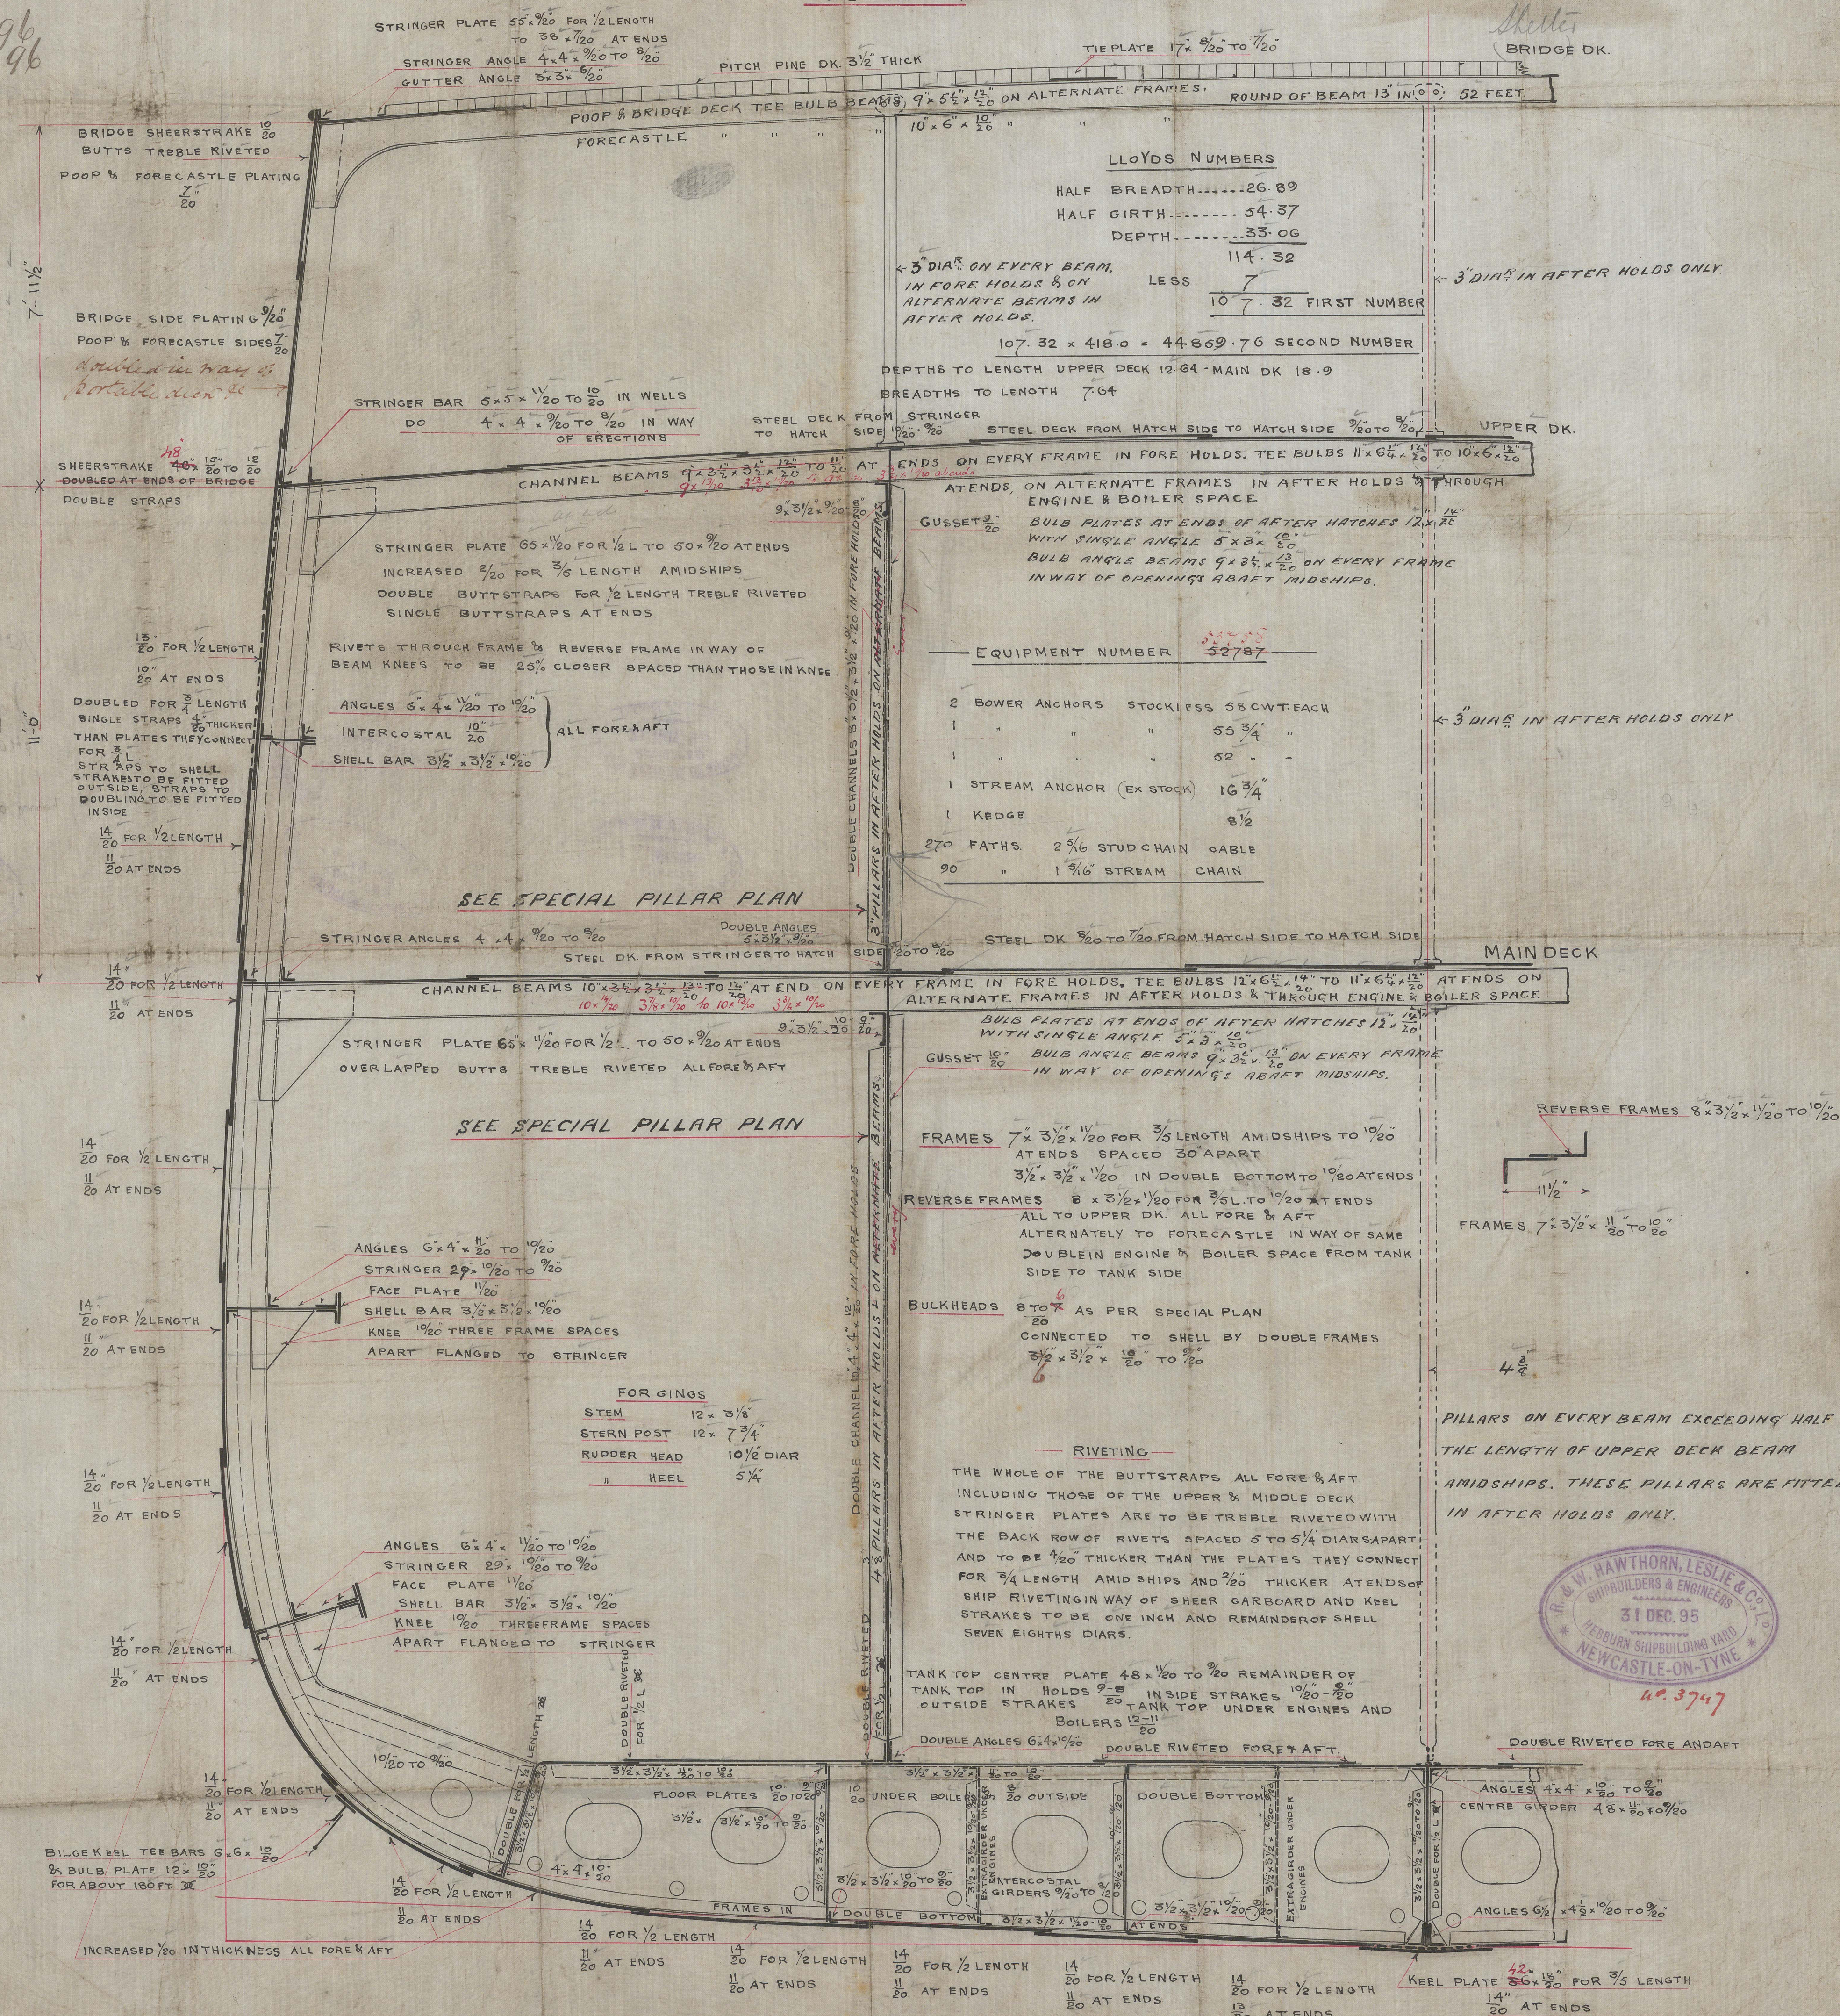

NOTE. SHELL PLATING WHOLLY WITHIN DOUBLE BOTTOM (EXCEPT KEEL & GARBOARD STRAKES) DOUBLED FOR $\frac{1}{2}$ LENGTH WHERE $\frac{11}{20}$ AND ABOVE TO BE REDUCED $\frac{1}{20}$ IN THICKNESS



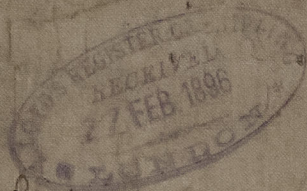


Hawthornside St. Dun,
SS N. 339.

Murphy Rpt N. 34043

Cornwall

Nice 34106

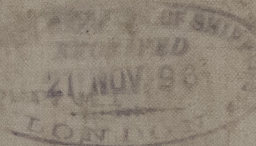 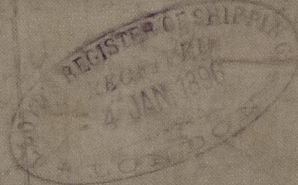

NWC849-0232



© 2021

Lloyd's Register
Foundation