











Y. 1. 96
28. 1. 96
19. 2. 96

S. S. No 339 - 4 No: 340
SCALE 1/4" = 1 FOOT - appd: 19. 2. 96

DETAIL OF PILLARS IN WAY OF HATCHES
SCALE 1/2" = 1 FOOT.

DETAIL OF PILLARS CLEAR OF HATCHES.
SCALE 1/2" = 1 FOOT.

SECTION CLEAR OF PILLARS

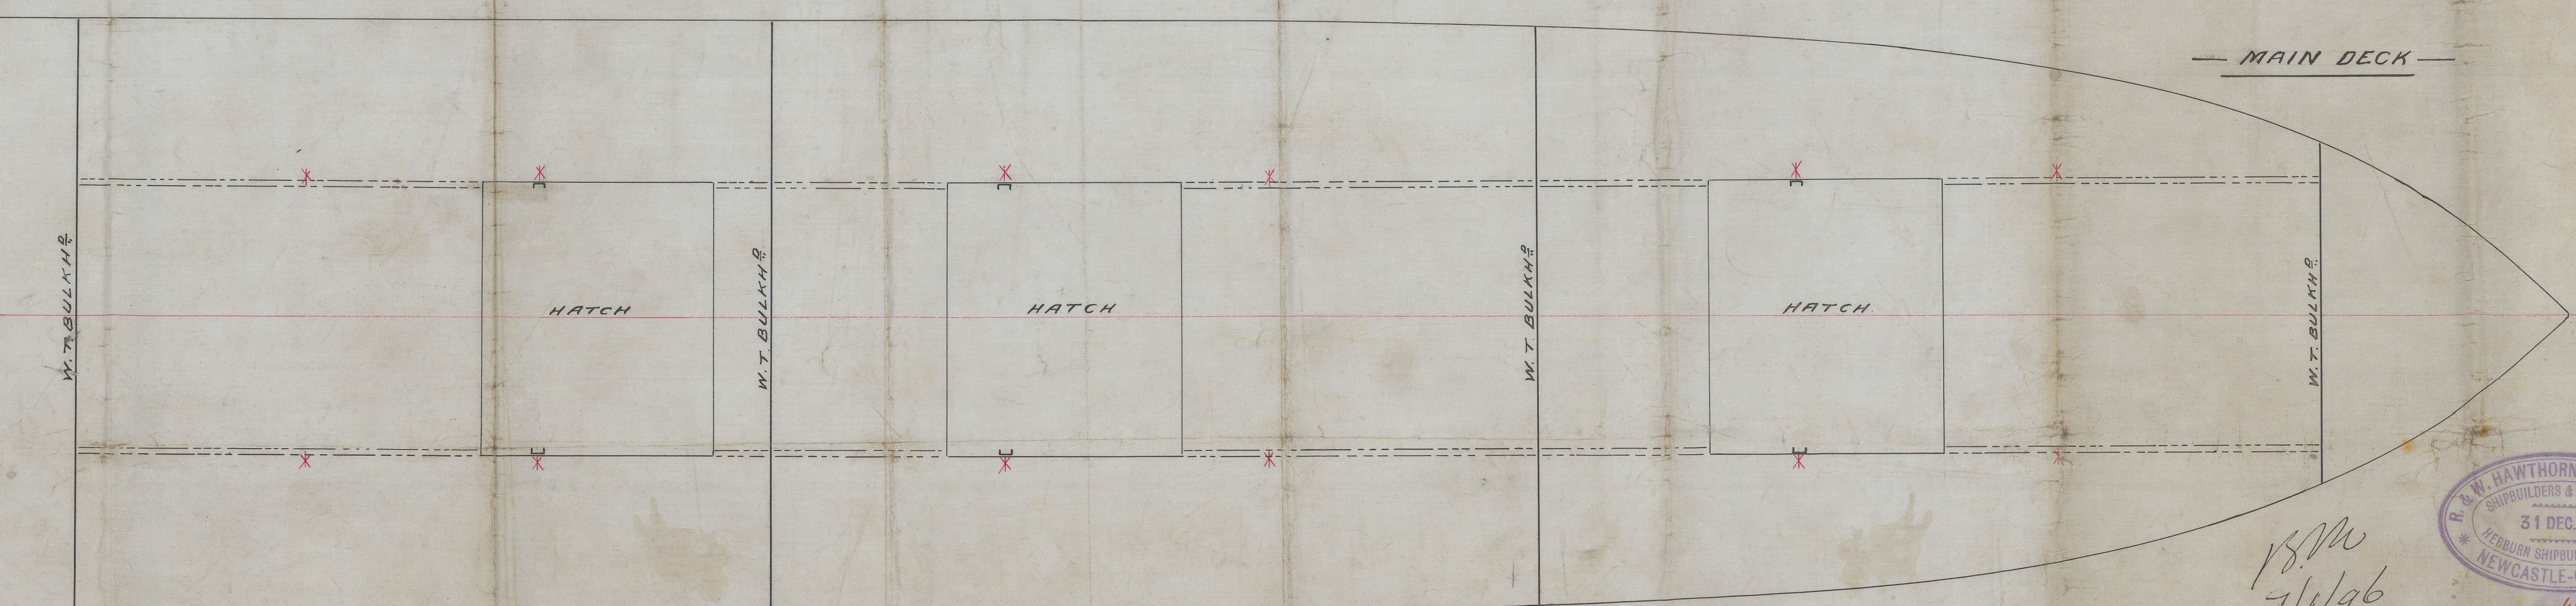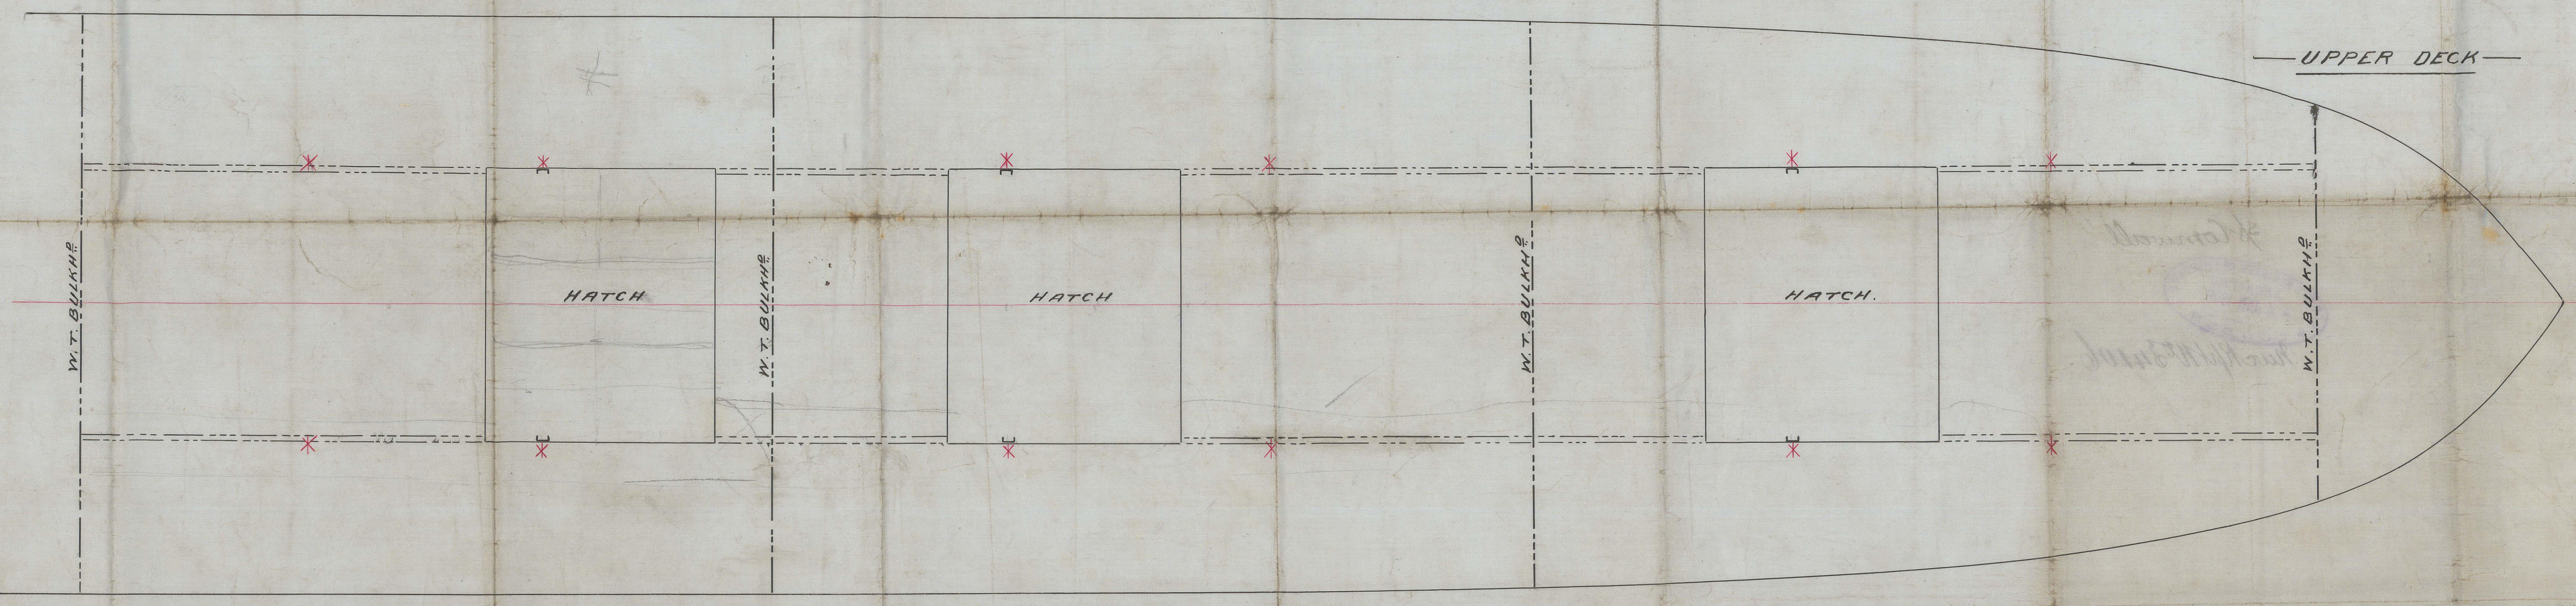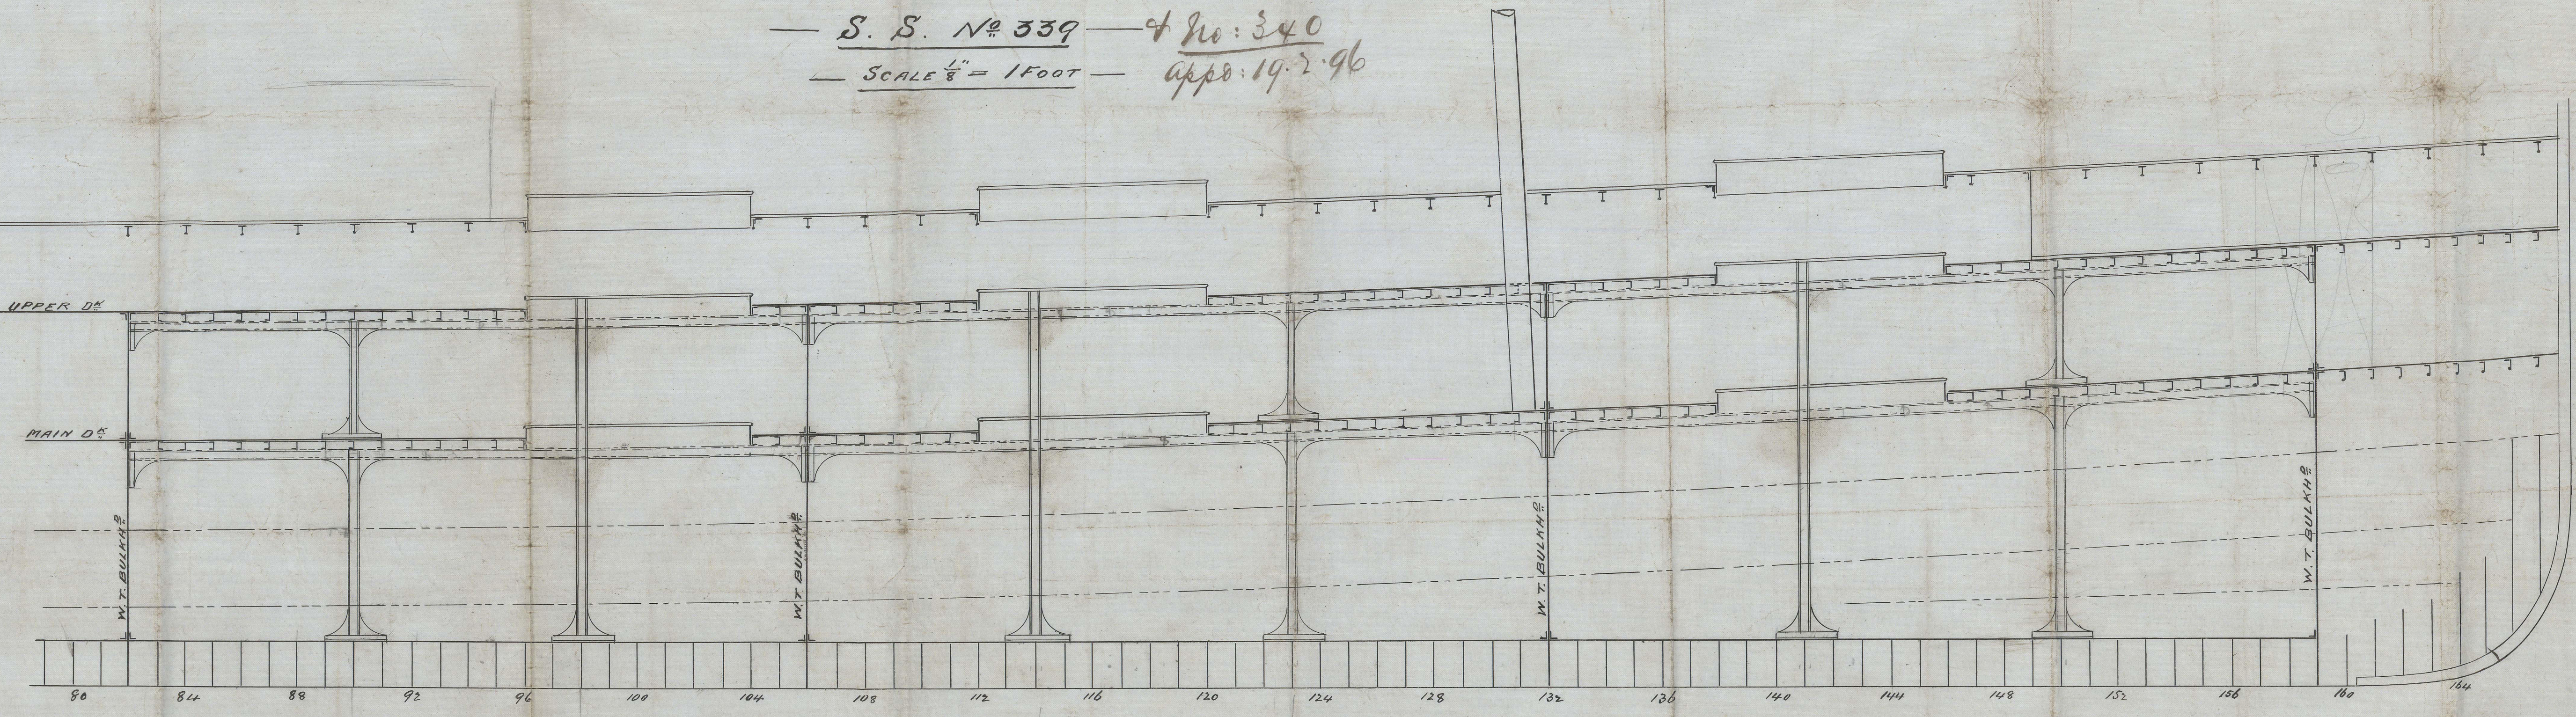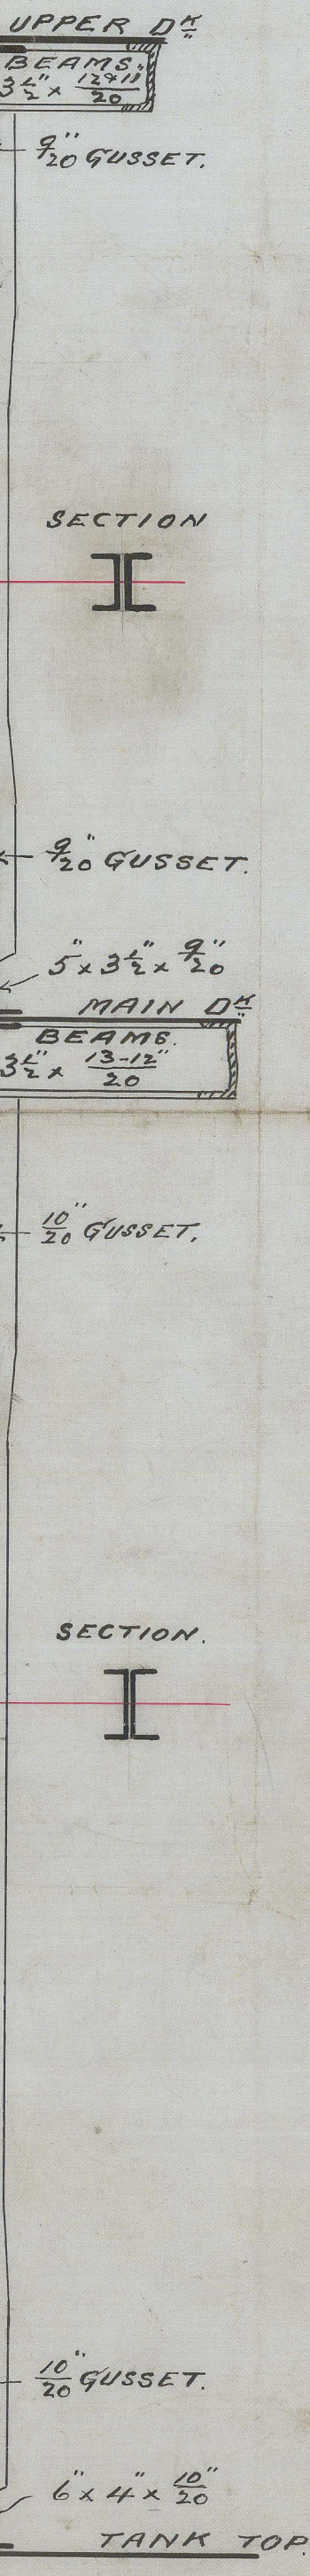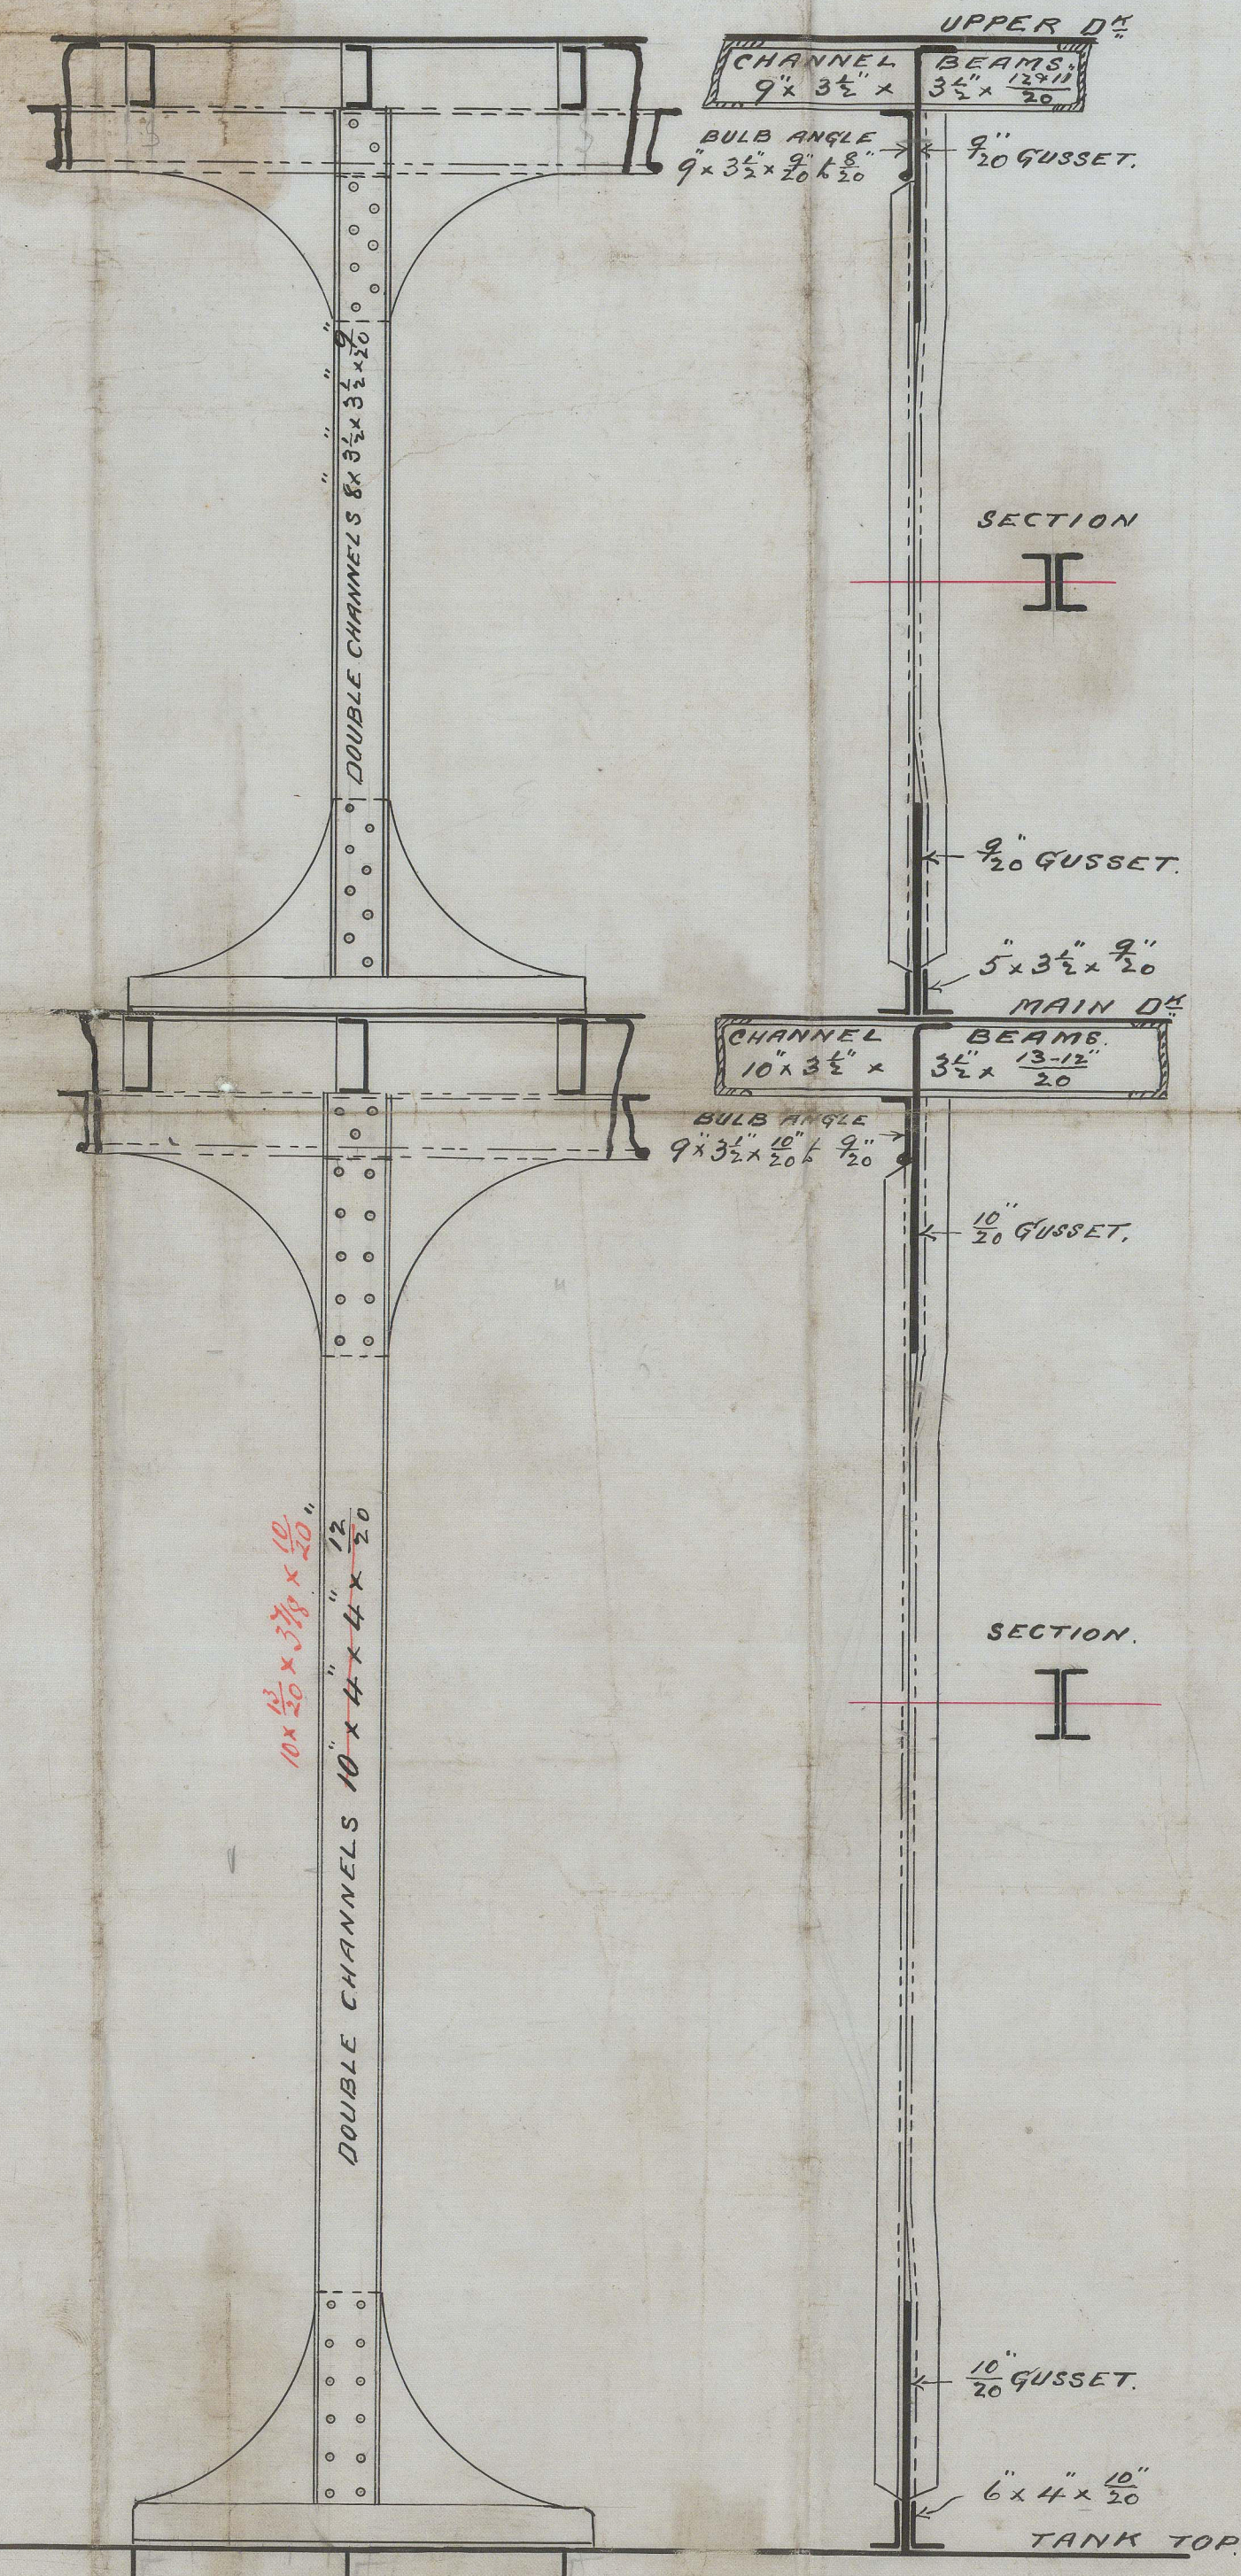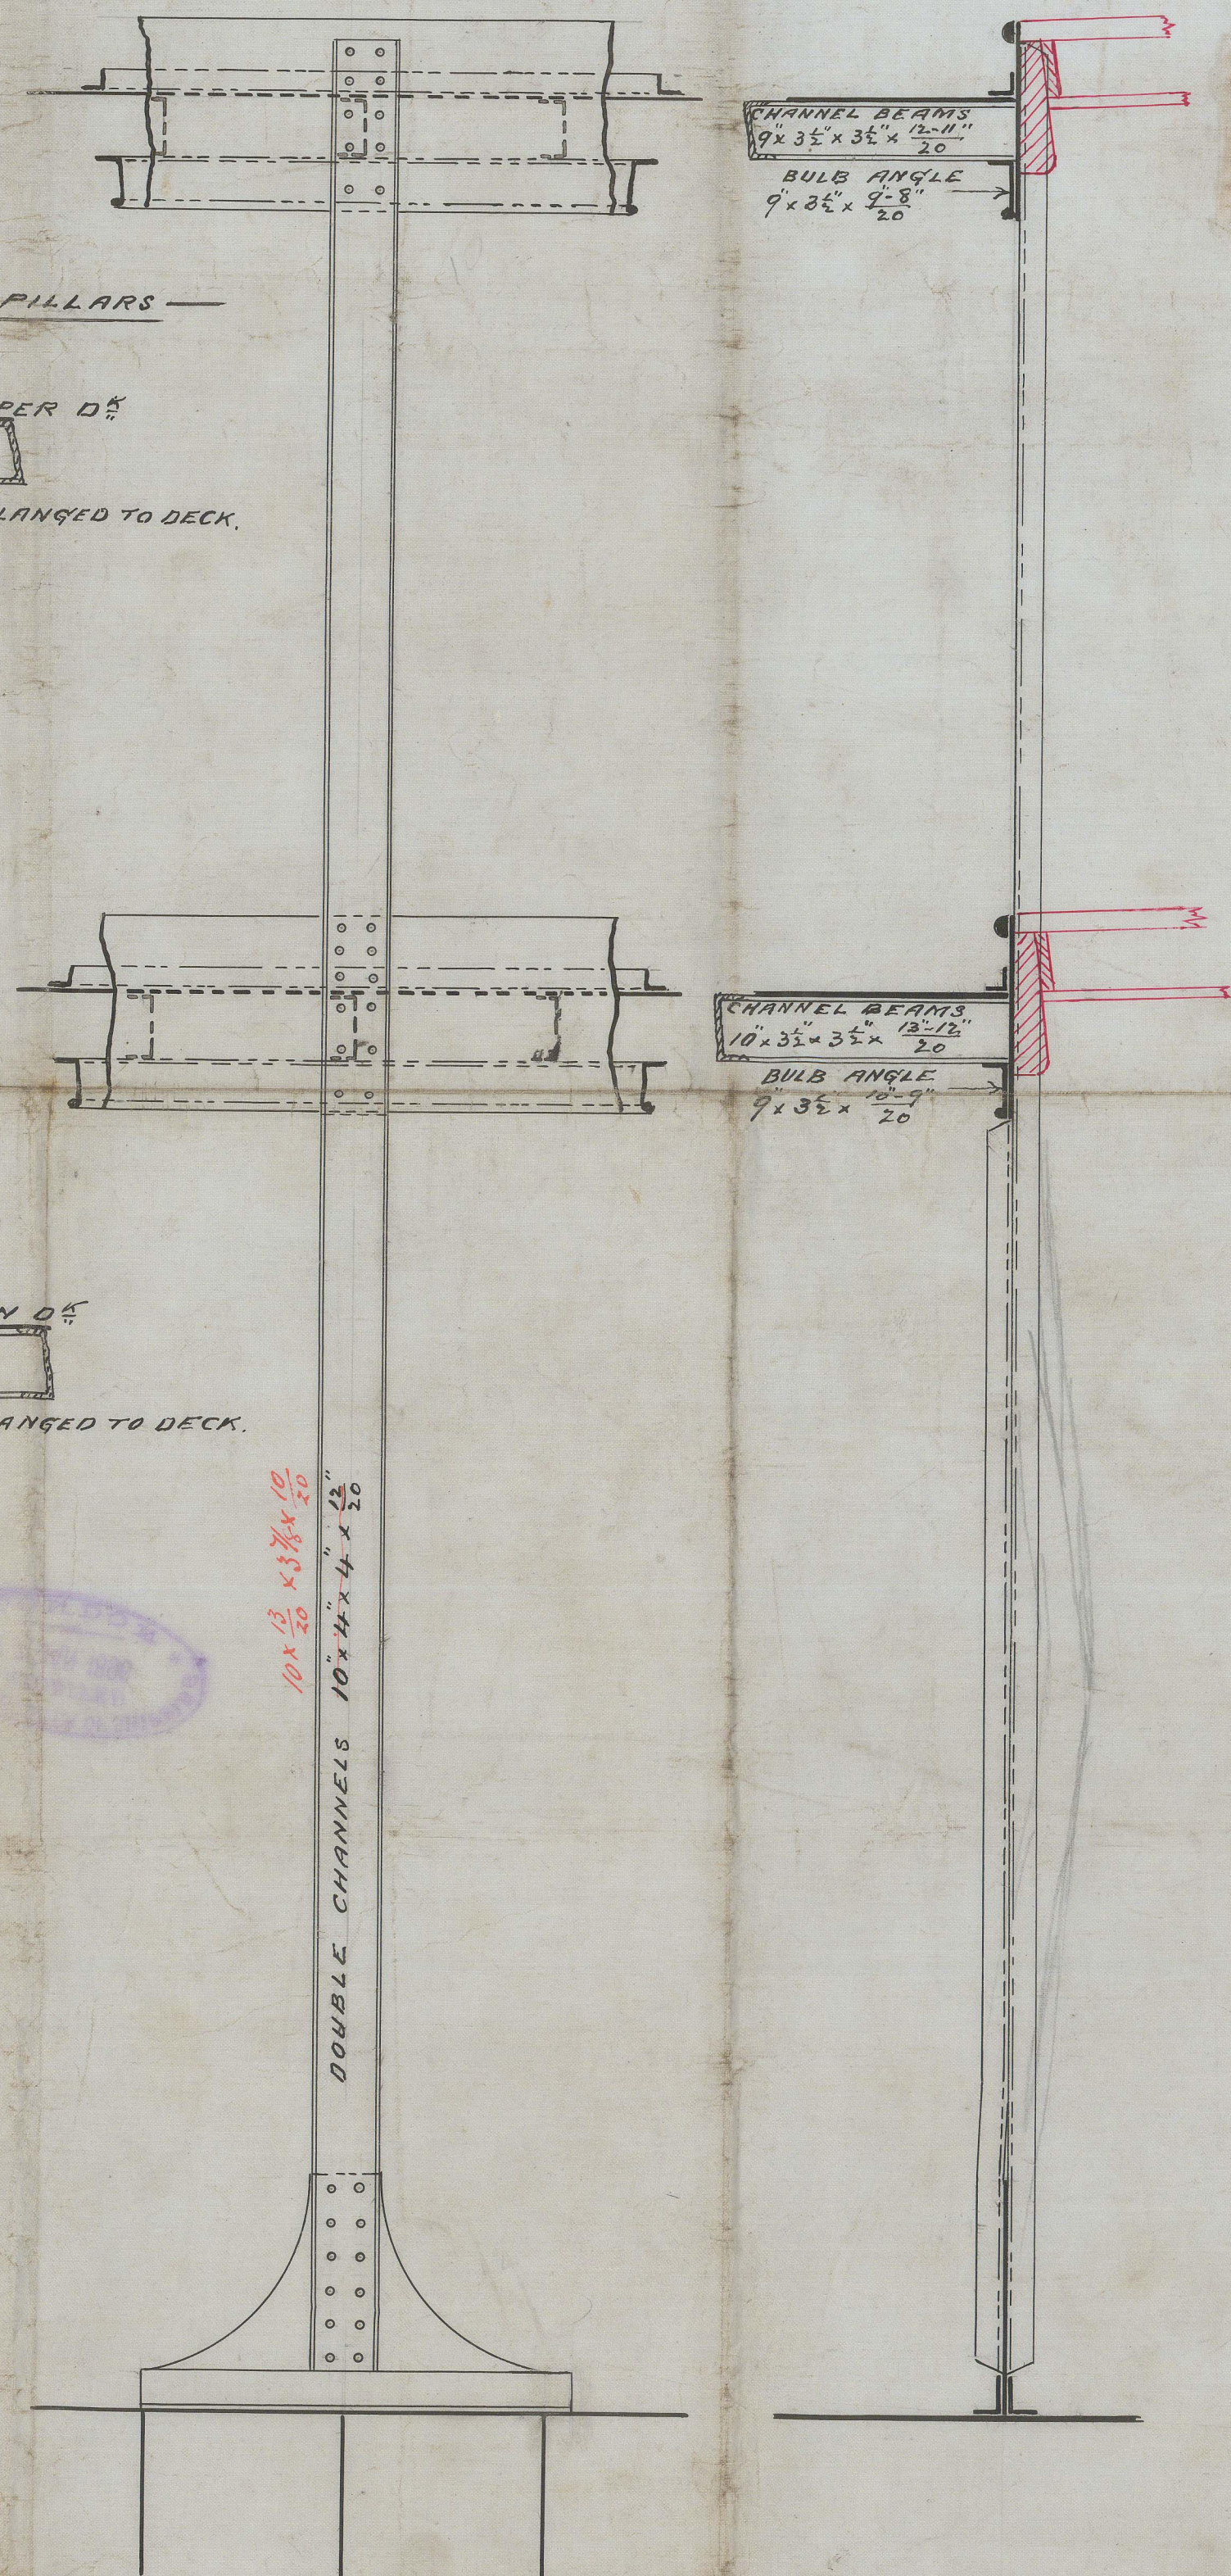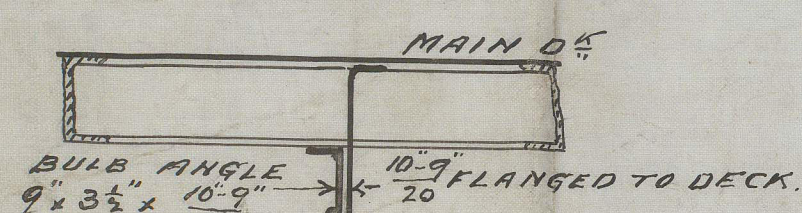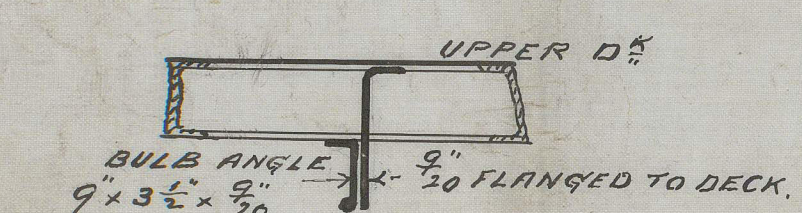


POSITION OF PILLARS INDICATED THUS: X

MAIN DECK

18. 12. 96
7/1/96



St Cornwall

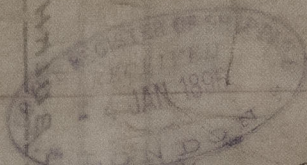

Wreck Rpt No 34106

NW 849-0233


MAIN DECK

CHIMNEY


HATCH

X

X

HATCH

X

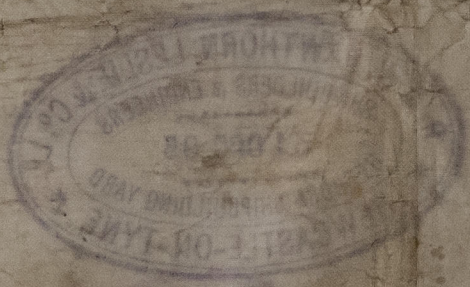

18/1/91




© 2021

Lloyd's Register
Foundation

HATCH


MAIN
BUILT UP
DECK

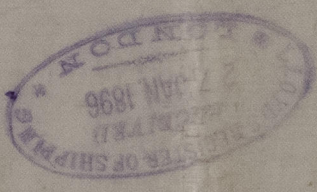

0 1/2
1 1/2
POSITION OF PILLARS INDICATED

DECK

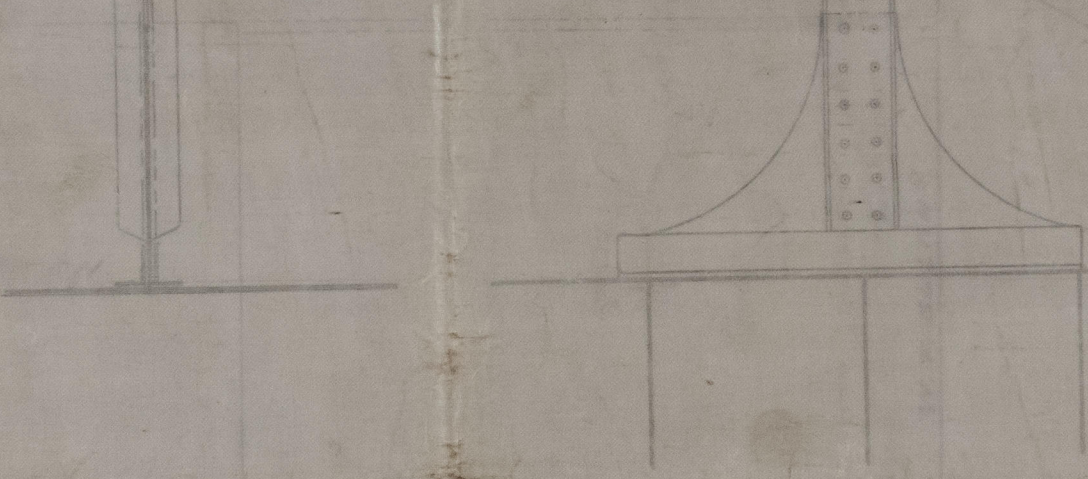

© 2021

Lloyd's Register
Foundation