

- No 339 -



MAIN DECK AMIDSHIPS

28.1.96

	WEB.	FLANGES.
SIZE AS APPROVED	10" x $\frac{13}{20}$ "	3 $\frac{1}{2}$ " x $\frac{13}{20}$ "
MILL SIZE	10" x $\frac{14}{20}$ "	3 $\frac{7}{8}$ " x $\frac{10}{20}$ "

LOWER HOLD PILLARS

	WEB.	FLANGES.
SIZE AS APPROVED	10" x $\frac{12}{20}$ "	4" x $\frac{12}{20}$ "
MILL SIZE	10" x $\frac{13}{20}$ "	3 $\frac{7}{8}$ " x $\frac{10}{20}$ "

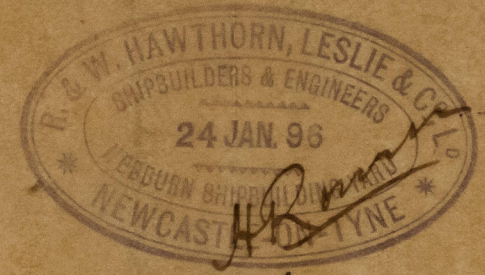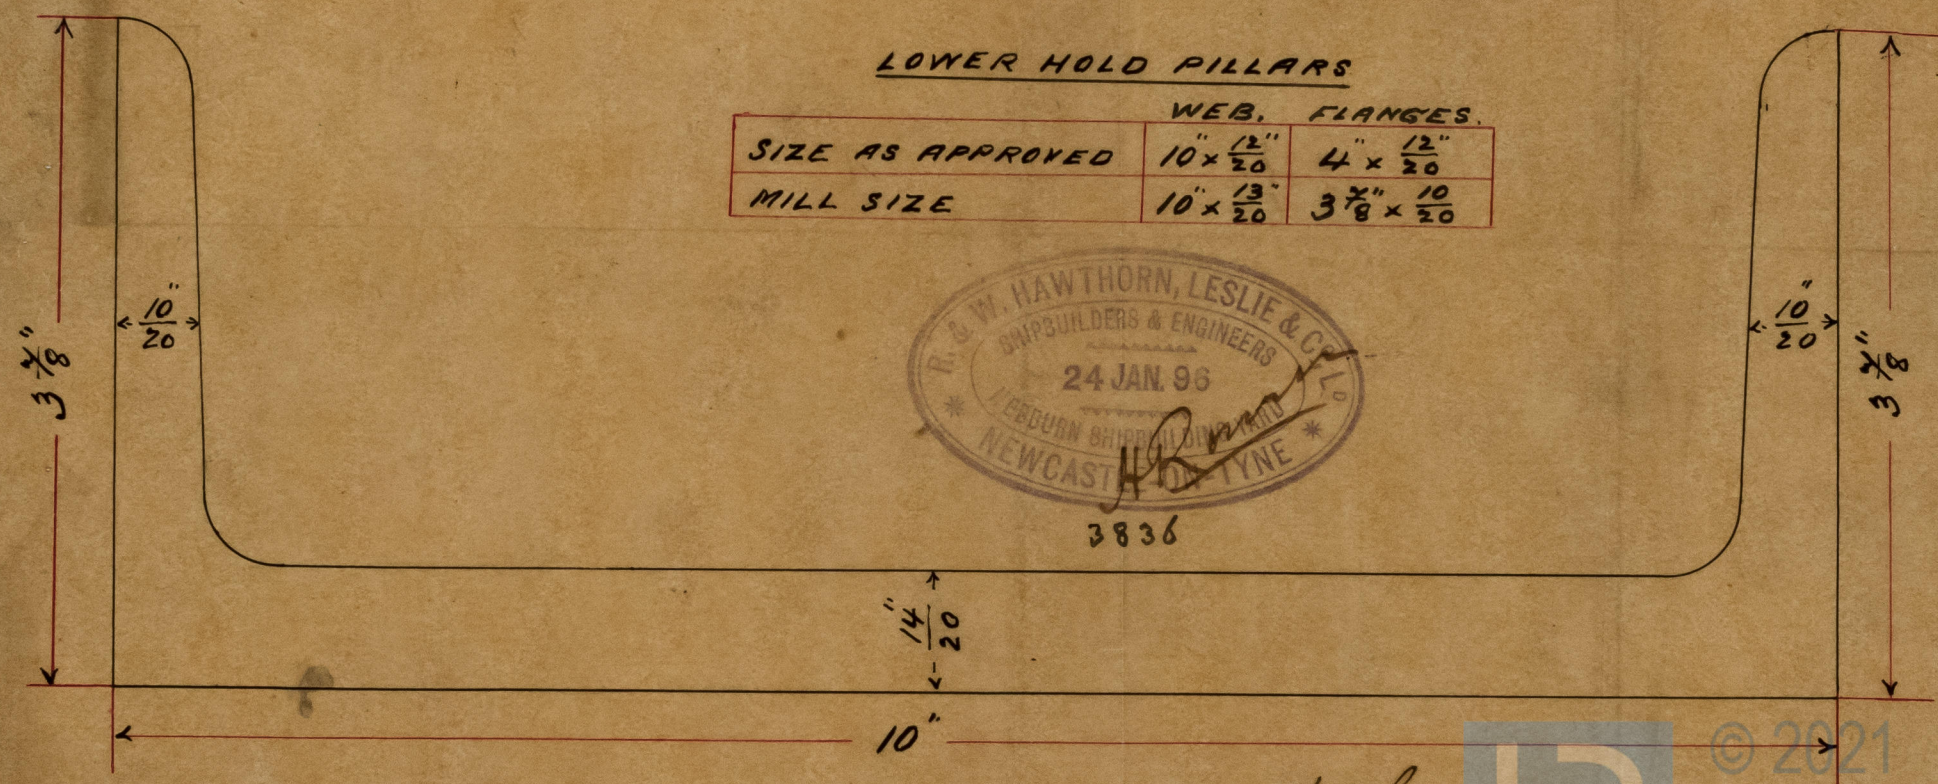

28/1/96



© 2021
Lloyd's Register
Foundation

4250-4483W

NWC849-0234