


UPPER DECK AT ENDS


- No 339 -

	WEB	FLANGES
SIZE AS APPROVED	$9 \times \frac{11}{20}$	$3\frac{1}{2} \times \frac{11}{20}$
MILL SIZE	$9 \times \frac{11}{20}$	$3\frac{3}{4} \times \frac{10}{20}$

28.1.96

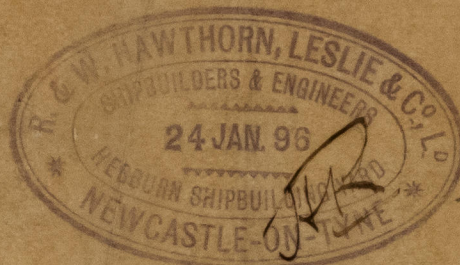

3836.

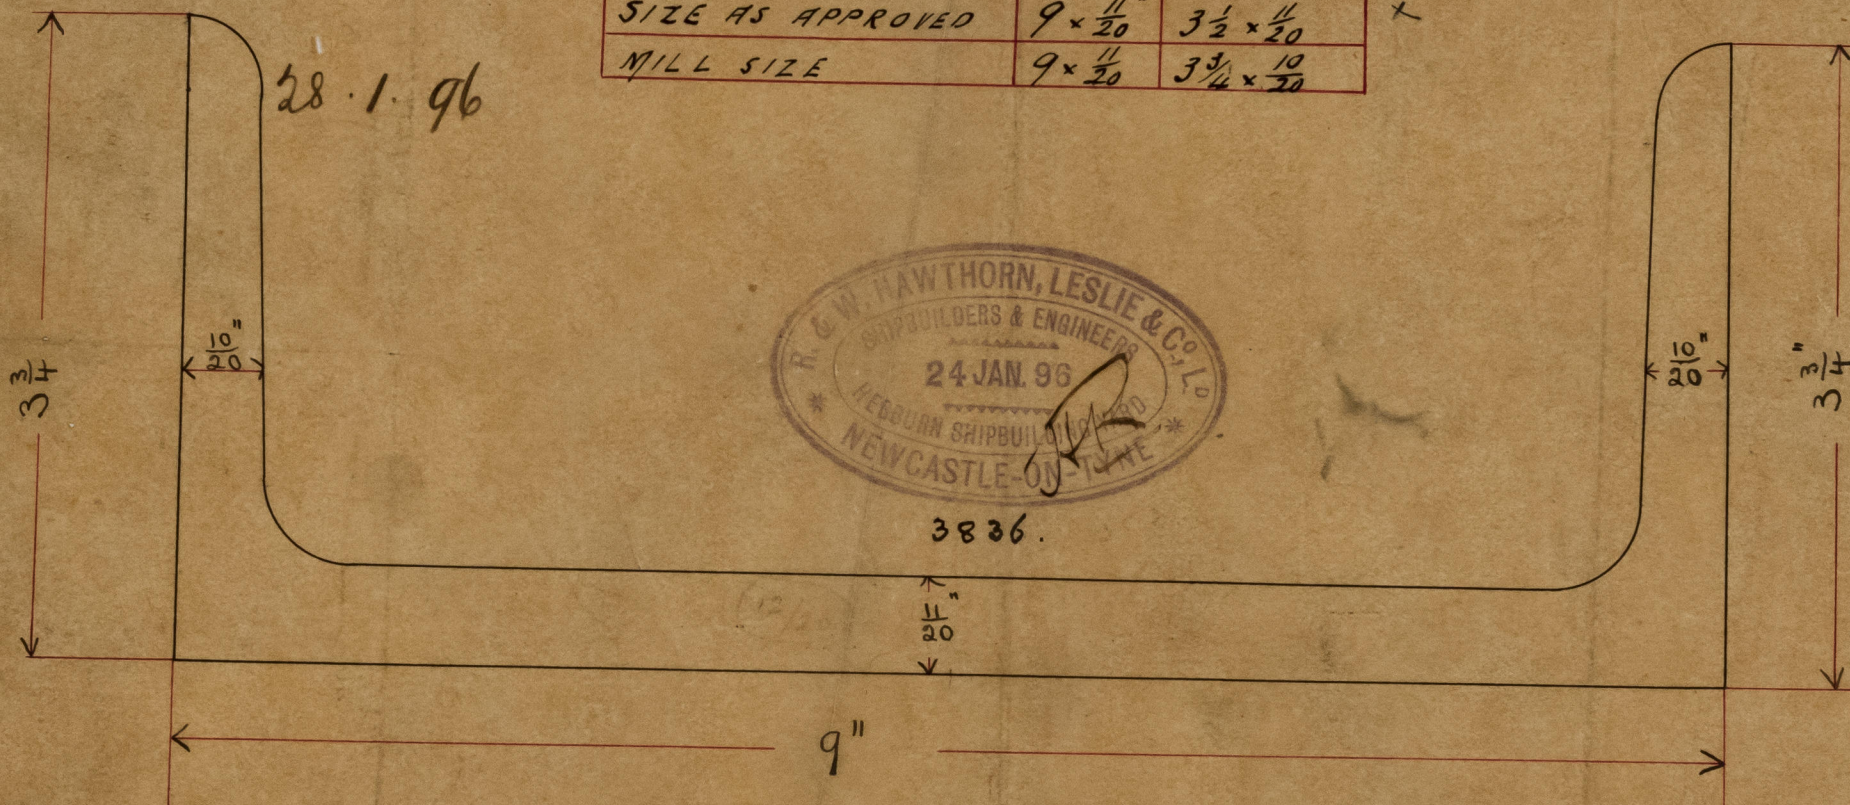

NWC 847-0237

F250-P483WH

28.1.96



© 2021

Lloyd's Register
Foundation