

# Lloyd's Register of British and Foreign Shipping.

(Report on Vessel No. \_\_\_\_\_ Port NEWCASTLE-ON-TYNE)

No. 3464 SHIP FORGINGS OR CASTINGS.

I have to report that the undermentioned Iron or ~~Steel~~ Forgings or ~~Castings~~,  
 manufactured by Messrs Hawthorn Leslie & Co  
 of Hebburn for the Vessel No. 218, being built  
 by Messrs Swan & Hunter of Wallsend  
 have been inspected by me as set forth below, and found to be, so far as can be seen,  
Sound

The words FORGINGS or CASTINGS, IRON or STEEL, should be struck out as may be required.


Mark on Forgings.

Lloyd's  
 No. 5817B  
*JG*

*John B Craig*  
 Newcastle  
 18. 1. 97

	STERN FRAME.	RUDDER FRAME.	STEM.
Material* ... ..	<u>Scrap Iron</u>	<u>Scrap Iron</u>	
How made ... ..	<u>Forged</u>	<u>Forged</u>	
Dimensions ... ..	<u>11-6</u>	<u>9-4 1/2</u>	
Progress on Inspection	<u>Forged &amp; Smithed</u>	<u>Forged &amp; Smithed</u>	<u>not seen</u>
Date when Inspected	<u>August 8 to October 9/86</u>	<u>November 4 to December 29/86</u>	

SKETCHES OF FRAMES SHOWING POSITION AND DESCRIPTION OF WELDS OF FORGINGS, OR PARTICULARS OF TESTS APPLIED TO CASTINGS.

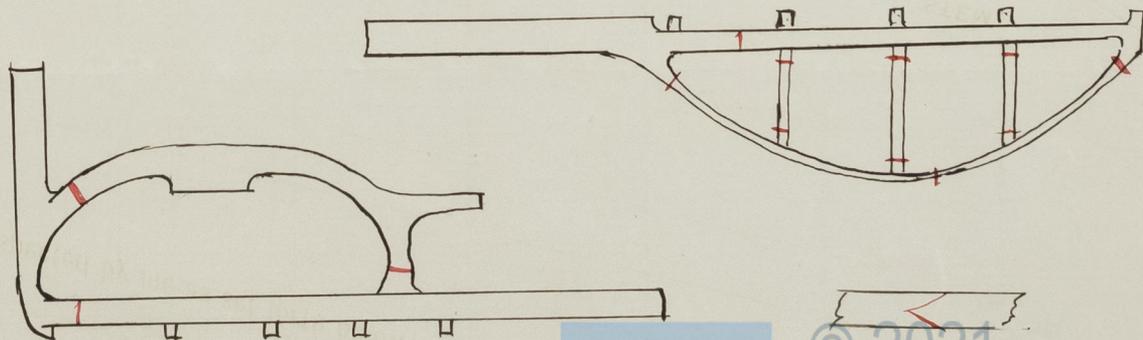

Fee (if any chargeable) £ : :

To be paid at



Lloyd's Register  
 Foundation

\* If of Iron, state whether scrap or puddled Iron.

C. S. Swan & Hunter

sts 218.

of Ashanti

NWC 76. Rpt N<sup>o</sup> 34703



© 2021

Lloyd's Register  
Foundation