



27.7 d

S.S 218

SKETCH SHEWING ATTACHMENT OF REVERSE TO TANK KNEE,


& TANK KNEE TO TANK SIDE.

SCALE  $1\frac{1}{2}" = 1 \text{ FOOT}$

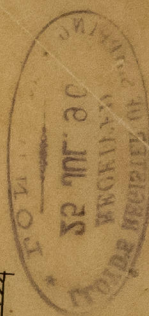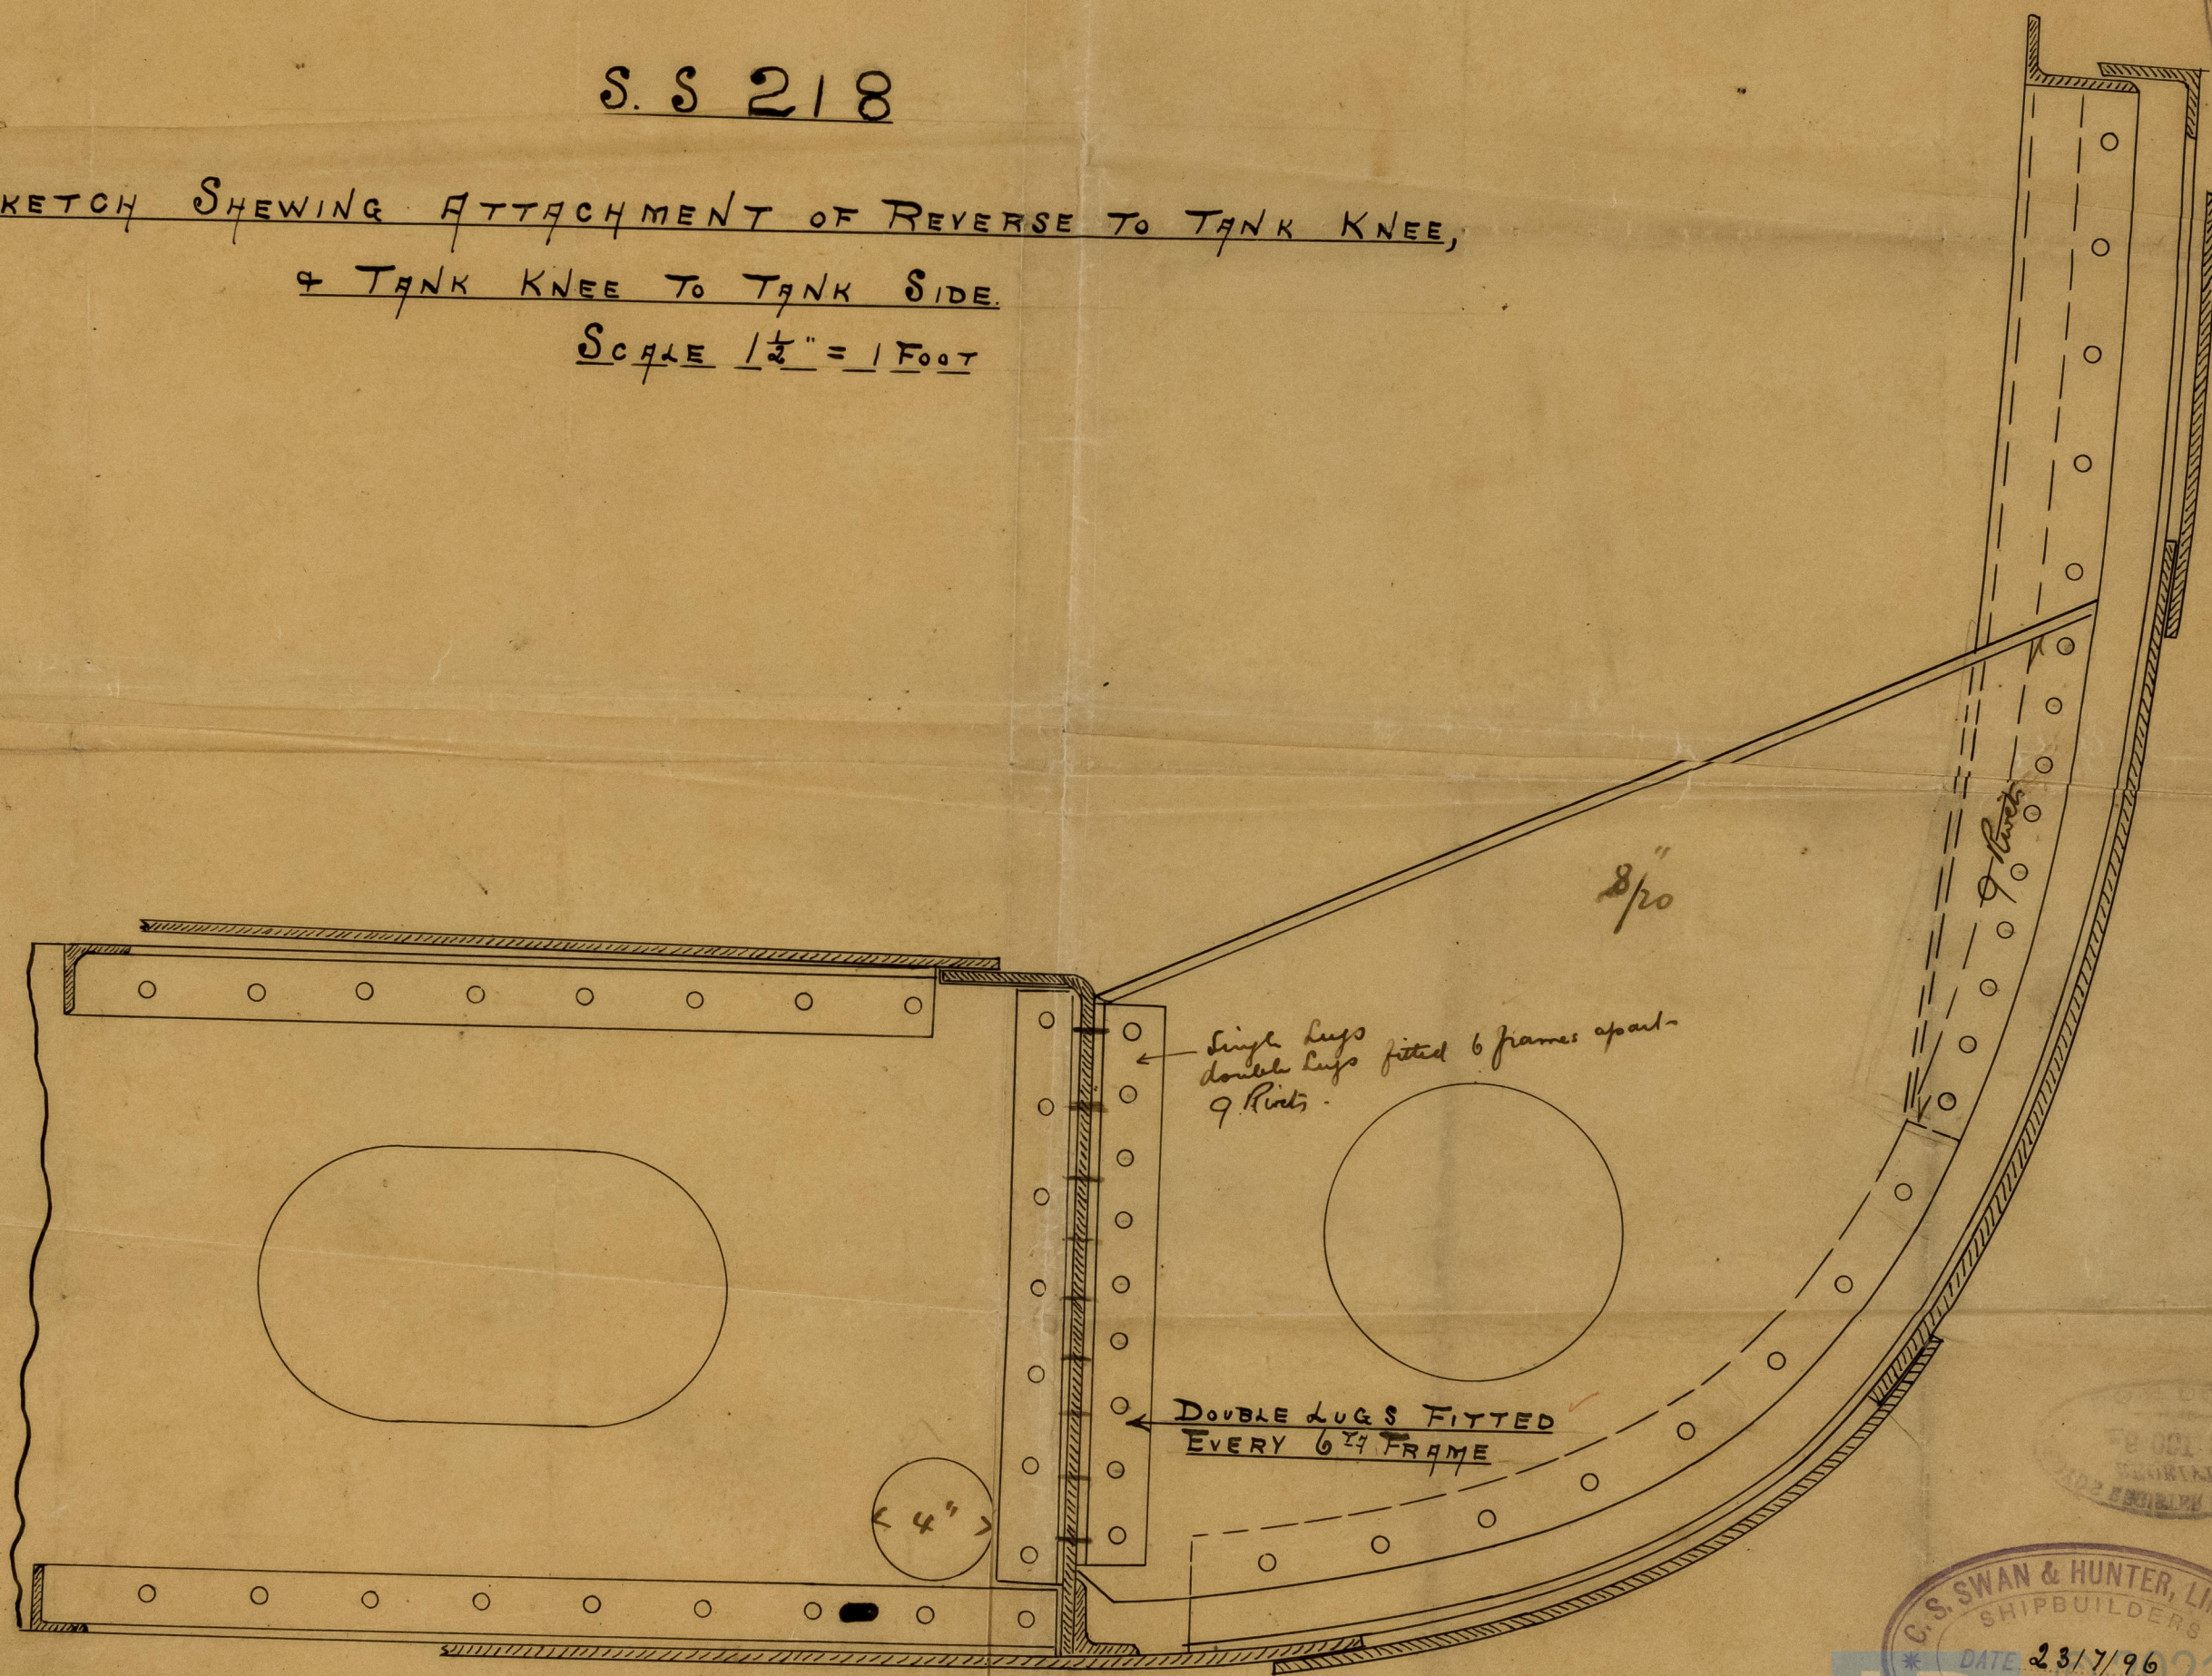

NWC821-0128

J.H.  
25/7/96



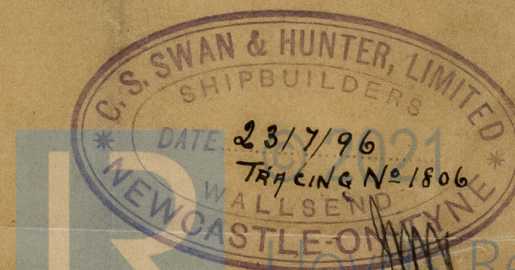


NWC851-0159

Lloyds Register  
Foundation



52/180  
94/8

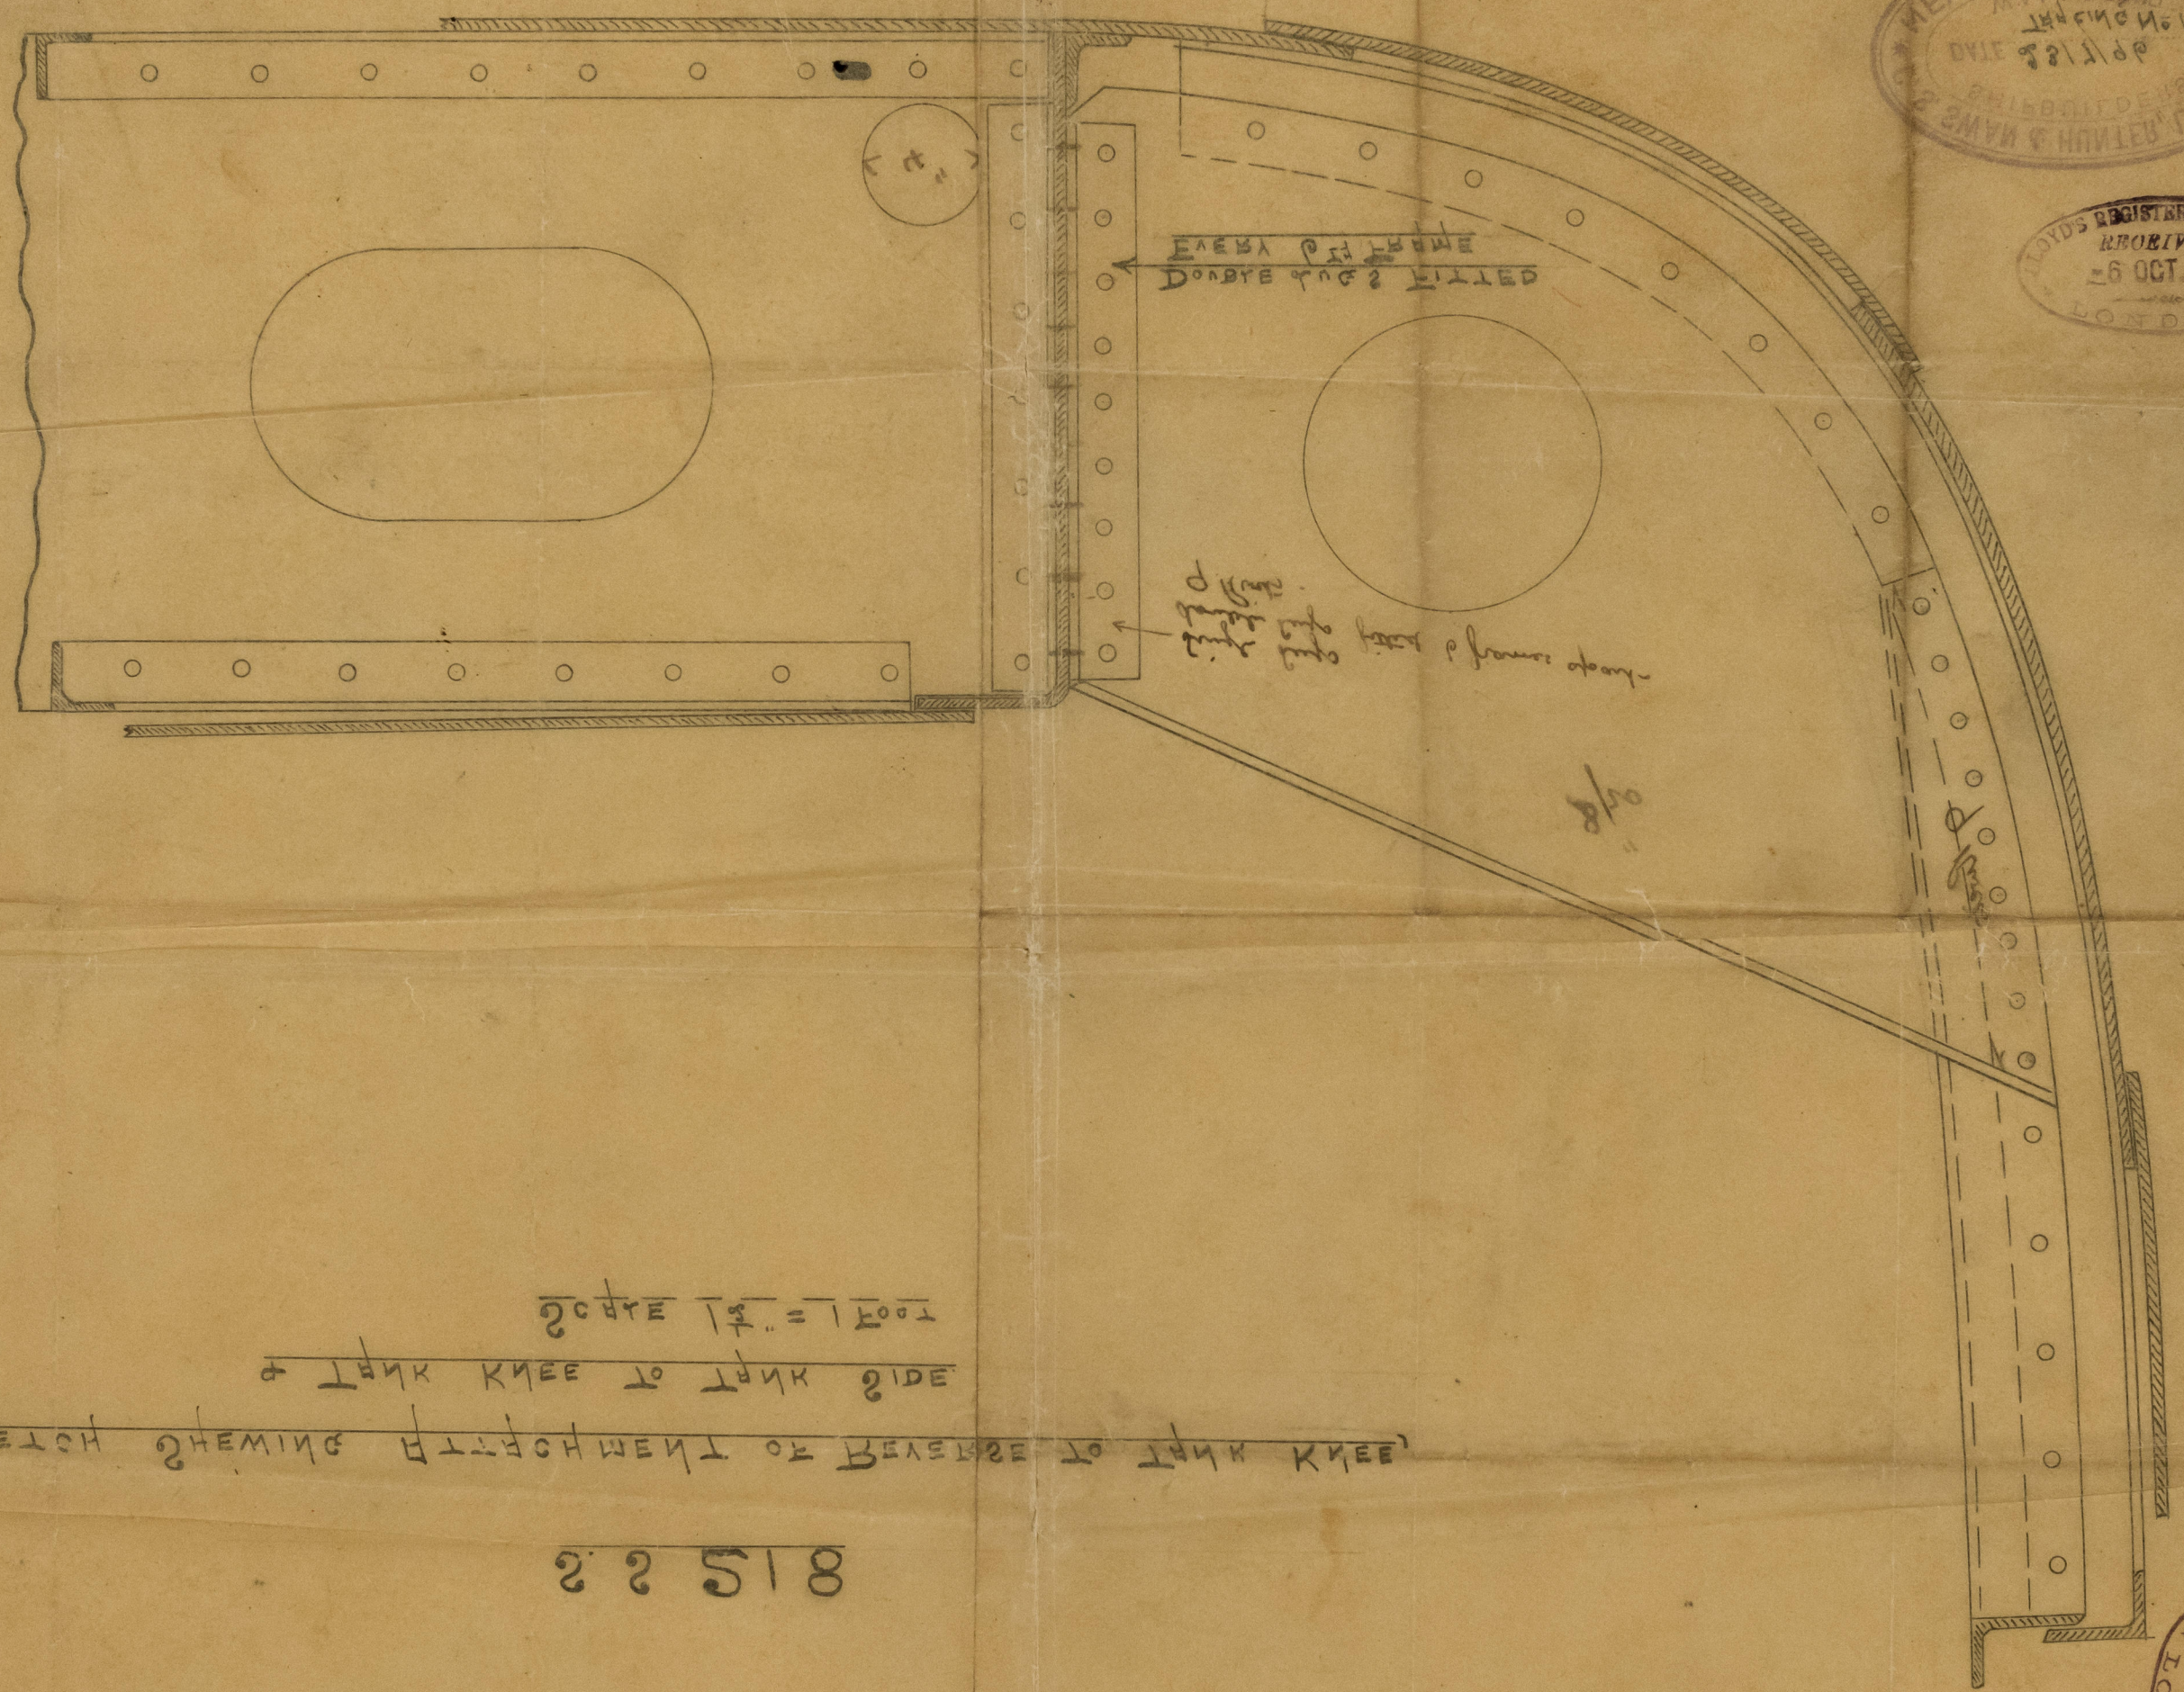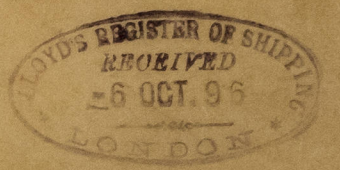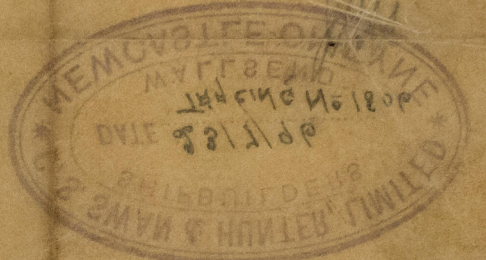


Sketch showing attachment of Reverse to Tank Knee  
 & Tank Knee to Tank Side  
 2nd 1/2" = 1 foot

22518

52.2.4

6510-1587MN

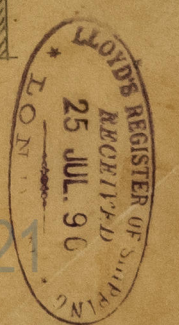

© 2021 Lloyd's Register Foundation