
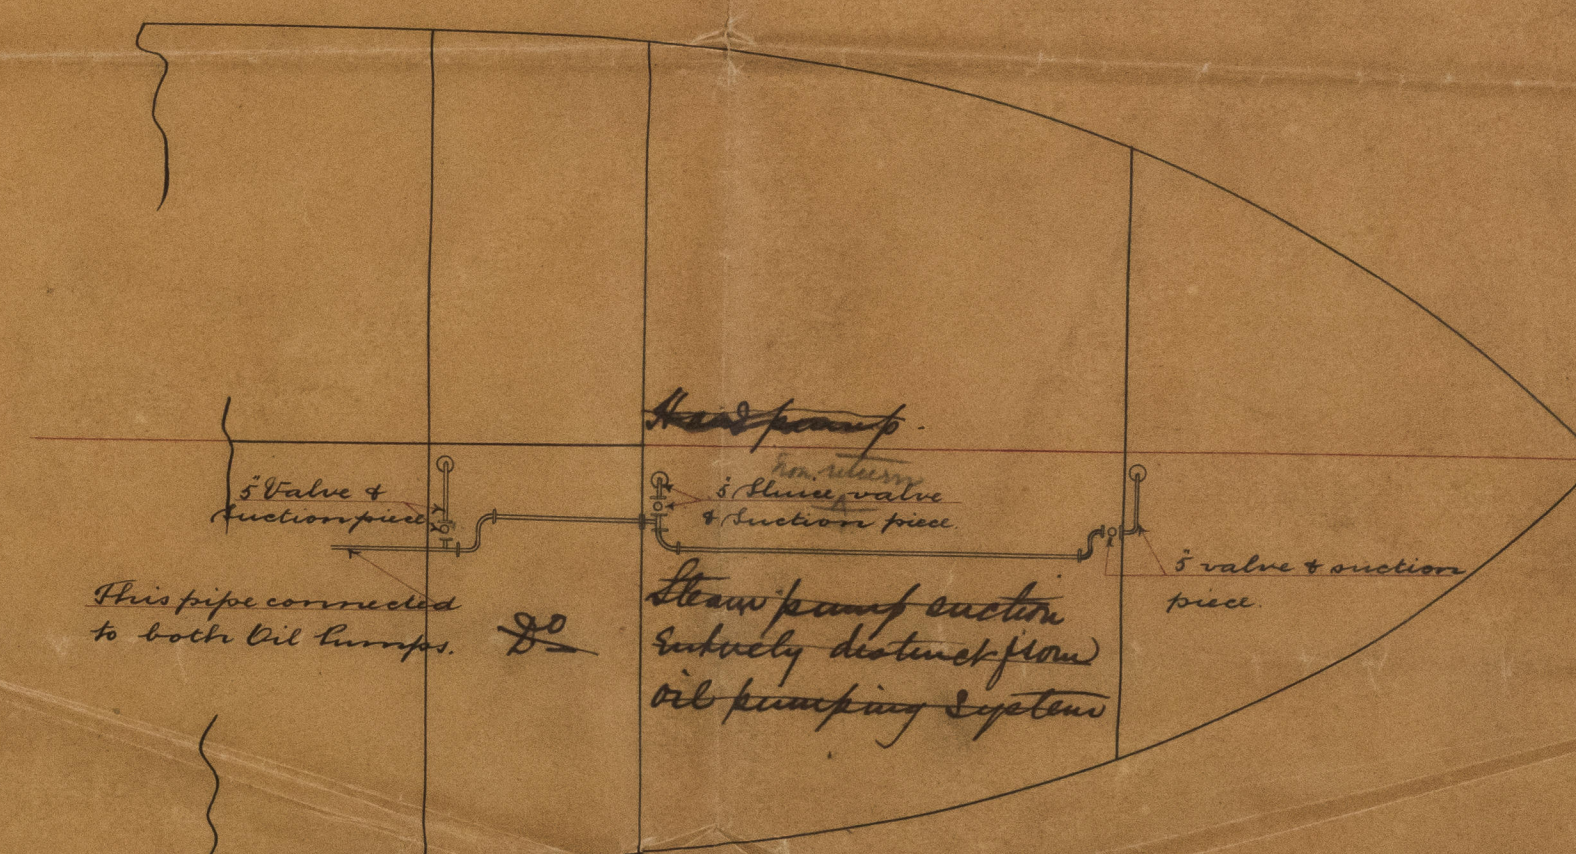
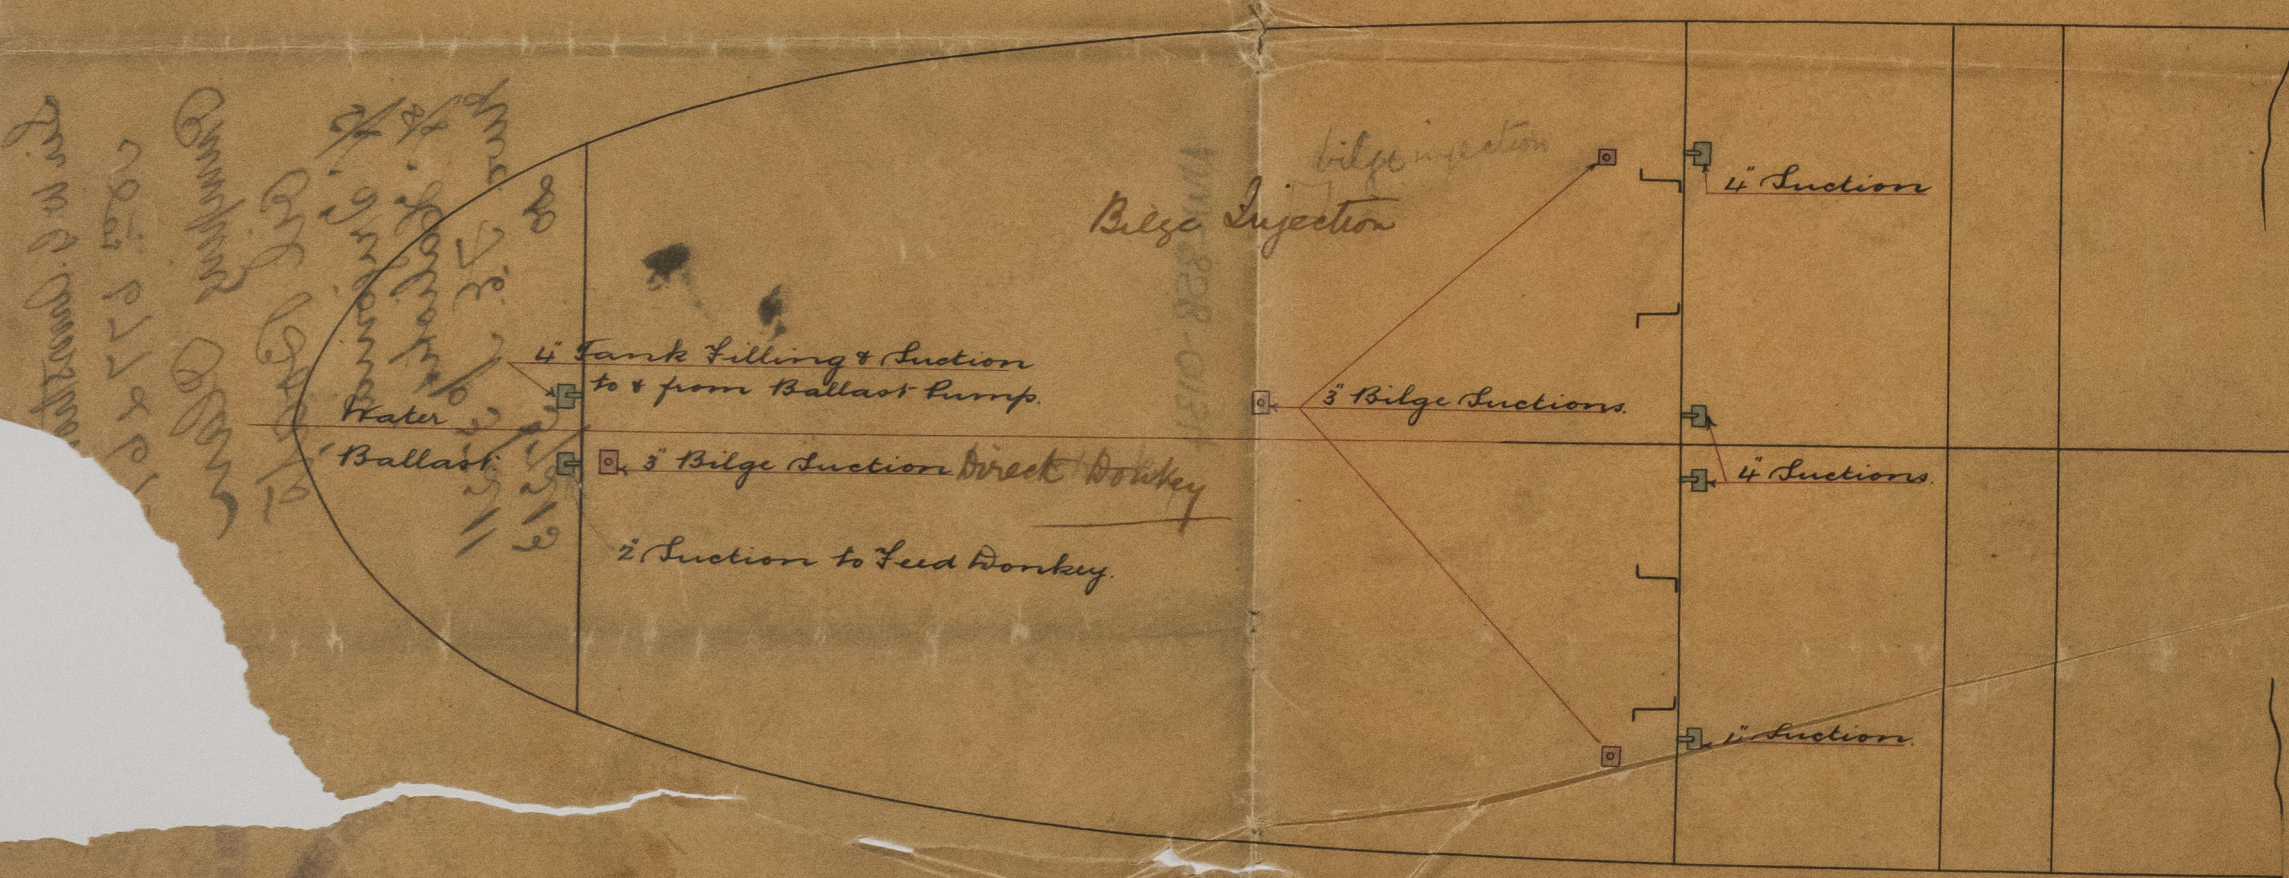
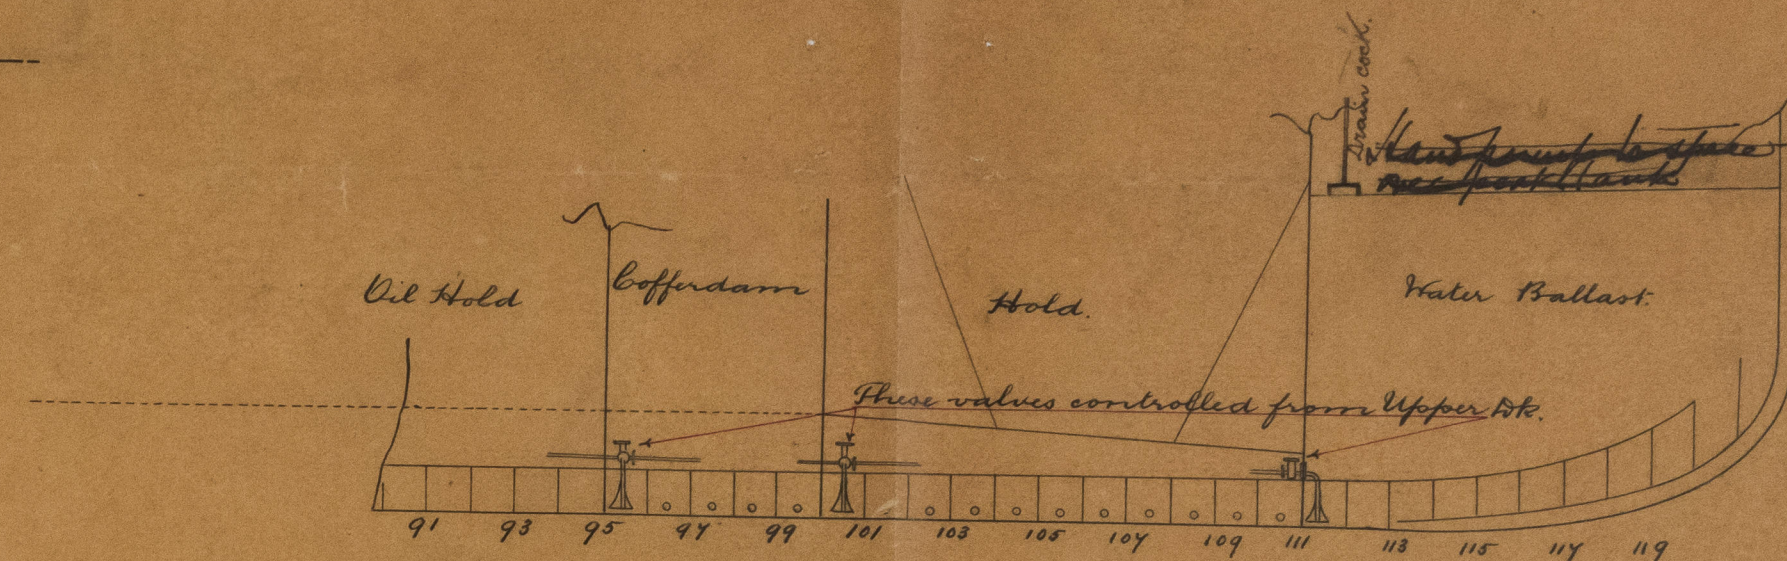


See Rfr
31/8/97
11.8.97

Nos 677 & 8


Arrangement of Ballast and Bilge Suctions.

Scale 1/8" = 1 Foot.

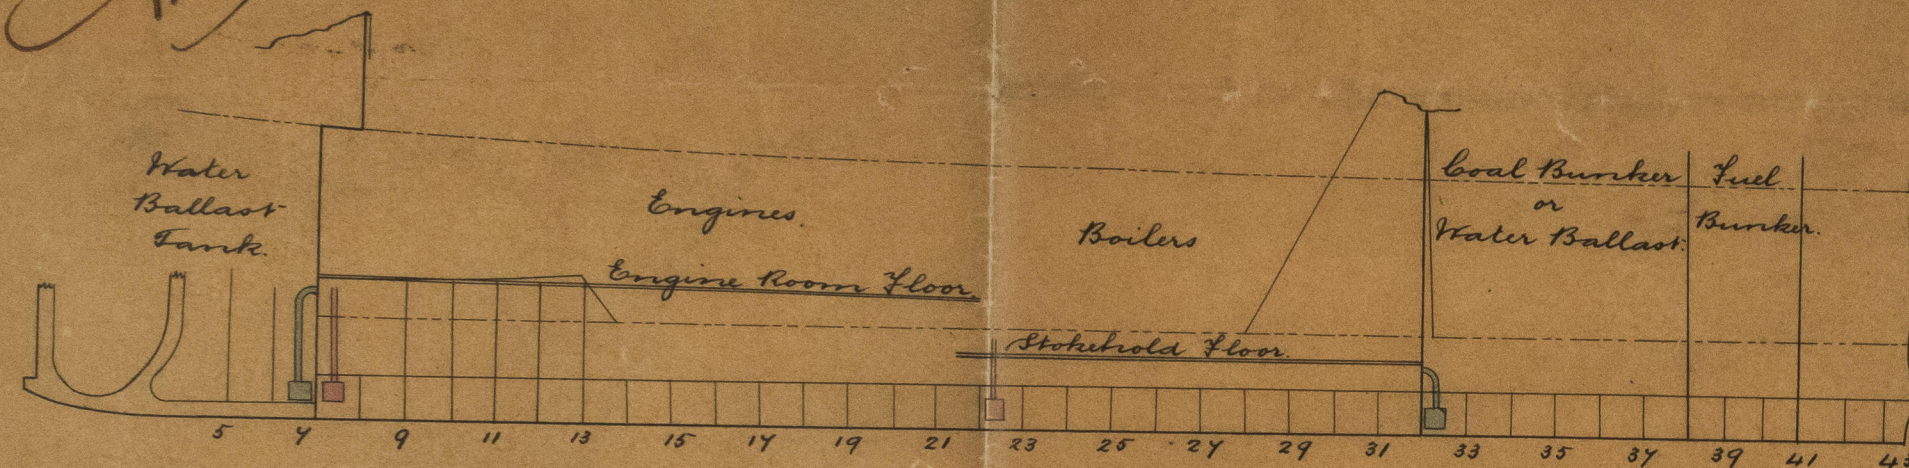

Note. Under Deck Tonnage 1322 tons.

J.M.
3/8/97

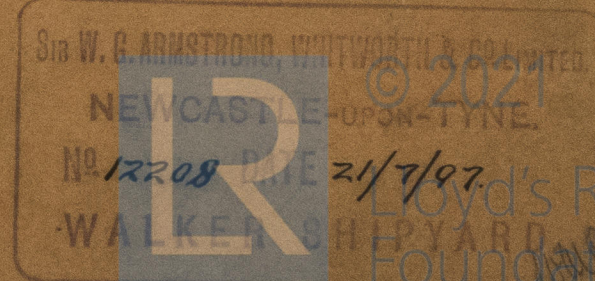

NWX 858-0134

57213

NWE 858-0134

1855
 1856
27/10/18

Lloyd's Register
Foundation



2
 2
 2
 4
 8