

W. Pressure - 120 lbs per square inch

Scale 1" = 1 foot

## Material

All plates stays & rivets  
of Steel. Tubes & W/p stake  
of Iron

Vertical seam  
in centre of front  
of dome, lapped  
& double riveted  
with  $\frac{7}{8}$  holes 3 apart

Shell wetting  
1/4" holes 5" apart

1" holes  
3 1/2" apart

## Heating Surface

Tubes - - - - - 734 sq ft

Furnaces - - - - - 95

b. b hammers - - - - 92 4

Tube plates - - - 34

Total                    9 55                    "

1111  
28/5/9

100




Elrington S.S.206  
no 1164

wp = 120

no 5387  
 24000  
 CMBD.  
 27-10-98

S. Doreen  
Aux F.E. N° 57675

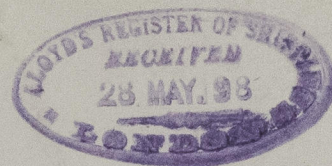


© 2021


Lloyd's Register  
 Foundation



15-10-1911

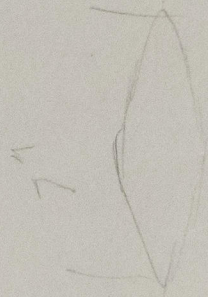

0009

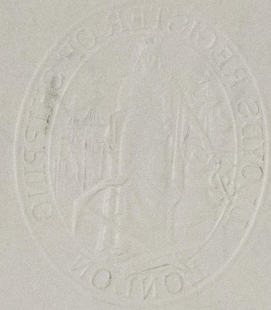

© 2021

Lloyd's Register  
Foundation