

Lloyd's Register of British and Foreign Shipping.

(Report on Vessel No. _____)

Port

Newcastle

No. 5040 SHIP FORGINGS OR CASTINGS.

I have to report that the undermentioned Iron or Steel Forgings ~~or Castings~~,
 manufactured by The Palmers S & S Co
 of Jarrow for the Vessel No. 342, being built
 by Messrs J Readhead & Sons of South Shields
 have been inspected by me as set forth below, and found to be, so far as can be seen,
Sound

Mark on Forgings.

Lloyd's

No. 85295

86




John B Gray

Newcastle

31.8.99

	STERN FRAME.	RUDDER FRAME.	STEM.
Material*	Scrap	Scrap	
How made	Forged	Forged	
Dimensions	12-6	9-4 1/2	
Progress on Inspection	Forged & Smithed	Forged & Smithed	not seen
Date when Inspected	February 9 to March 15/99	May 8 to July 24/99	


SKETCHES OF FRAMES SHOWING POSITION AND DESCRIPTION OF WELDS OF FORGINGS, OR PARTICULARS OF
 TESTS APPLIED TO CASTINGS.

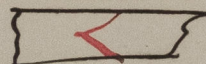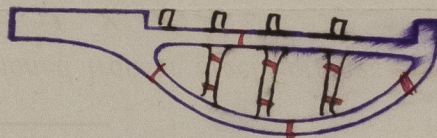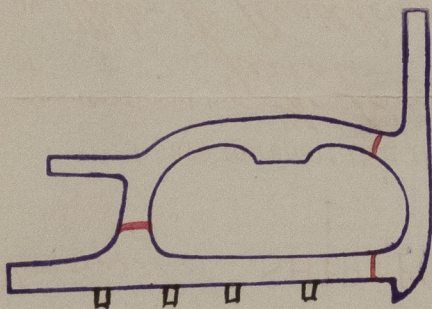

Fee (if any chargeable) £

:

To be paid at

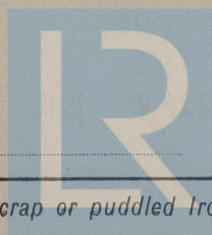

© 2021

Lloyd's Register
Foundation

J Readhead Slons

No 342

G.P. Drexler

Newcastle Report

N^o 39086



© 2021

Lloyd's Register
Foundation