

12 1-99


— ALTERNATIVE —
— PLAN OF TWEEN DECK BULKHEAD. —

— SCALE 1/4" = ONE FOOT. —

4/1/99.
573
J.R.H.

— SECTION. —

5" PLATES FLANGED
TO FORM STIFFENERS
5x5x12/20
Single Angle
ON DECK.
Single Angle
UPPER DECK.
5x5x12/20

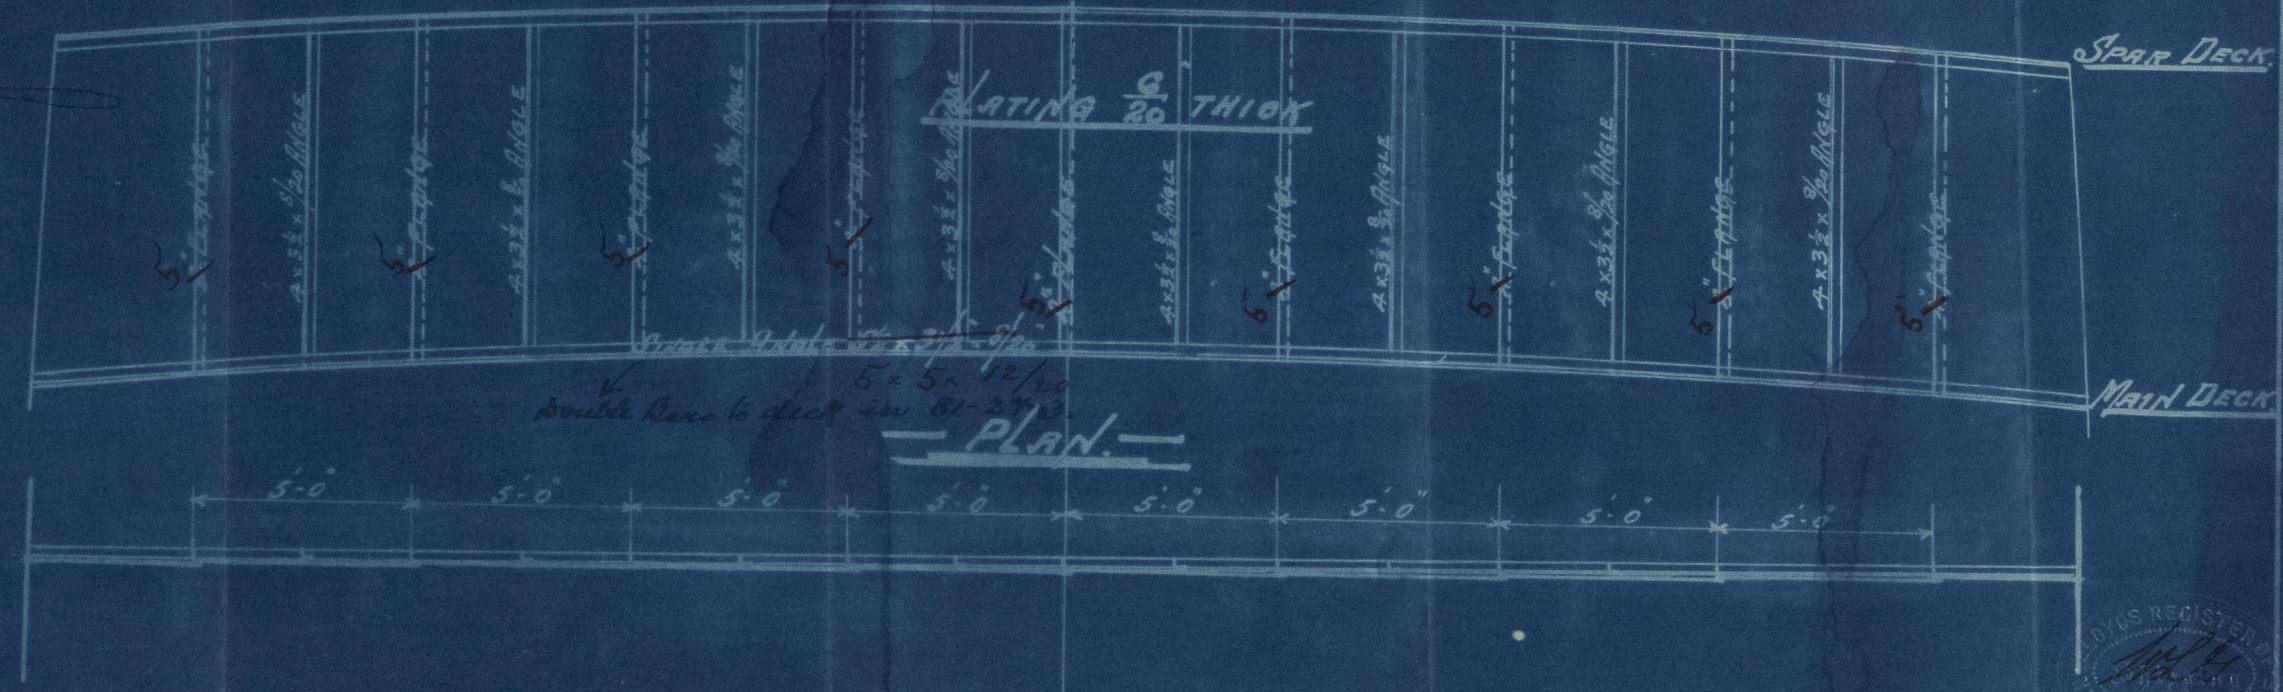

— NUMERALS. —
FRAME N° 90.99.
PLATING N° 32600.

— PLAN. —

J.R.H.
11/1/99

N° 81, 2 & 3-4



Lloyd's Register
Foundation
NWC868-0-01



Northumberland Stb.

Sp. No 81.2.384

Tween Deck Bulkhead
Stiffening

S.S. Rosalie

Newcastle Report

No 39518

S.S. Planet Mais

Newcastle Report

No 40208

S.S. Rhodesia

Newcastle Report

No 40416



© 2021

Lloyd's Register
Foundation