



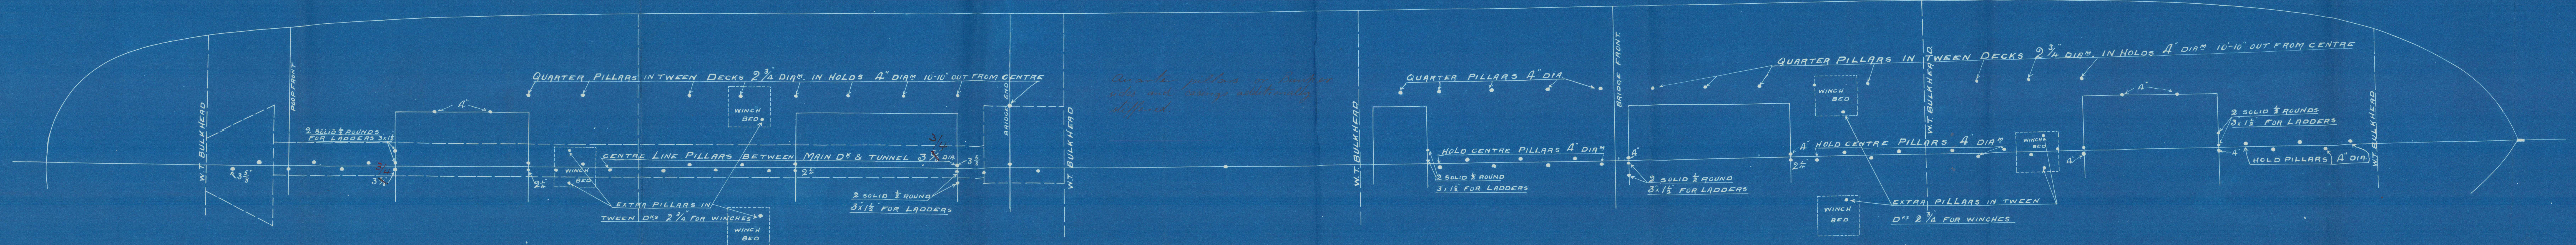

18-8-71

STANCHION PLAN S.S. N° 81

SCALE $\frac{1}{8}$ = 1 FOOT

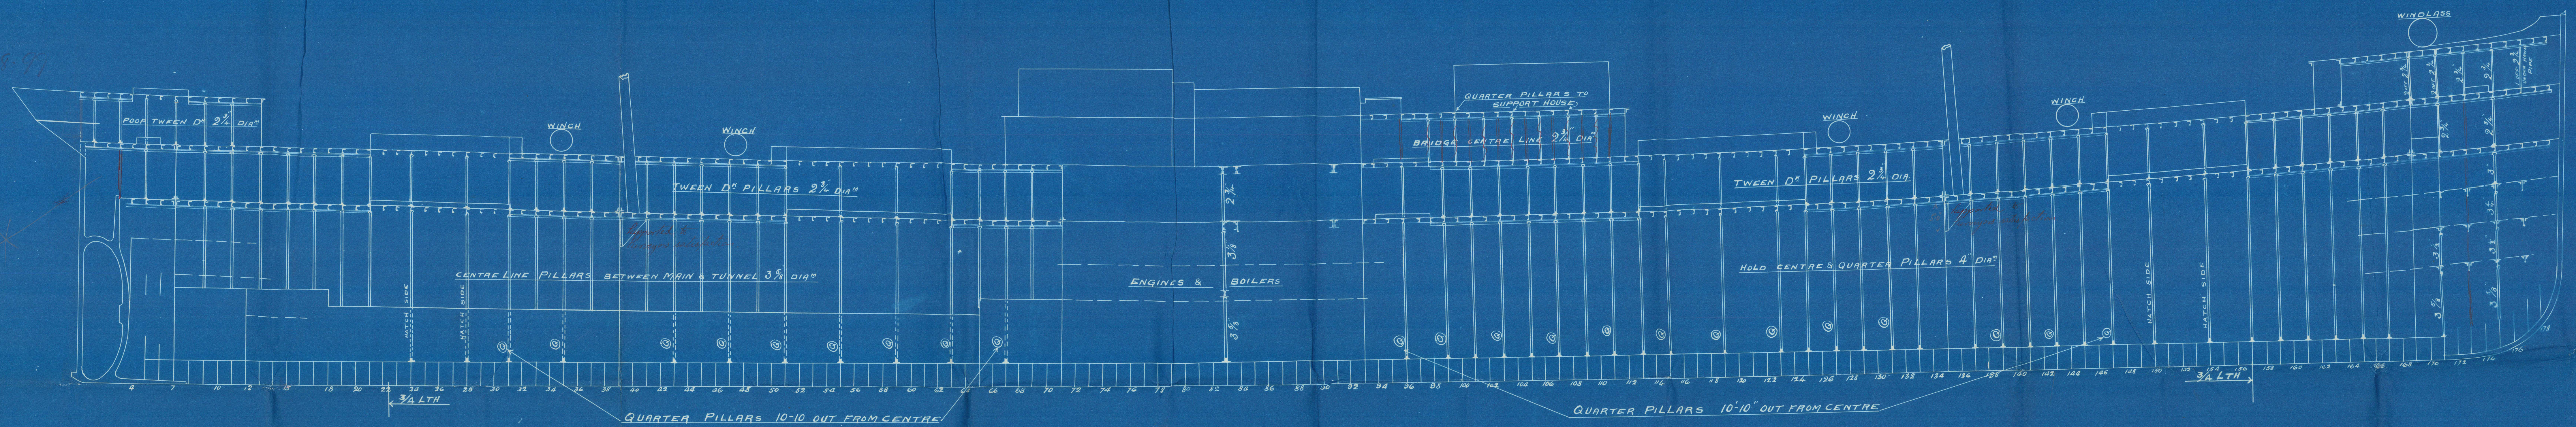

20
18-8-71

Northumberland
S. B. Co.

S. S. No 81

Pillaring Plan



J. P. Rosalie

Newcastle Report

No 39518

NWC868-0113



© 2021

Lloyd's Register
Foundation