


14/3/99
759.

JRH

Beam Knee No 1

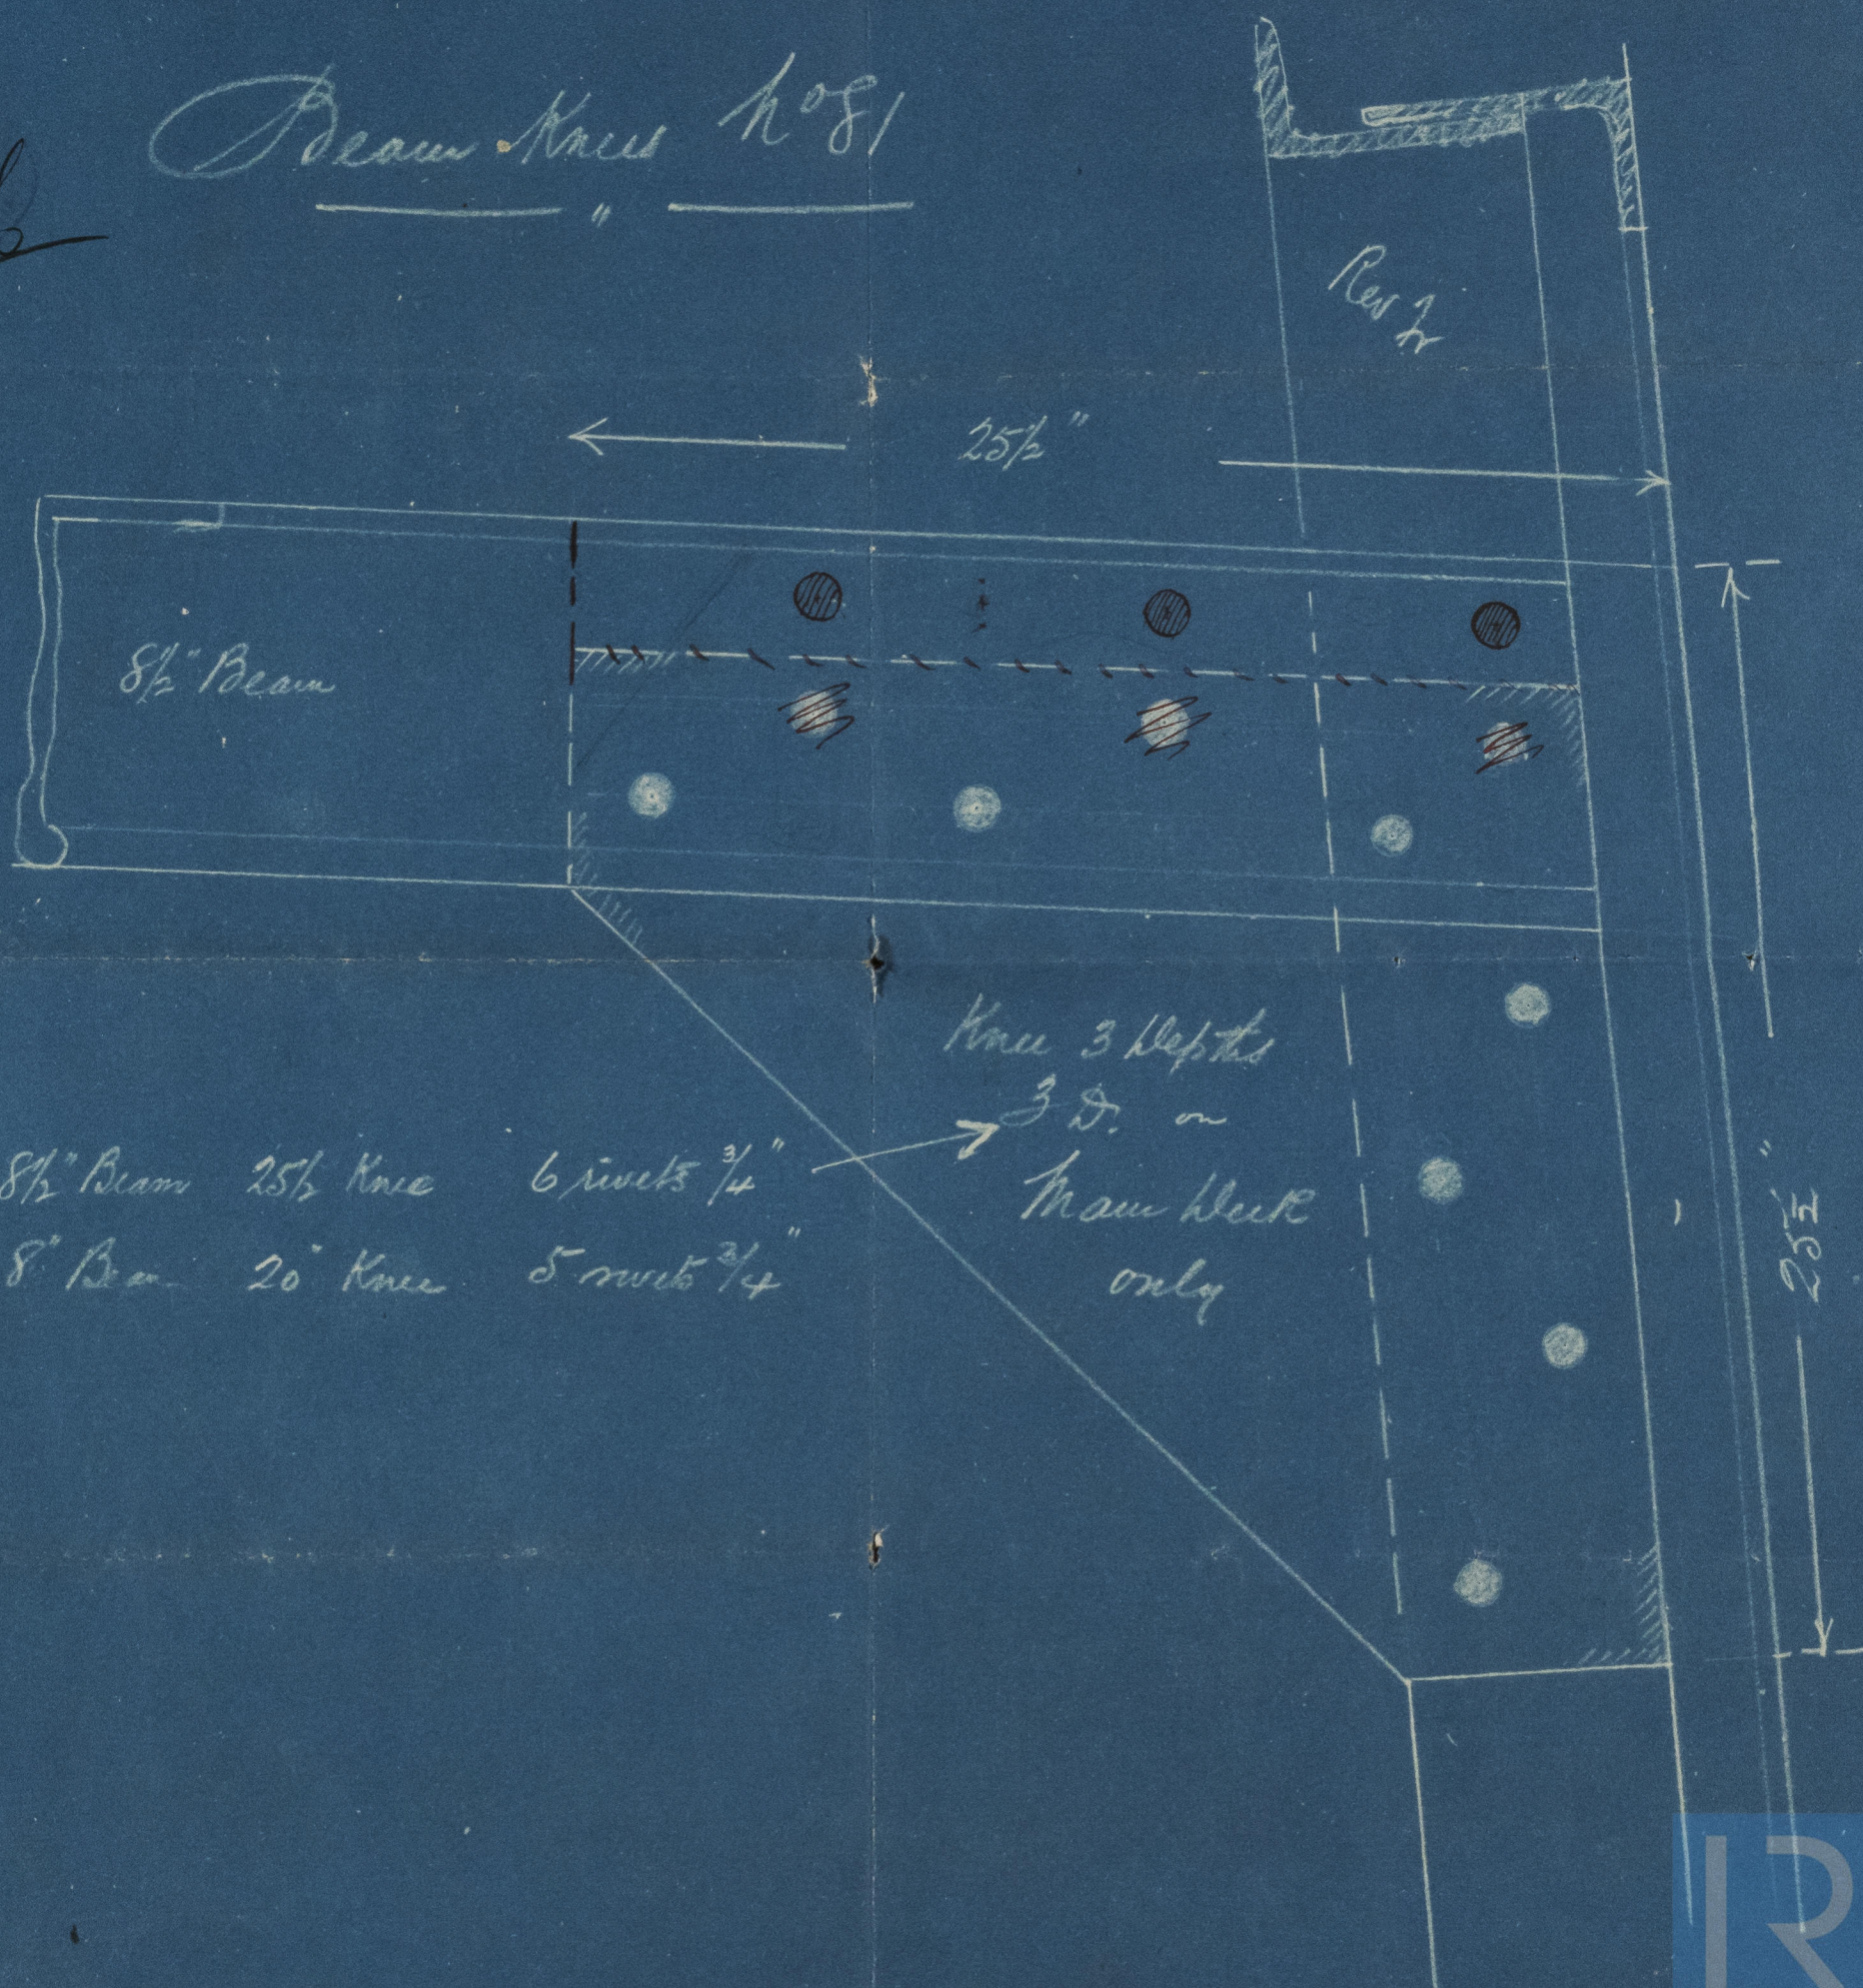

Main Deck 8 1/2" Beam 25 1/2" Knee 6 rivets 3/4"
 Spar Deck 8" Beam 20" Knee 5 rivets 3/4"

Knee 3 depths
 3 D. on
 Main Deck
 only



Lloyd's Register
 Foundation
 NW868-013

N. S. B. Co.

Sp. No 81

Plate Knees to
Spar & Main Deck
Beams

J. J. Rosalie

Newcastle Report

N^o 39518

NW 2868-0116



© 2021

Lloyd's Register
Foundation