


Lloyds

—MAST & SAIL PLAN—

—S.S. N^o 81—

SCALE 1/8" = 1 FOOT

4/8/99.
1023.
185

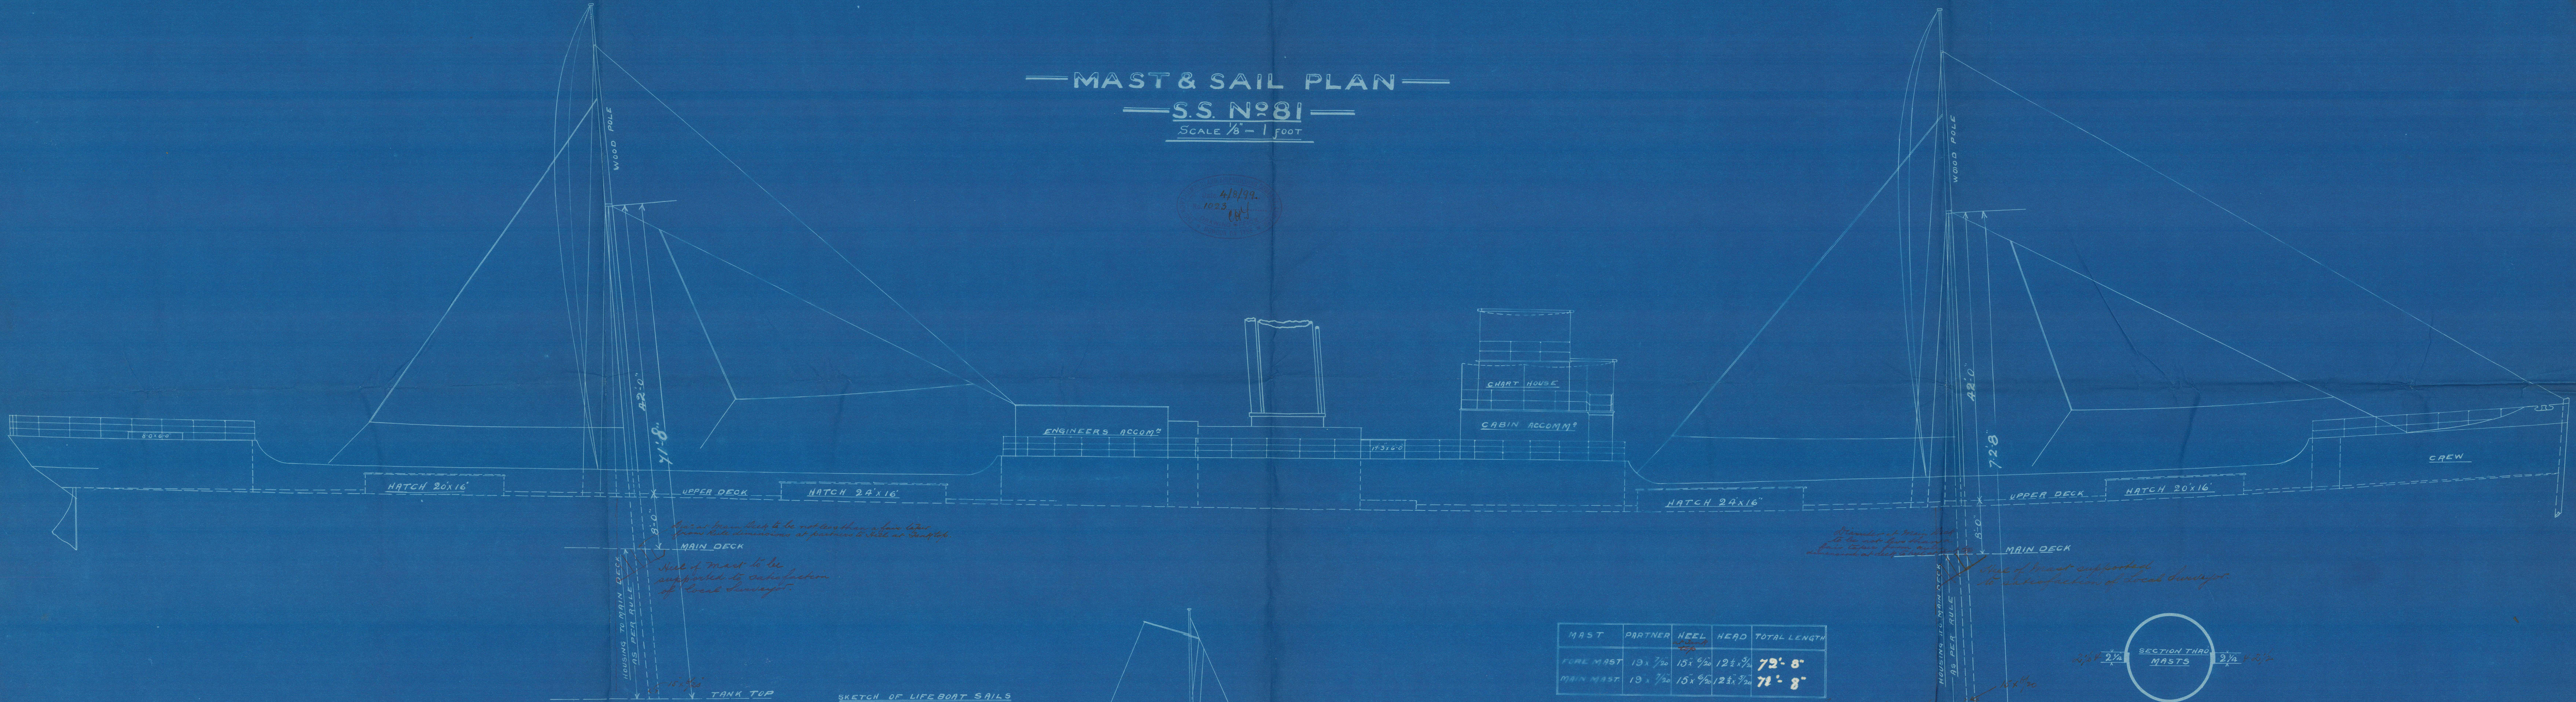


*Apex of main mast to be not less than 4 feet below
from the dimensions of partners & heel as described*

*Keel of mast to be
supported to satisfaction
of local surveyor.*

*Apex of main mast to be not less than 4 feet below
from the dimensions of partners & heel as described*

*Keel of mast supported
to satisfaction of local surveyor.*

SKETCH OF LIFEBOAT SAILS
2 LIFEBOATS 23'-0" x 7'-5" x 3'-6"

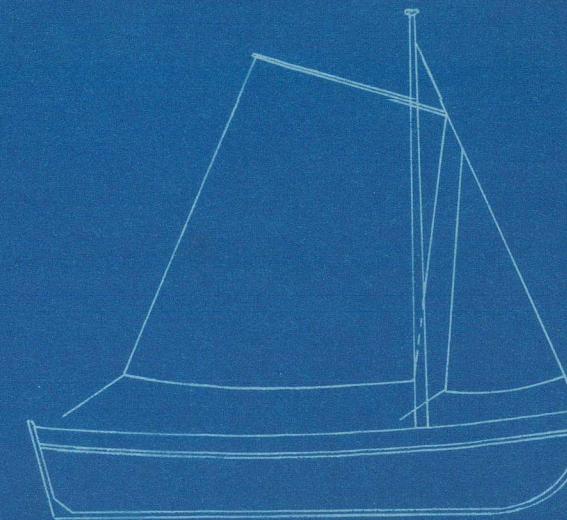

MAST	PARTNER	HEEL	HEAD	TOTAL LENGTH
FORE MAST	13 x 7/20	15 x 9/20	12 1/2 x 1/2	72'-8"
MAIN MAST	13 x 7/20	15 x 9/20	12 1/2 x 1/2	71'-8"

BUTTS OVERLAPPED DOUBLE RIVETTED
BEAMS " SINGLE
MASTS DOUBLED IN WAY OF PARTNERS & HEEL



Northumberland
S. B. Co. Ltd

S. S. No 81
Invest Plans

J. J. Rosalie
Newcastle Report
No 39518

8110-8982M



© 2021

Lloyd's Register
Foundation