

MIDSHIP SECTION
 SS N^o 81-
 SCALE 1" = ONE FOOT.
 CLASS 100 71 SPAR DECK
 SPECIAL FREEBOARD STRENGTHENED SIDES
 DIMENSIONS 360" x 48" x 30" x 10"
 LLOYDS " " 358.16 x 47.66 x 30" x 10" SPAR D^K MLD


EQUIPMENT.

2 BOWER ANCHORS (STOCKLESS) 5 1/2 CWTs EACH
 1 " " (ROGERS) 12 3/4 " EX STOCK
 1 STREAM " " 6 1/2 " " "
 1 KEDGE " " 6 1/2 " " "
 270 FAS 1/8" STUD CHAIN CABLE (STEAM)
 90 FAS 1/2" STEEL WIRE (TOWLINE)
 120 FAS 3/4" " " (HAWSEY)
 90 FAS 3/2" " " (")
 4.90 FAS 2 1/2" " " (")

BRIDGE STRINGER
 40 x 9/20 DOUBLE RIV'D OVERLAPS
 POOPY FLE 36 x 7/20

Forecastle 1/4" sheathed.
 POOP & BRIDGE 1/16" STEEL

20.9.98
 5.10.98
 16.11.98
 27.1.99
 14.2.99
 31.3.99
 17.4.99
 4.5.99
 19.5.99
 17.8.98

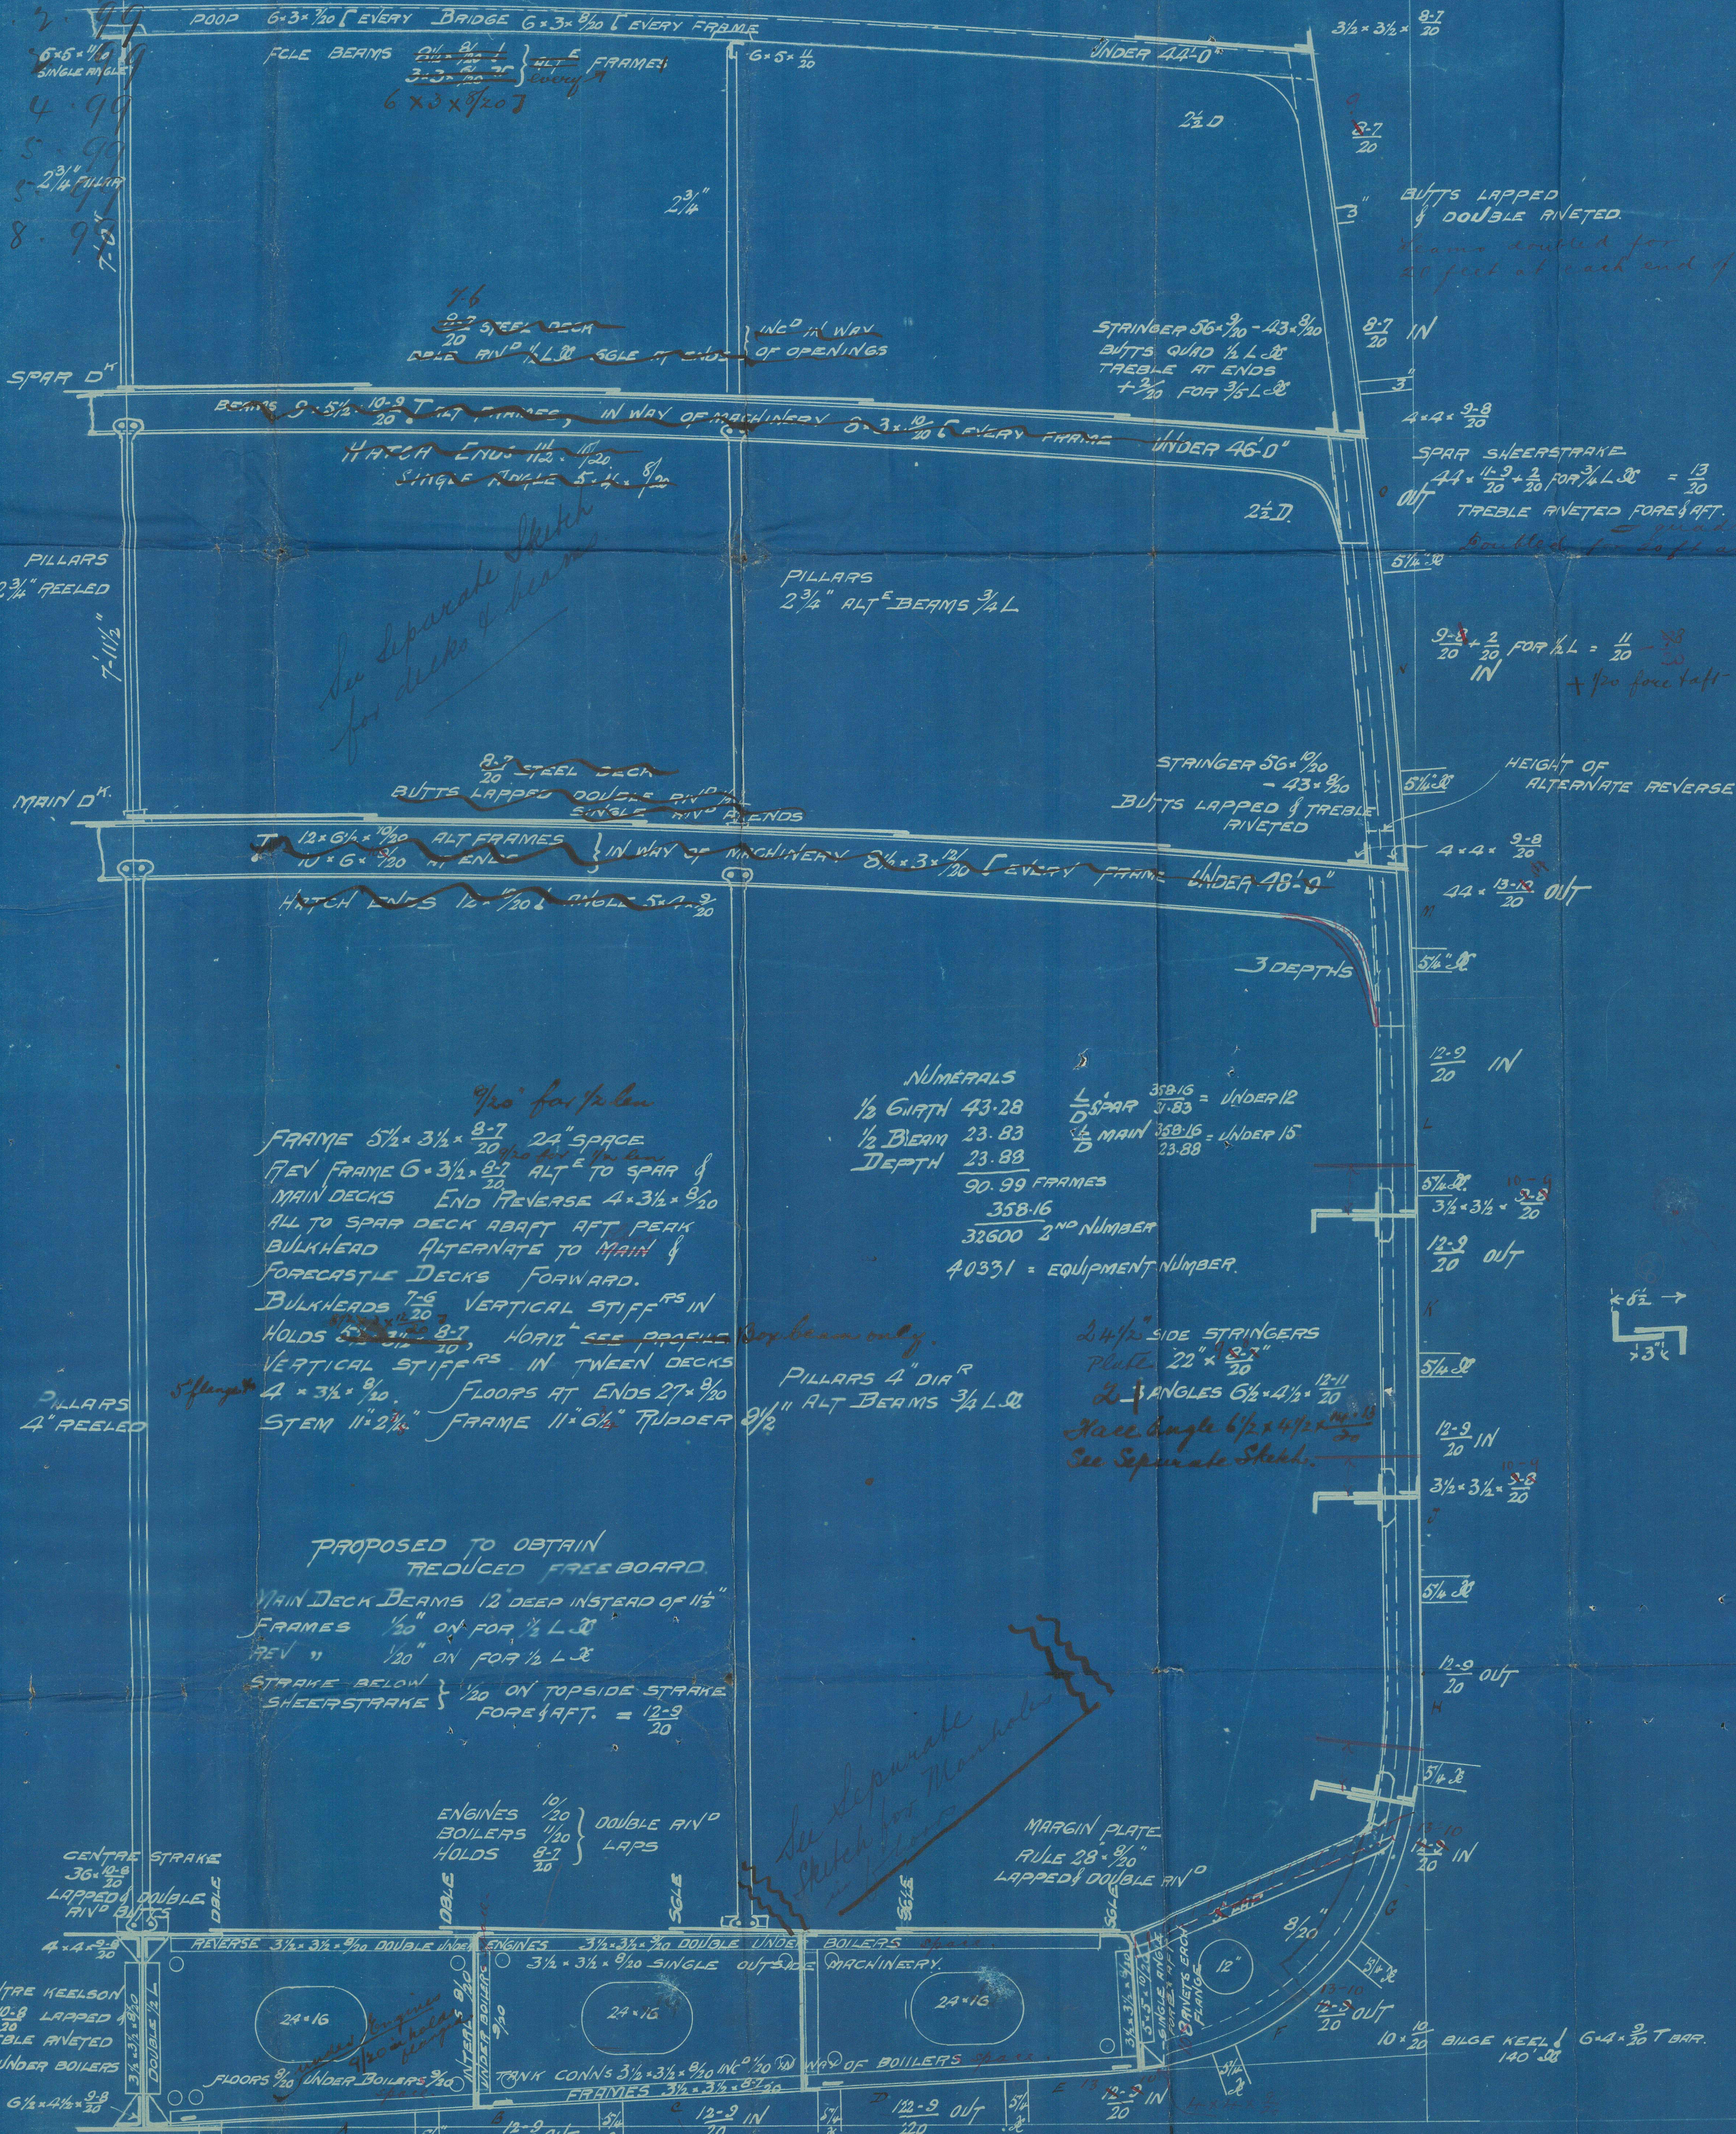

NUMERALS
 1/2 GIRTH 43.28
 1/2 BEAM 23.83
 DEPTH 23.83
 90.99 FRAMES
 358.16
 32500 2ND NUMBER
 40331 = EQUIPMENT NUMBER.

1/20 for taken
 FRAME 5 1/2 x 3 1/2 x 8-7/20 24" SPACE
 REV FRAME 6 x 3 1/2 x 8-7/20 ALT TO SPAR & MAIN DECKS
 END REVERSE 4 x 3 1/2 x 8-7/20
 ALL TO SPAR DECK ABOARD AFT PERK BULKHEAD ALTERNATE TO MAIN & FORECASTLE DECKS FORWARD.
 BULKHEADS 7-6 VERTICAL STIFFERS IN HOLDS 8-7/20, HORIZ. SEE PROFILE.
 VERTICAL STIFFERS IN TWEEN DECKS
 FLOORS AT ENDS 27 x 9/20
 STEM 11 x 2 1/2" FRAME 11 x 6 1/2" TRIPPER 8-7/20






PROPOSED TO OBTAIN REDUCED FREEBOARD.
 MAIN DECK BEAMS 12" DEEP INSTEAD OF 11 1/2"
 FRAMES 1/20 ON FOR 1/2 L. 30"
 REV " 1/20 ON FOR 1/2 L. 30"
 STRAKE BELOW 1/20 ON TOPSIDE STRAKE
 SHEER STRAKE FORE & AFT. = 12-3/20

2 1/4" SIDE STRINGERS
 PLATE 22 x 1 1/2"
 2 ANGLES 6 1/2 x 4 1/2 x 12-11/20
 KEEPER ANGLE 6 1/2 x 4 1/2 x 12-11/20
 See Separate Sketch.



RIVTS SHELL LAPPED & TRIPLE RIVETED EXCEPT WHERE OTHERWISE MARKED. QUAD IF OVER RULE WIDTH. FLANGING - IF FLANGED FLOORS & INTS ARE ADOPTED SAME TO BE INC 1/20 IN THICKNESS. Submarine flanged on one side only.

20.9.98

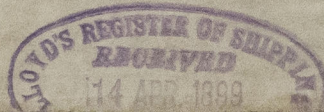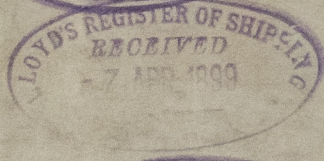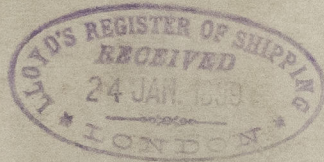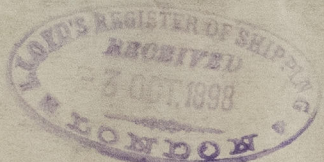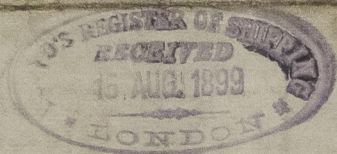





Northumberland
S. B. Co's

Nos 81-82.

Mid section.

Two freeboard N° 37233

S. Rosalie

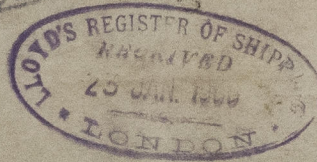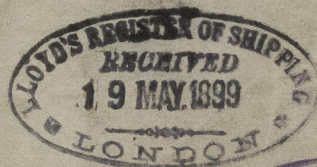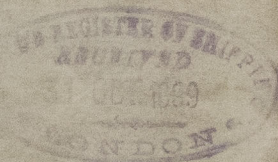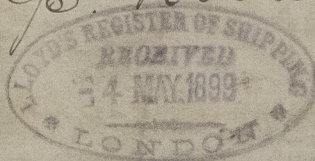

NW 868-0132



© 2021

Lloyd's Register
Foundation