




16.3.99

N^{os} 81.2.3.4

ARRANGEMENT OF MANHOLES IN FLOORS

SCALE 1/2" = ONE FOOT

9/3/99
749
JRH

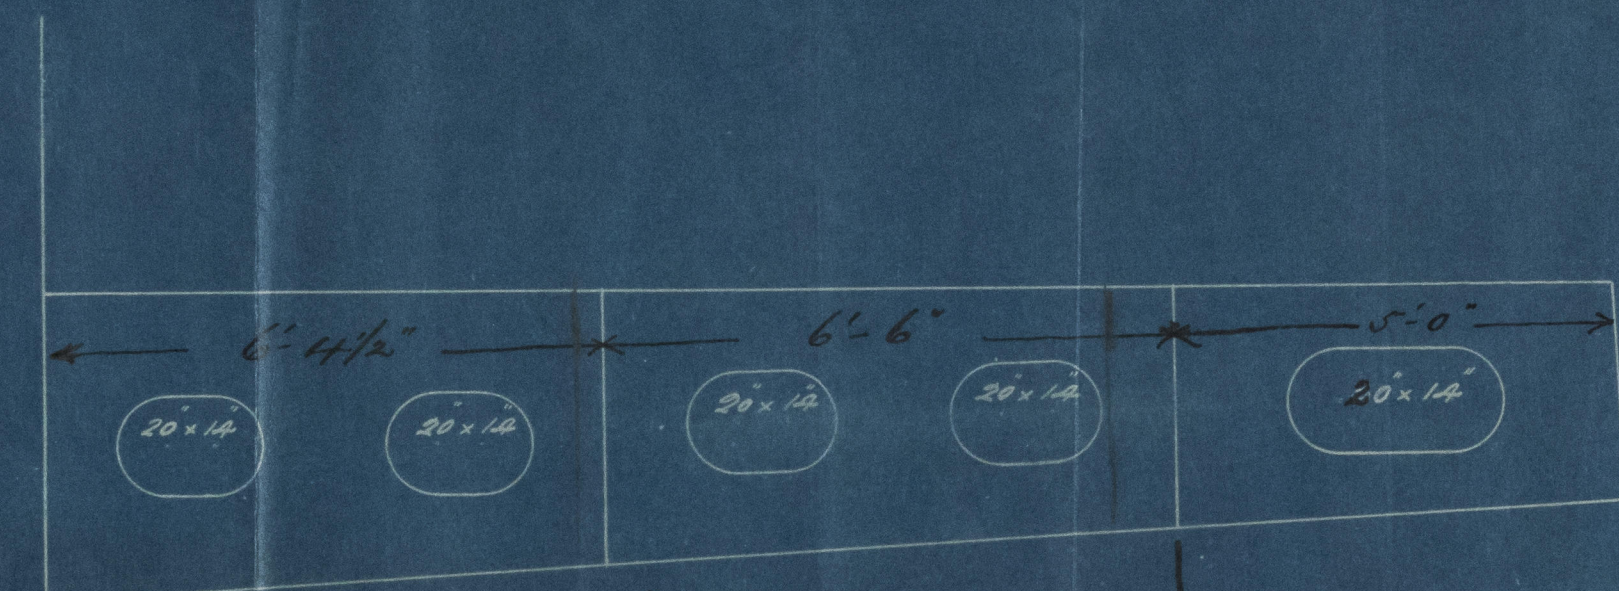

81 Ship
Fin 8.2.4
Surrey and
manholes

carried well
forward and aft

JRH
16/3/99




Lloyd's Register
Foundation

H. S. B. Co

~~Nos 81-82-83-84~~

Manholes in
Floors

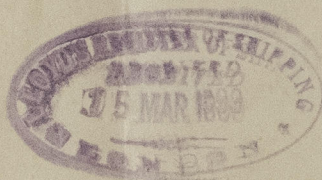

NWC868-0134



© 2021

Lloyd's Register
Foundation