



SCALE FULL SIZE. S.S. N<sup>o</sup> 81.

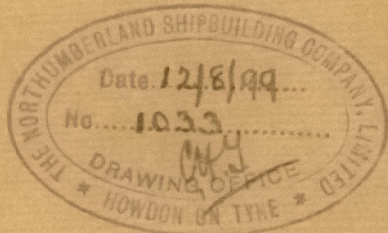

W. L. G.  
14.8.99

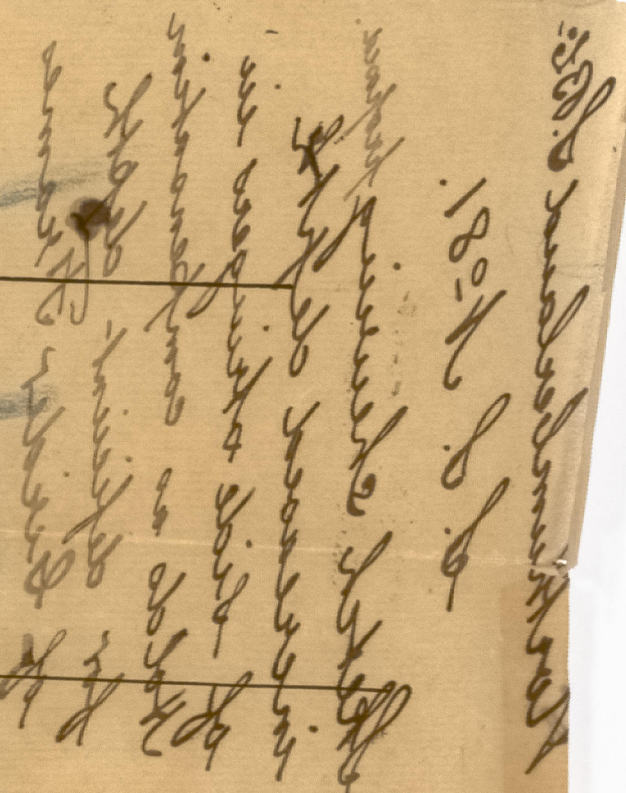

Northumberland L.B.C.  
S. S. N<sup>o</sup> 81.

Sketch showing proposed  
increased depth  
of side stringers in  
Holds as compensation  
for deficient depth  
of Binder Frames

*[Faint handwritten notes, possibly "Reg..."]*

1872. N. 22

35127103

© 2021  
Lloyd's Register  
Foundation