
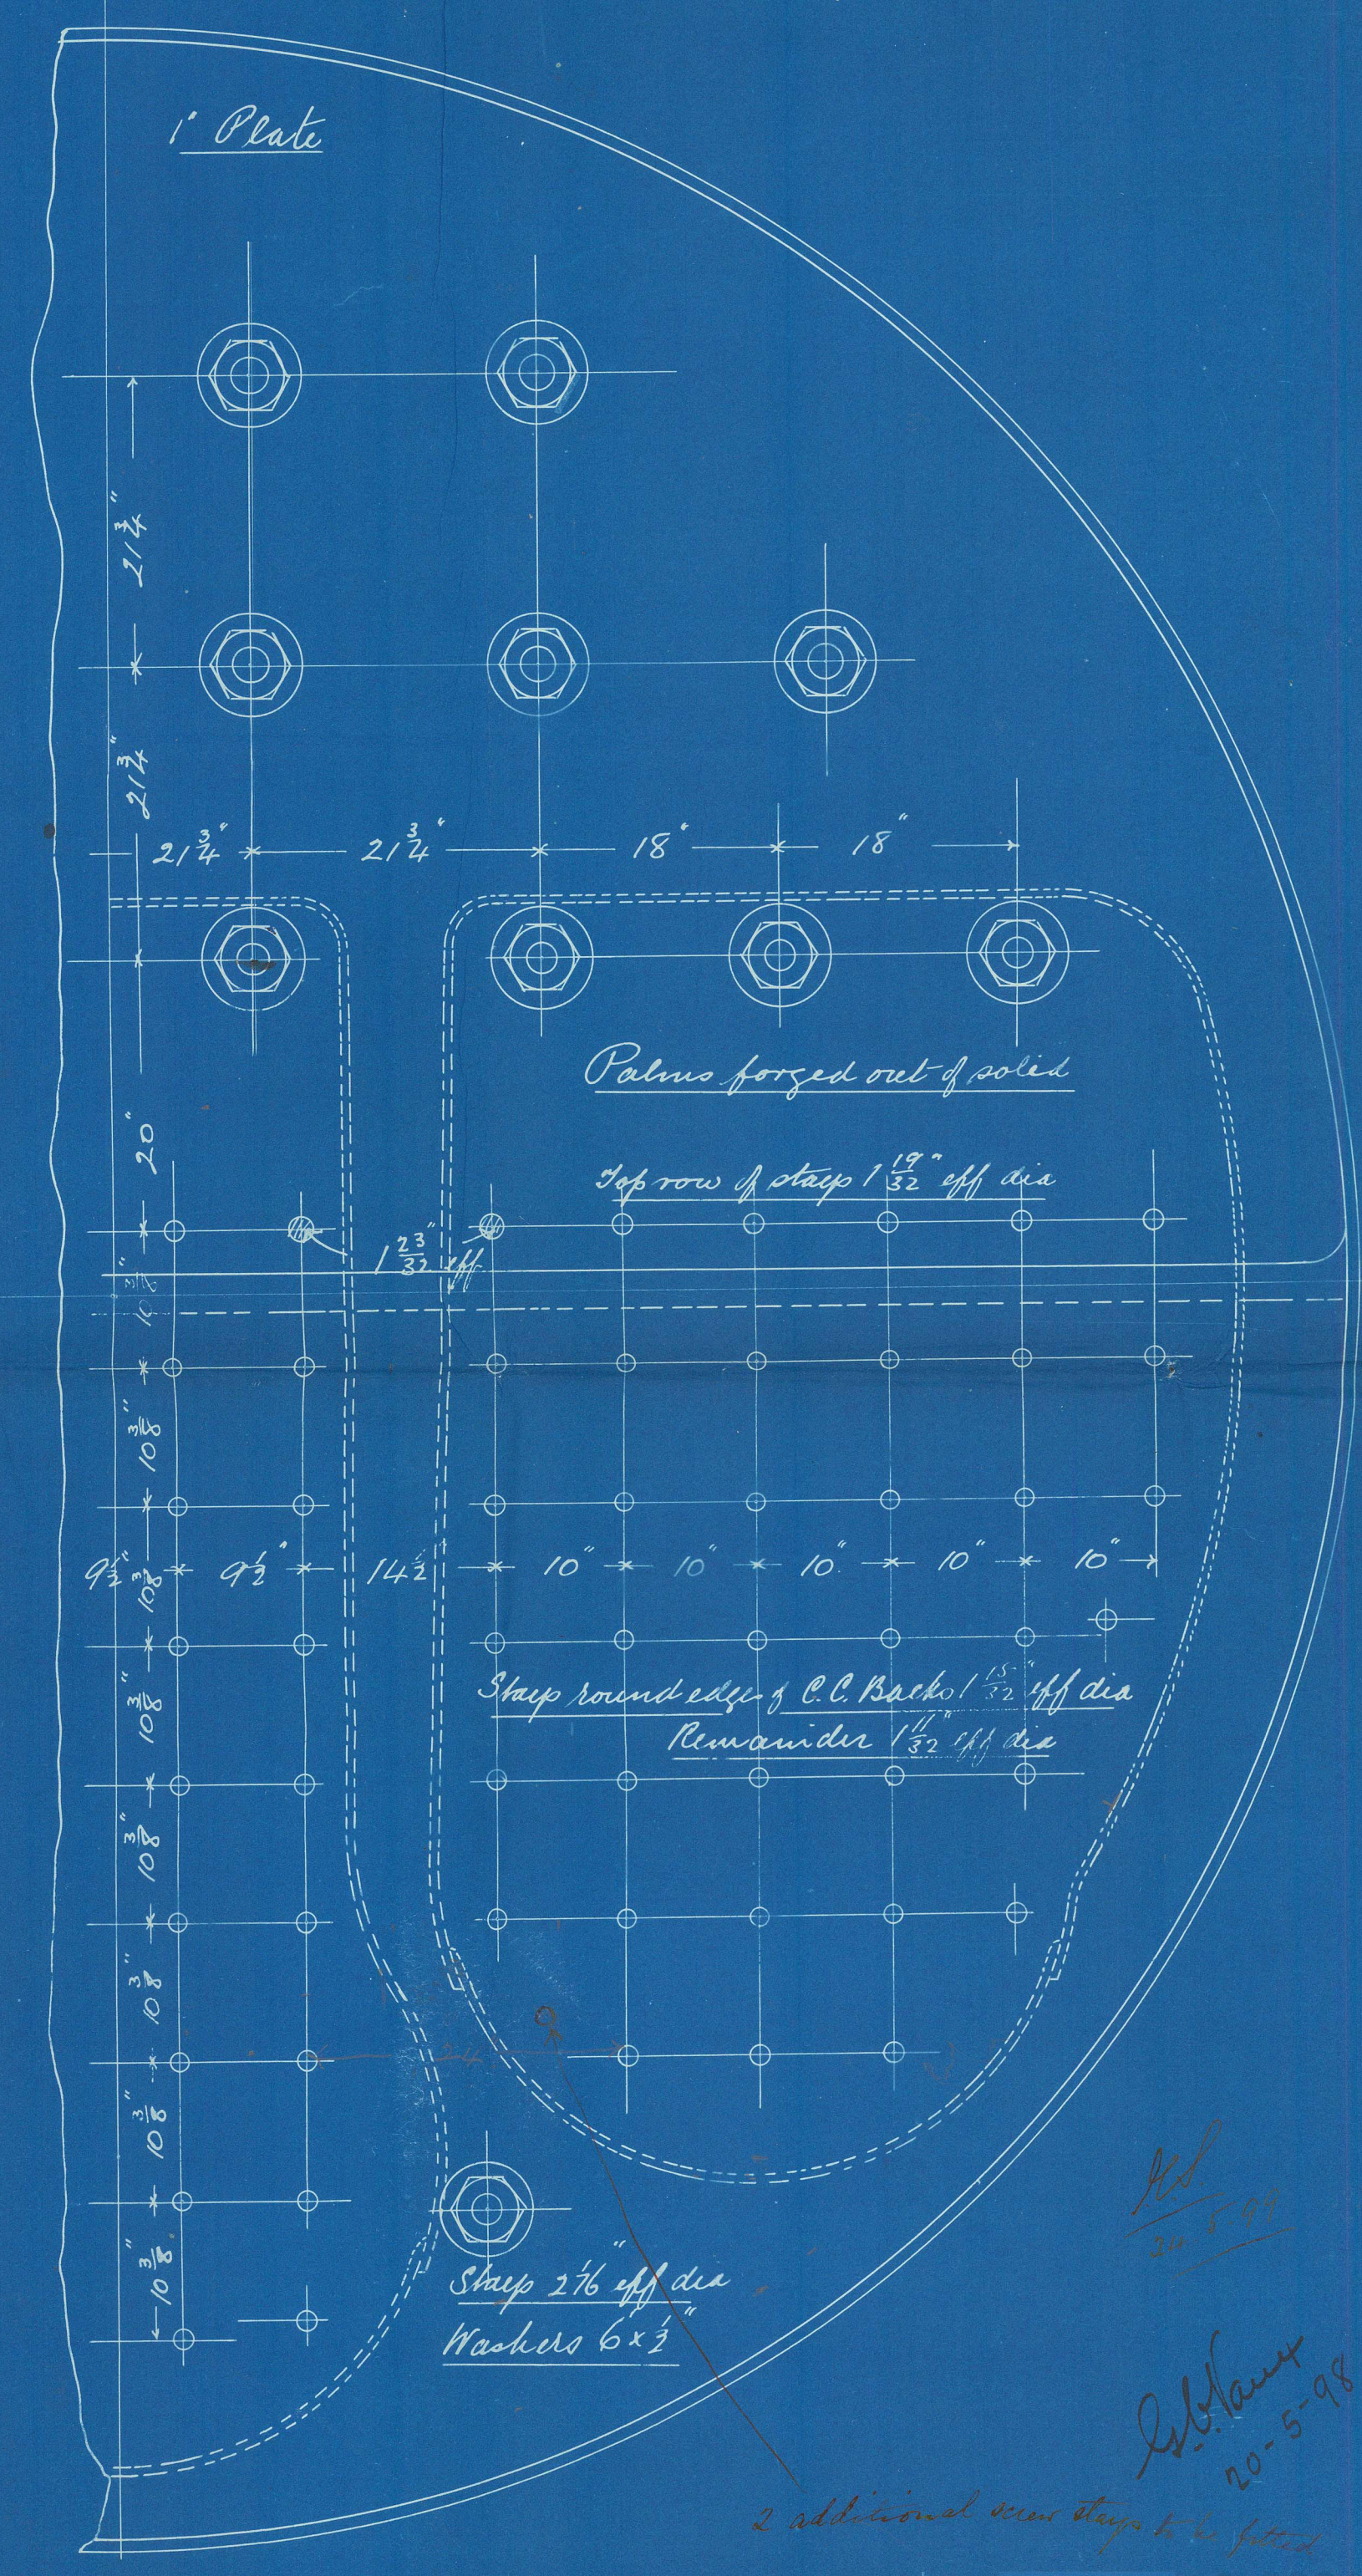
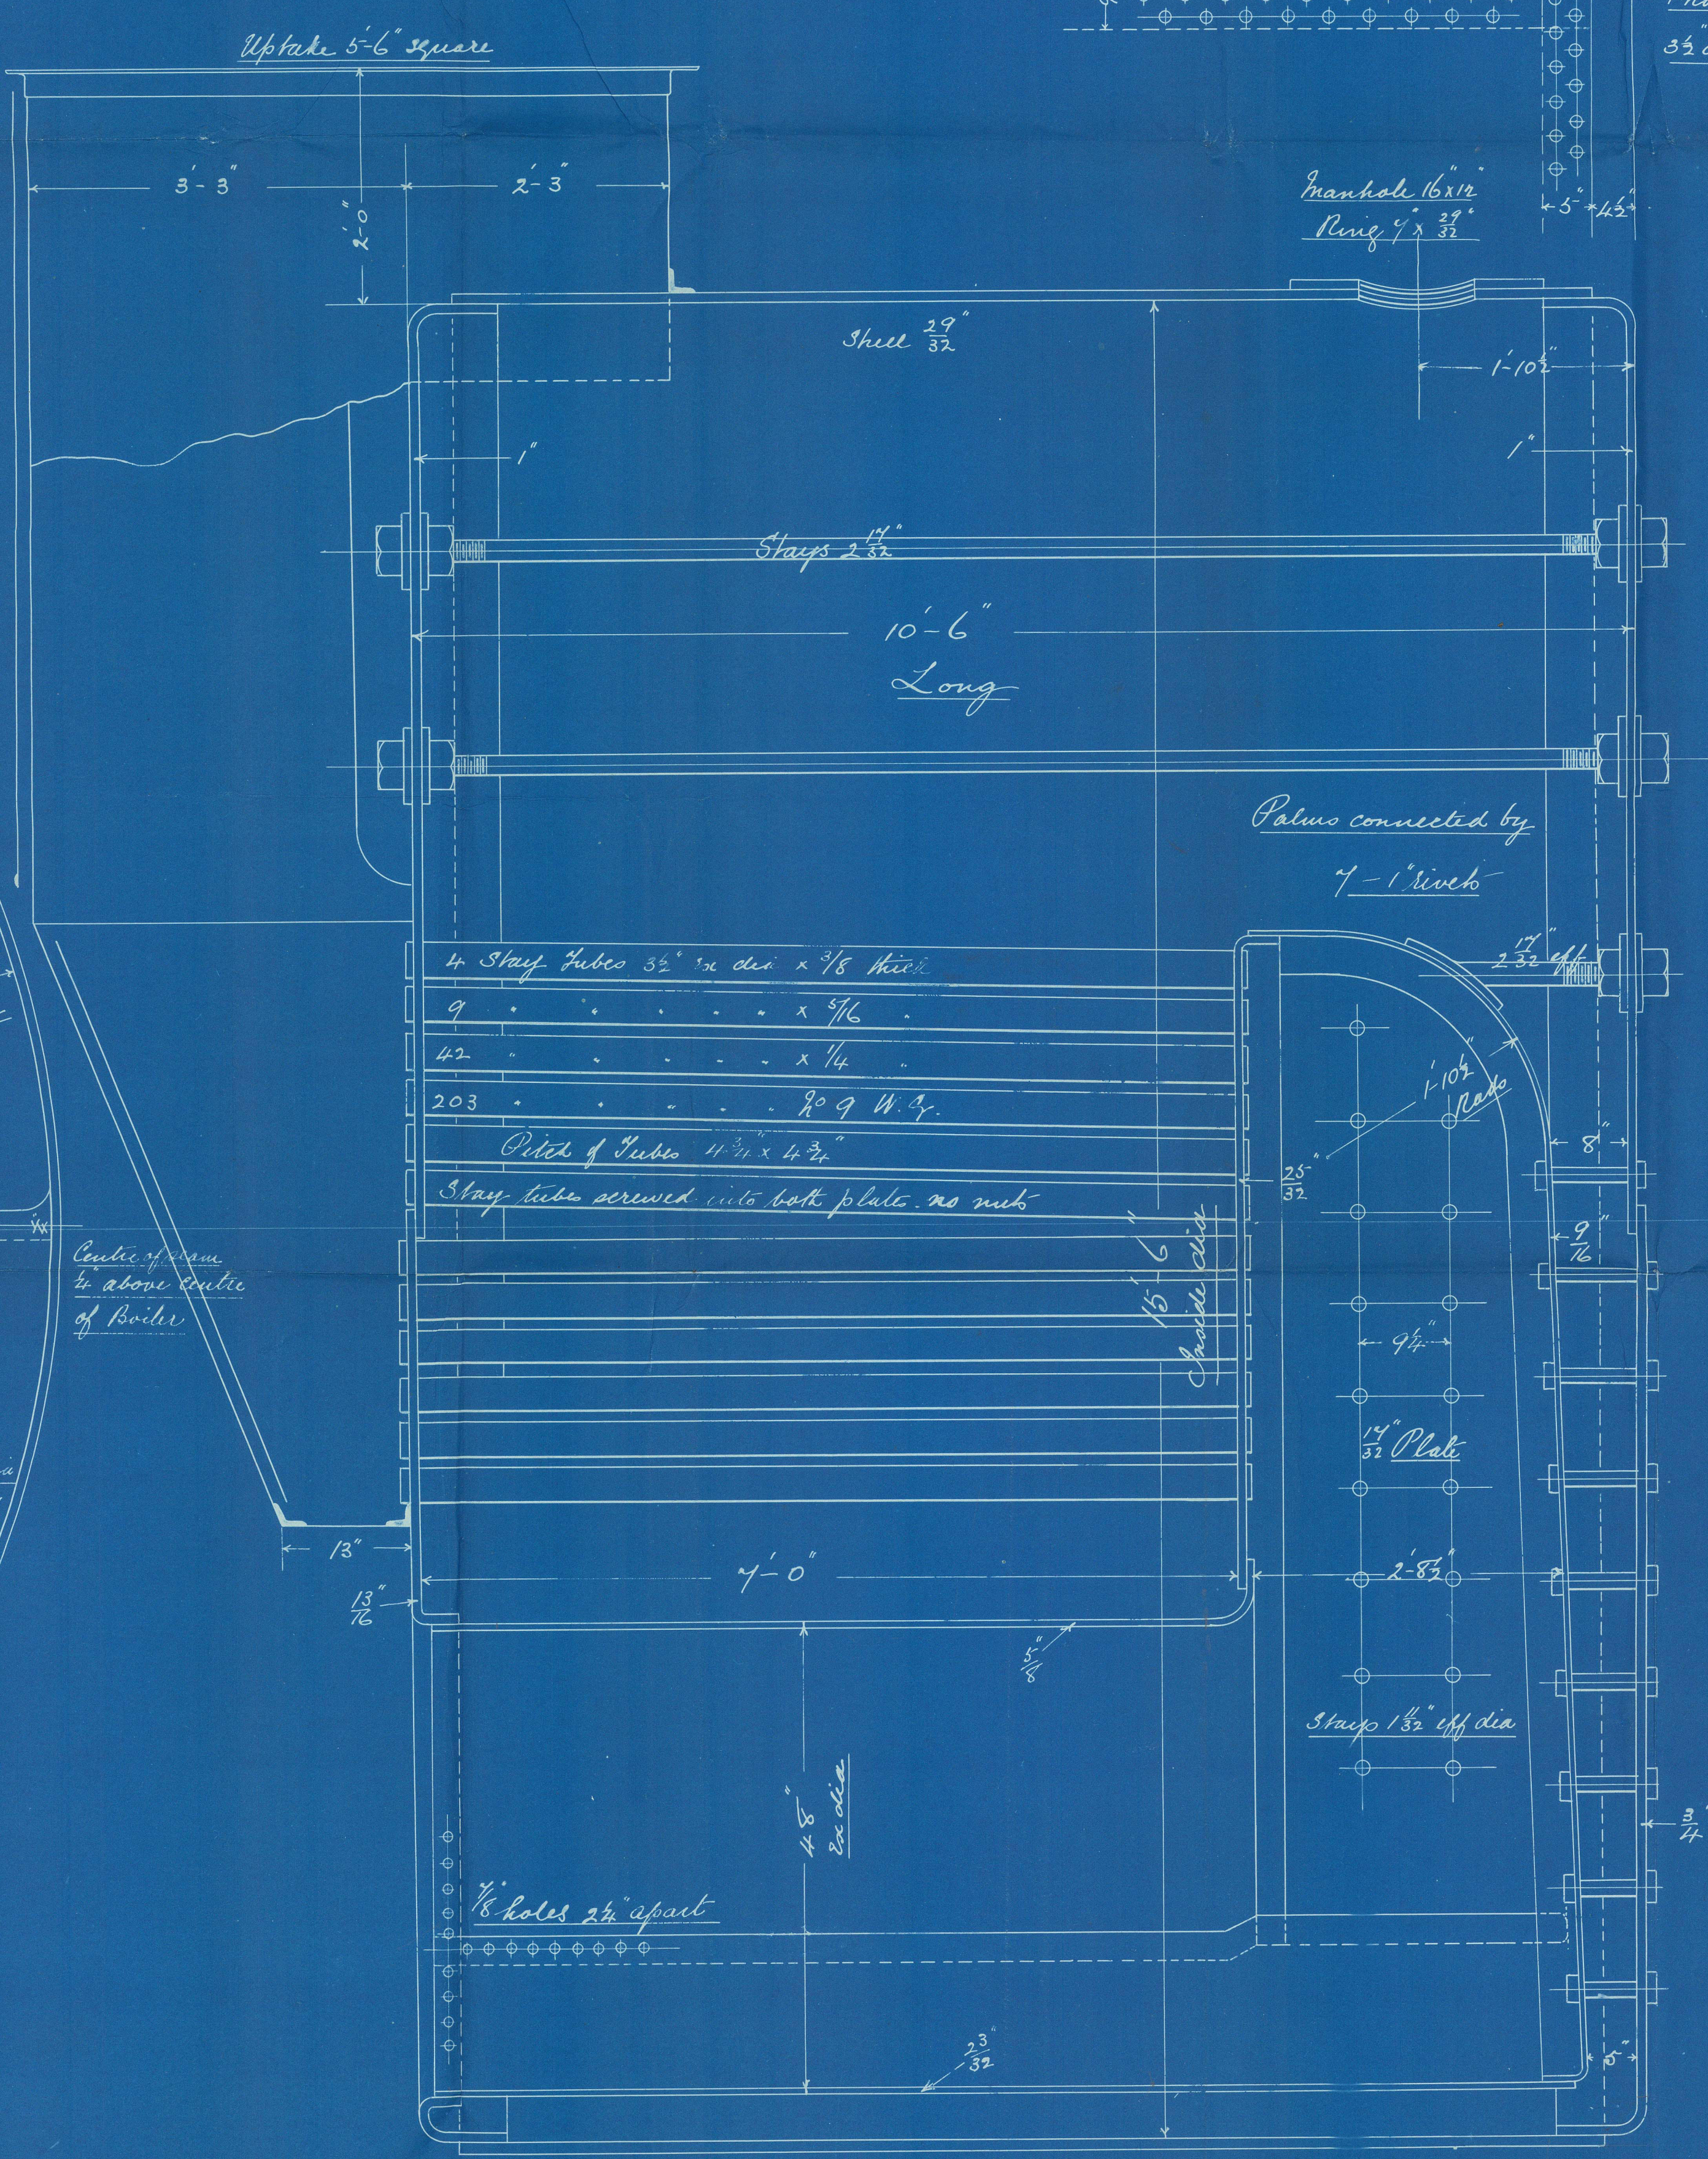


24-5-99

No 1220 Multitubular Boiler for 7's
 "Monarch"
 W.P. 100 lbs per sq. inch
 Scale 1 in. = 1 foot
 Tested to Lloyd's Requirements

Material
 All Plate Rivet & Stays
 of steel Tubes of iron

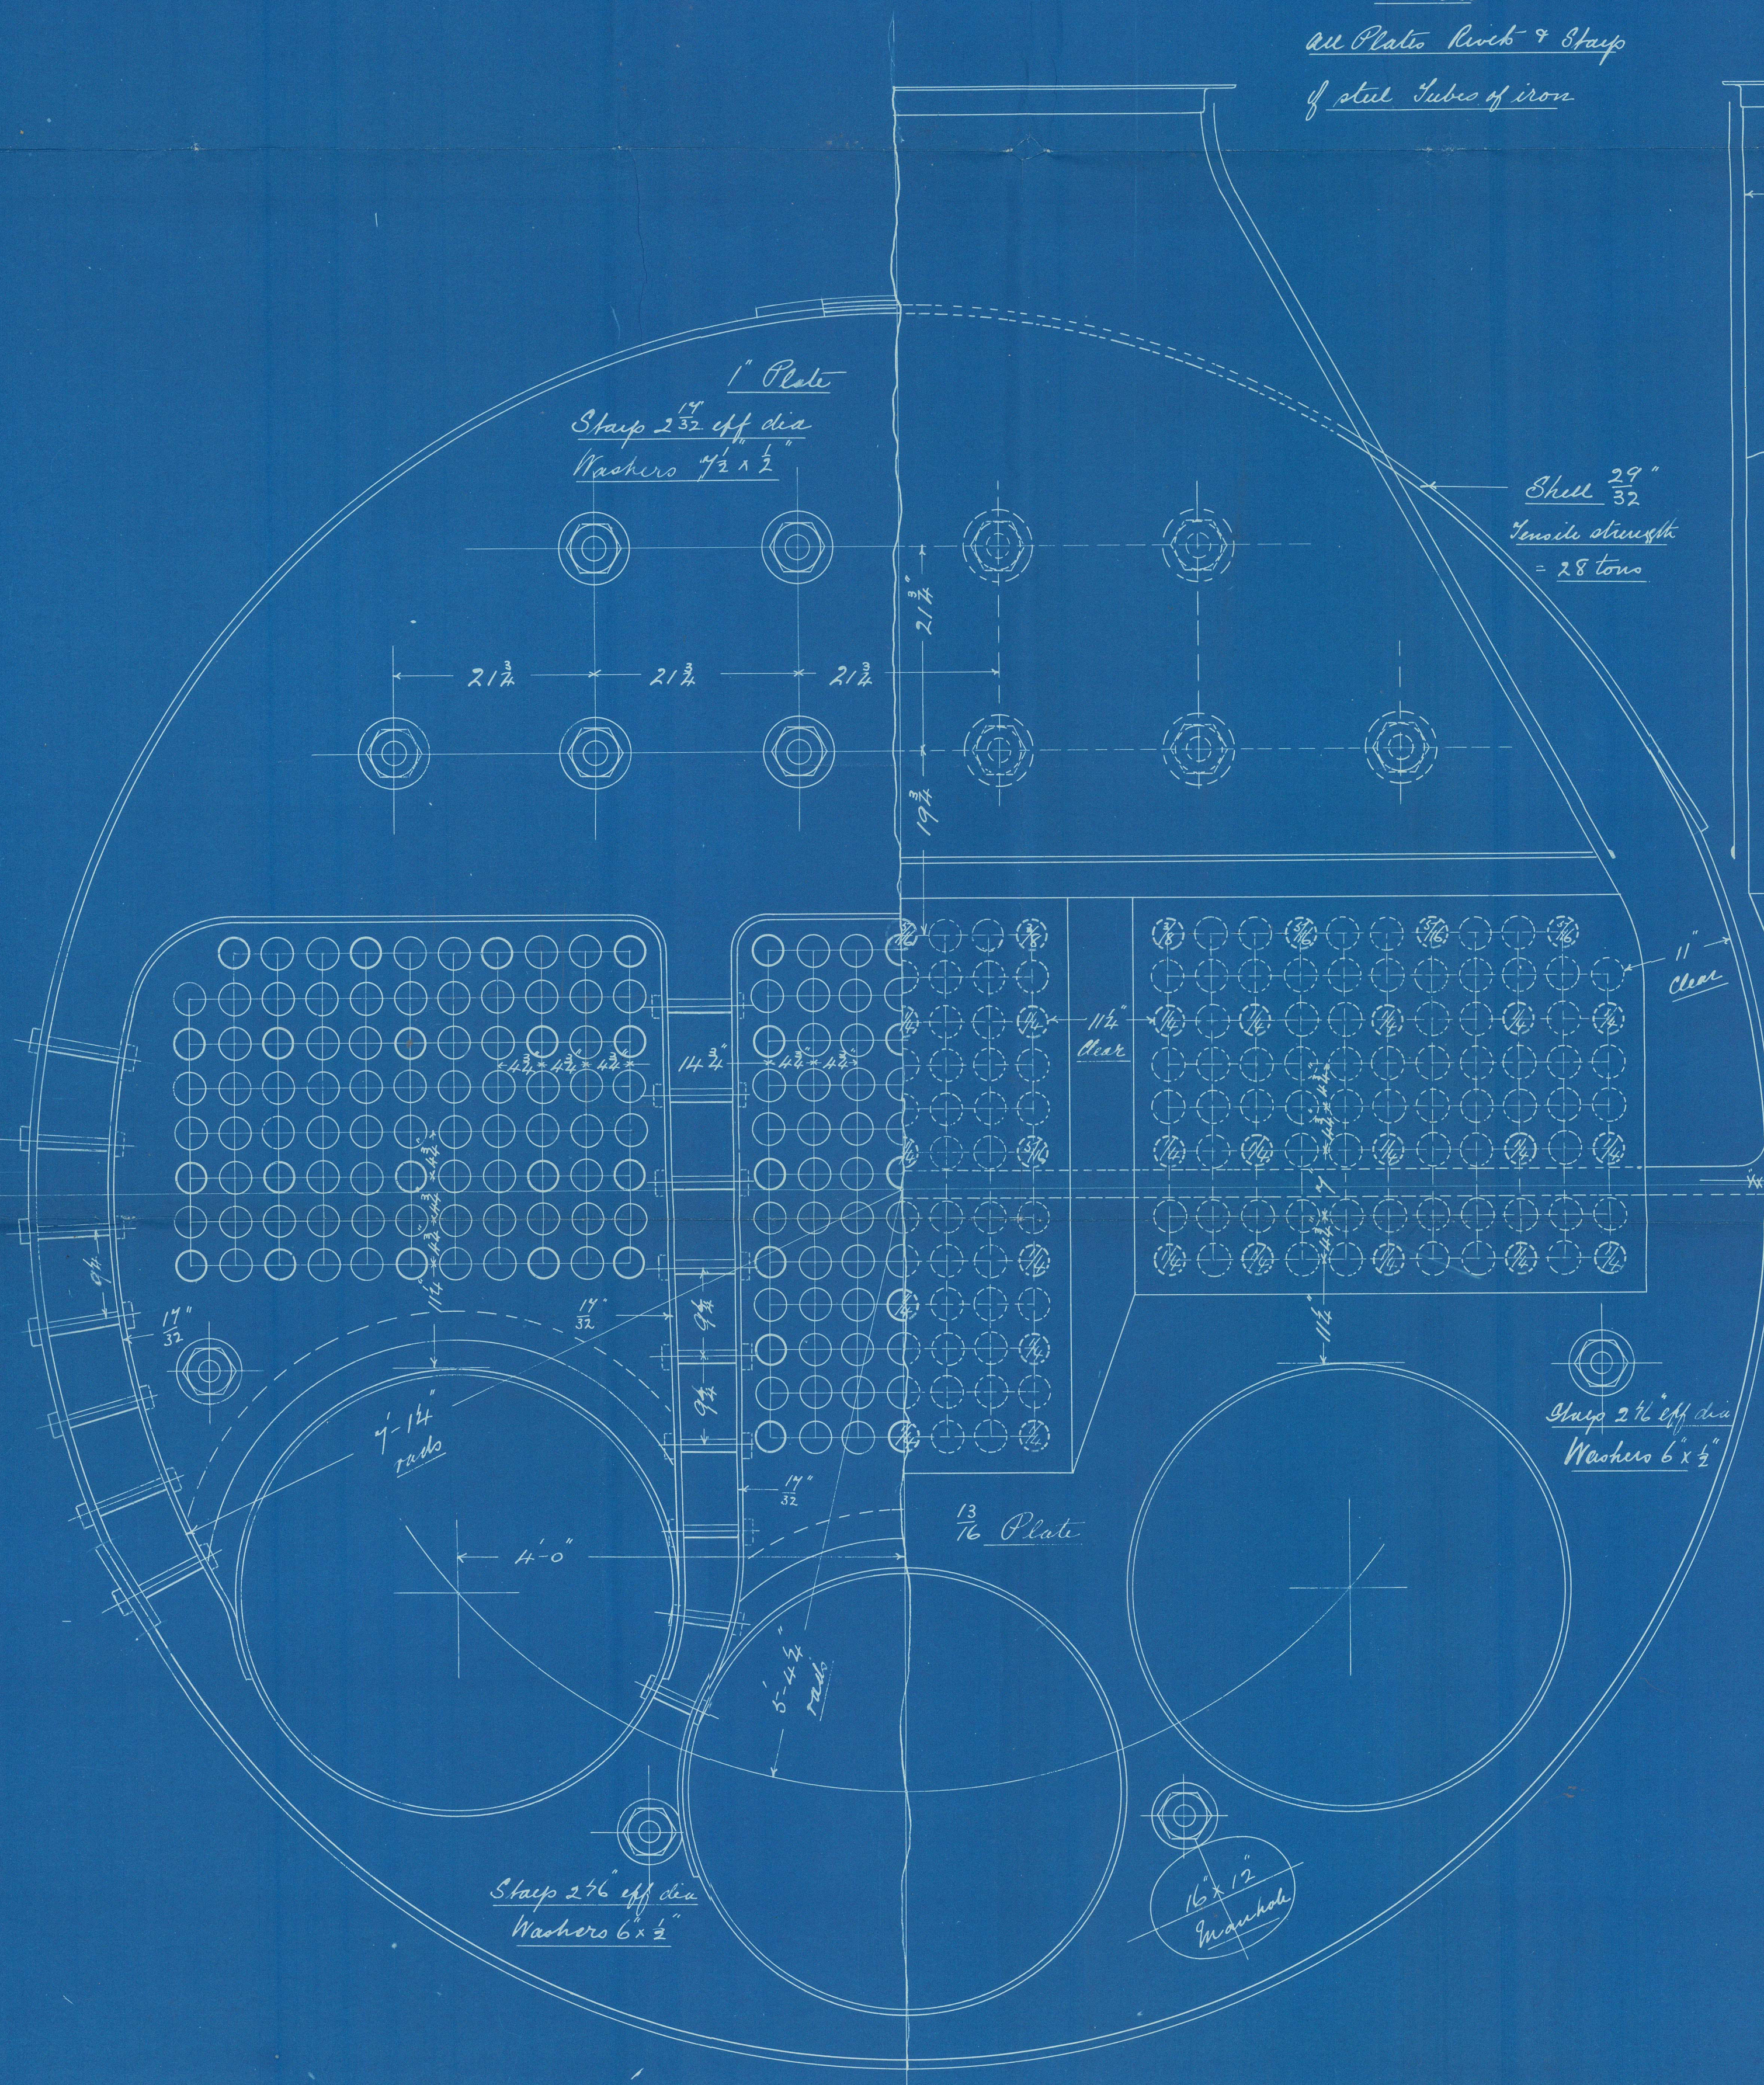


Heating Surface

Tubes	1661	sq. feet
Furnace	177	
C. Chambers	210	
Tube Plates	70	
Total	2118	

2 additional man stays to be fitted

Messrs Jos D. Eltringham's
Boiler N^o 1220
for s/s "Monarch"

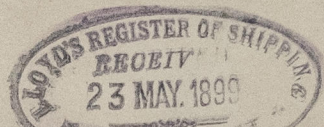

W.P. = 100 lbs

Tensile of shell 28/32 tons

5723

2 00

27- 2. 00

T. N. W.

S.S. Monarch

Newcastle Report

N^o 40318

L.R.


20/5/99



© 2021

Lloyd's Register
Foundation

0100-2F87MN

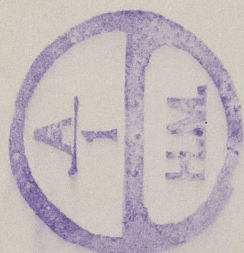

© 2021

Lloyd's Register
Foundation