

Received at _____ Office, _____ 189.

Lloyd's Register of British and Foreign Shipping.

(Report on Vessel No. _____ Port *Newcastle-on-Tyne.*)

No. *5685* SHIP FORGINGS OR ~~CASTINGS~~.

I have to report that the undermentioned Iron or Steel Forgings ~~or Castings~~,
 manufactured by *Messrs W Cleland & Co*
 of *Wellington Quay* for the Vessel No. *640*, being built
 by *The Smiths & Co* of *North Shields*
Mr Milton have been inspected by me as set forth below, and found to be, so far as can be seen,
Sound

The words FORGINGS or CASTINGS, IRON or STEEL, should be struck out as may be required.



Mark on Forgings.

Lloyd's
 No. *10197B*
JS

John Craig
Newcastle
21.9.00


	STERN FRAME.	RUDDER FRAME.	STEM.
Material*	<i>Scrap</i>	<i>Scrap</i>	/
How made	<i>Forged</i>	<i>Forged</i>	
Dimensions	<i>6 - 2 1/2</i>	<i>4 - 2 1/2</i>	
Progress on Inspection	<i>Forged & Smithed</i>	<i>Forged & Smithed</i>	
Date when Inspected	<i>April 6 to 24/00</i>	<i>July 10 to</i>	
		<i>August 2/00</i>	

SKETCHES OF FRAMES SHOWING POSITION AND DESCRIPTION OF WELDS OF FORGINGS, OR PARTICULARS OF TESTS APPLIED TO CASTINGS.

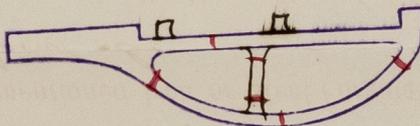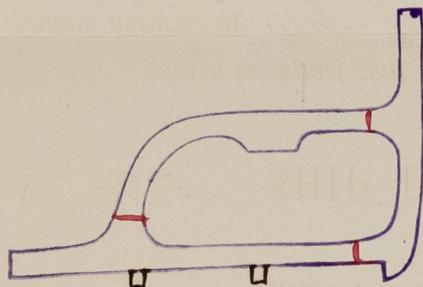

Fee (if any chargeable) £

To be paid at

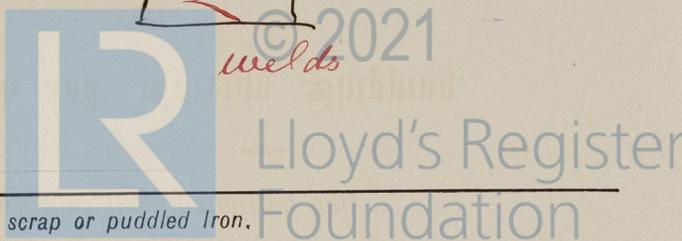

Messrs Smiths Dock & Co Ltd
No 640 vessel.

J.P. Inman

Newcastle Report

No 140850

[Faint, illegible handwritten text, possibly bleed-through from the reverse side of the page]



© 2021

Lloyd's Register
Foundation