S. S. "INGELI"

PROPOSED STRENGTHENING IN WAY OF CARGO DOORS.

SCALE 3/4" = 1 FT.

8.4.14
DOUBLING INCREASED IN THICKNESS TO ·7

DOUBLE ANGLES 3½ × 3½

T BULB.

FLANGED SHELF PLATE ·6 THICK TAKING 3 BEAMS

BULB SCARPHED OFF IN WAY

OPENING 5'-9"

PLAN VIEW

Angle on Plate

FLANGED SHELF PLATE ·6

Web

Web

LONGL SECTION

·6 PLATE

DOUBLE LUGS TO BEAM

BULBS SCARPHED OFF BEAMS IN WAY OF LUGS

Web

Web

C.J.
8.4.14

NWC876-0087

Proposed Strengthening
way of Cargo doors
S.S. Ingelo

Rec. 2/51.
No. 66263

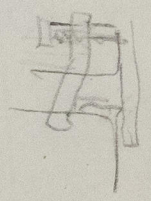

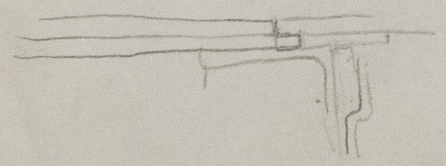

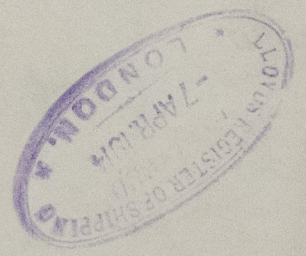

NWC876-0087

© 2021
Lloyd's Register
Foundation