


146.99



Half beams to every frame on way of open so unless deck is wood sheathed  
Rivets through beams and deck plating where beams are fitted to alternate  
frames to be spaced not more than 12 ft apart center to center

THE WM. CRAMP AND SONS' S. & E. B. CO.  
OFFICE OF CONSTRUCTION DEPARTMENT PHILADELPHIA, PA.  
**HULL N° 304-306**  
TWIN SCREW P. & F. STEAMERS FOR THE OCEANIC S. S. CO.  
SKELETON PLAN  
ARRANGEMENT OF BULKHEADS.  
DRAWN BY J. PLATT CHECKED BY H. COOPER  
DATE MAY 24 1899 SCALE 1/4" = 1 FOOT  
INSPECTOR'S SIGNATURE *[Signature]* CONTRACTOR *[Signature]*

 


Profile & Plans.

N. 304-5-6.

W. Cramp & Sons Sd L. Dk.

Report N° 965-

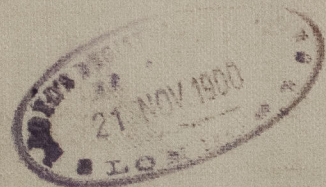

PH 1132/40



© 2021

Lloyd's Register  
Foundation