


N<sup>o</sup>. 304 - 305. The W. Grange, Sons S & L. B. Co.  
Compensation on alternate Frames under Boiler Space.

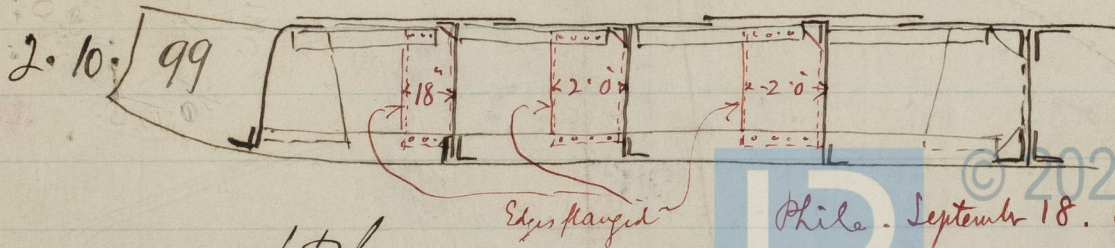

J. P. L.  
2/10/99

Phila. September 18. 1899 -

John Bay, Surveyor.



© 2021

Lloyd's Register  
Foundation

PHILIP/91