




Aones Seed
Ply 4210.


PLY888-0290



© 2021

Lloyd's Register
Foundation

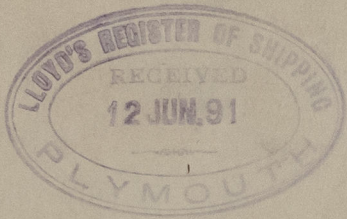

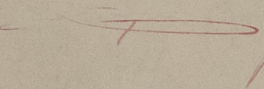Amended tracing


0290



© 2021

Lloyd's Register
Foundation