

W. G. Rob
30/1/83

29/1/73.

MAATSCHAPPIJ „DE MAAS“
 DELESHAYEN.


Boiler for Screw Steamship No. 53.
for Royal Netherlands Steamship Co.^{ys} of Amsterdam

Scale 1" to a foot.



"Saturnus"
Not. N^o 683.

Twisting of dome.

Riveting of shell.

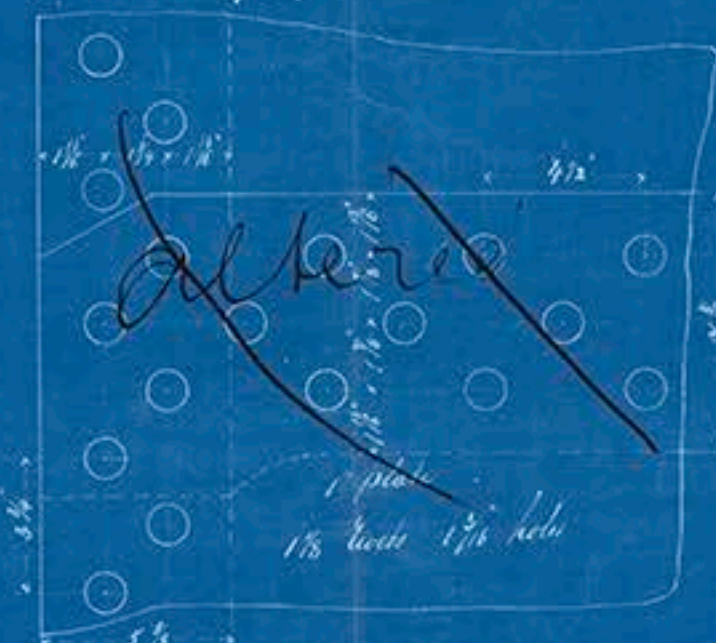

Working pressure
74.9 lbs. per sq. in.

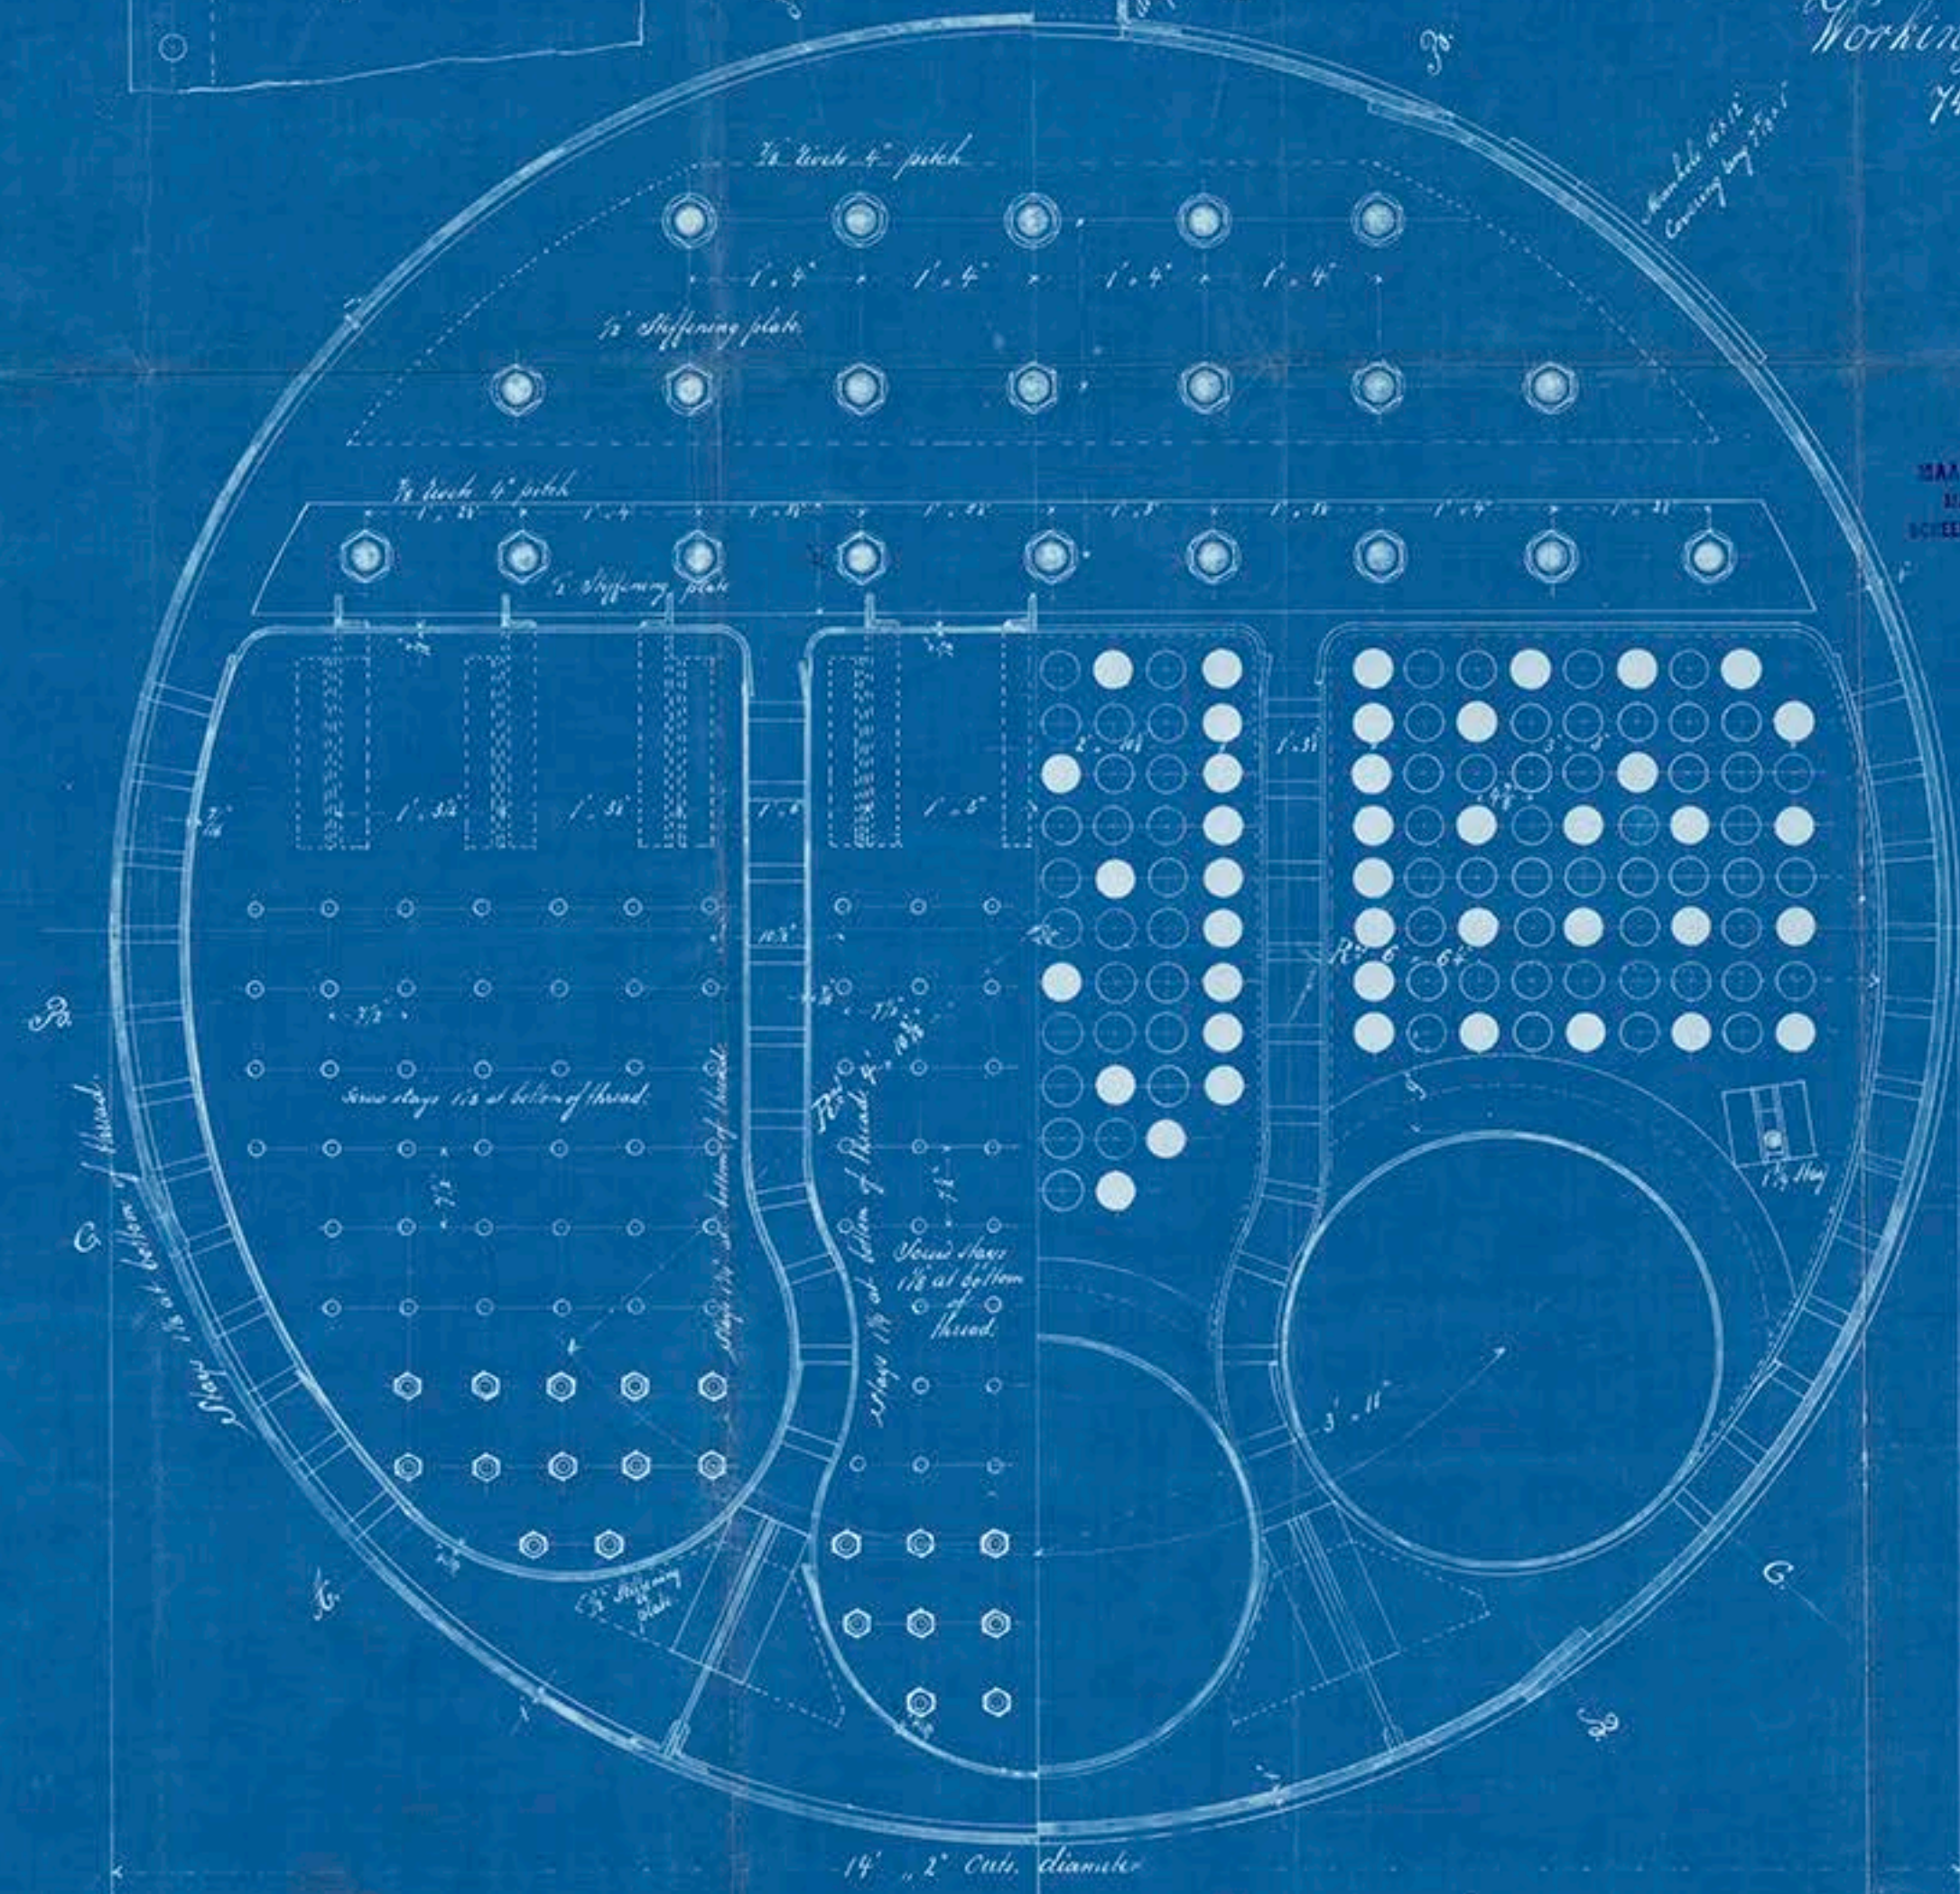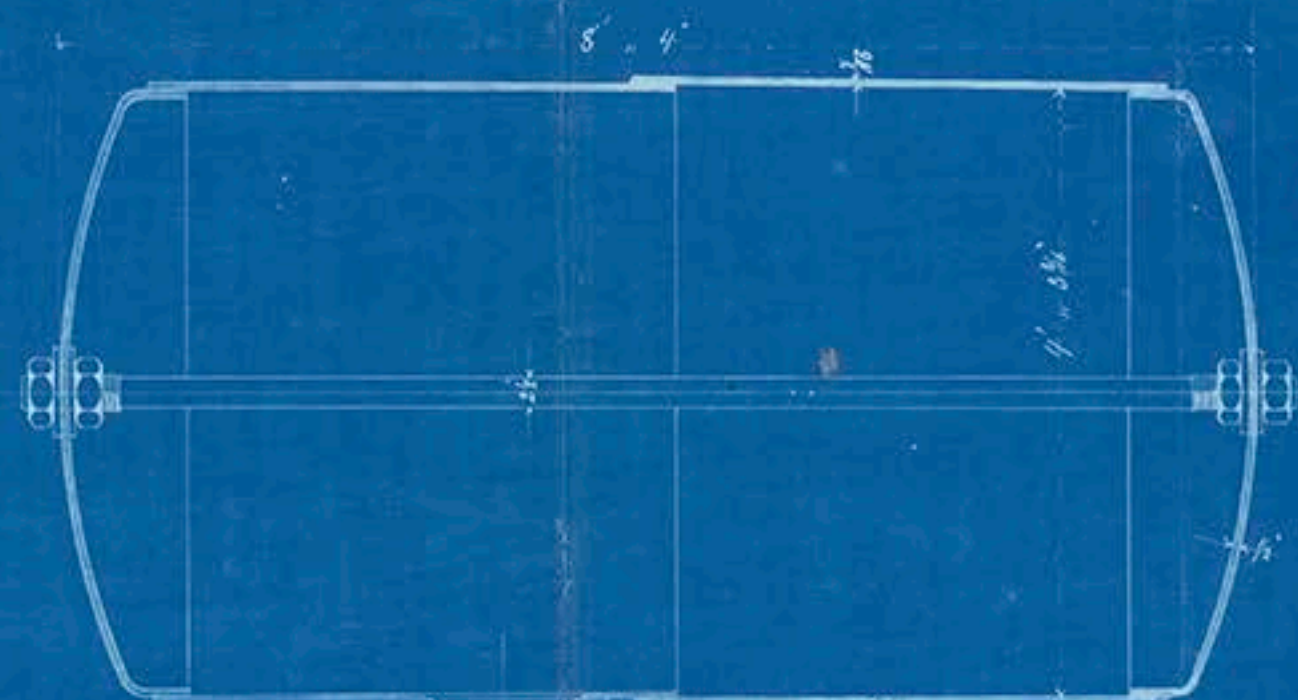

MAATSCHAPPIJ „DE MAAT“
DELFSHAVEN.