Ltr. D Rott.
24/10/83
1/11/83.
20/11/83.

Rotterd. Port No 44

Proposed arrangement for Cargo hatches

Scale ¼ inch = 1 foot.

N.A. N° 54.

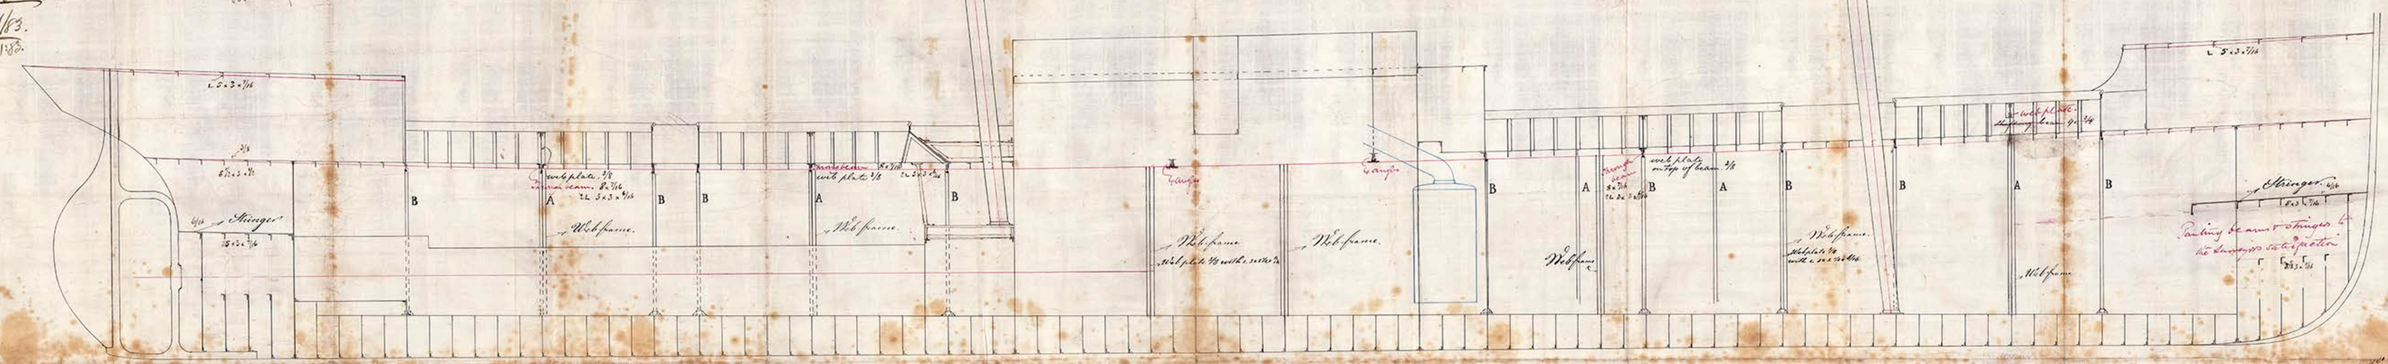
Cargo
Cargo
Stringer
Stringer
Web frame
Web frame
Web frame