Elevation and Plan of an Iron Screw Steamer No 40 Class 100 A1 Lloyds (Special Survey)

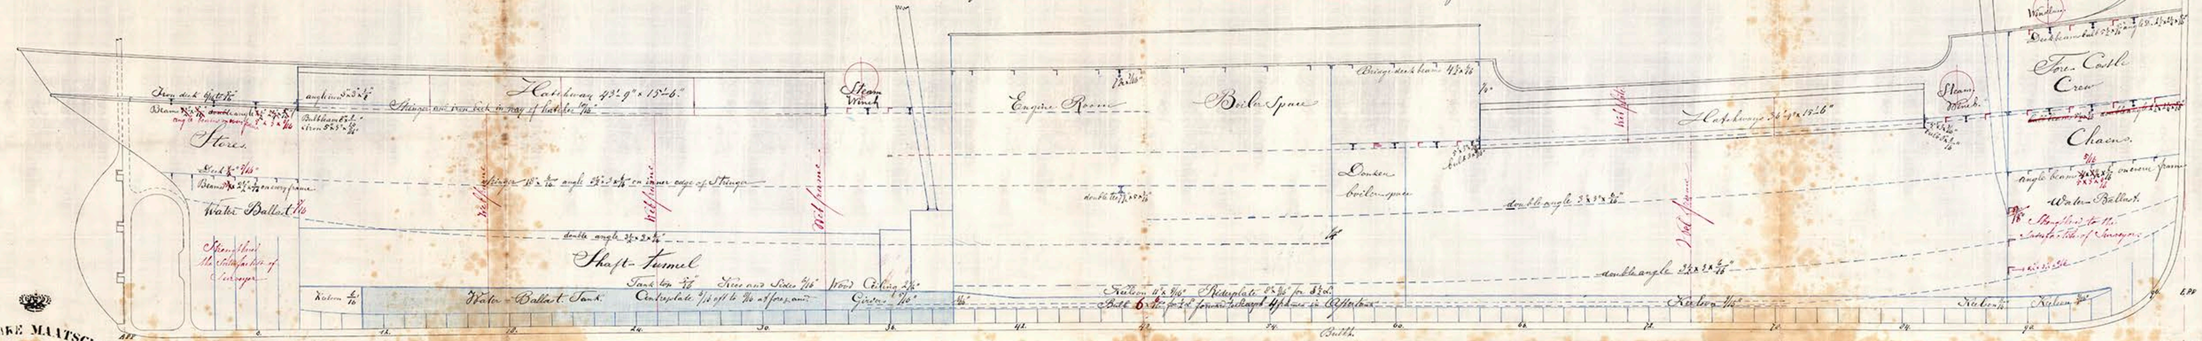
Stores
Hatchway 43'-9" x 15'-6"
Engine Room
Boiler Space
Hatchway 36'-9" x 13'-6"
Fore Castle
Crew
Chains
Shaft Tunnel
Water Ballast
Water Ballast Tank
Steam Winch
Steam Windlass
Bridge deck beam 43 5/16
Double angle 3 1/2 x 3 1/2 x 7/16
Double angle 3 1/2 x 3 1/2 x 9/16
Keelson 44 x 7/16 Plate 8 1/2 x 7/16 for 8 3/4
Keelson 44 x 7/16
Stringer 18 x 7/16 with angle 3 1/2 x 3 1/2 x 7/16 on inner edge of Stringer

N° 110.—

© 2018
Lloyd's Register
Foundation