

Length	170' 0"
$\frac{1}{2}$ Breadth	12.50
$\frac{1}{2}$ Girth	24.70
Depth	14.67
W ^c for framing	51.37
" " Plating	2212.
" Equipment	9699.69
Length to Depth	11.59
" Breadth	6.22.


Sections, Fore and Aft.

Iron Screw Steamer No. 40.
Class 100 A.1. Lloyds - Special Survey.

Principal Dimensions

Length over all	179' 3"
id between perpendiculars	171' 2"
Breadth extreme	25' 6"
Depth of Hold	13' 6"
Depth moulded	14' 2 1/2"
Tonnage U. S. M.	518.

Wm. L. R. R.
24/4/02.

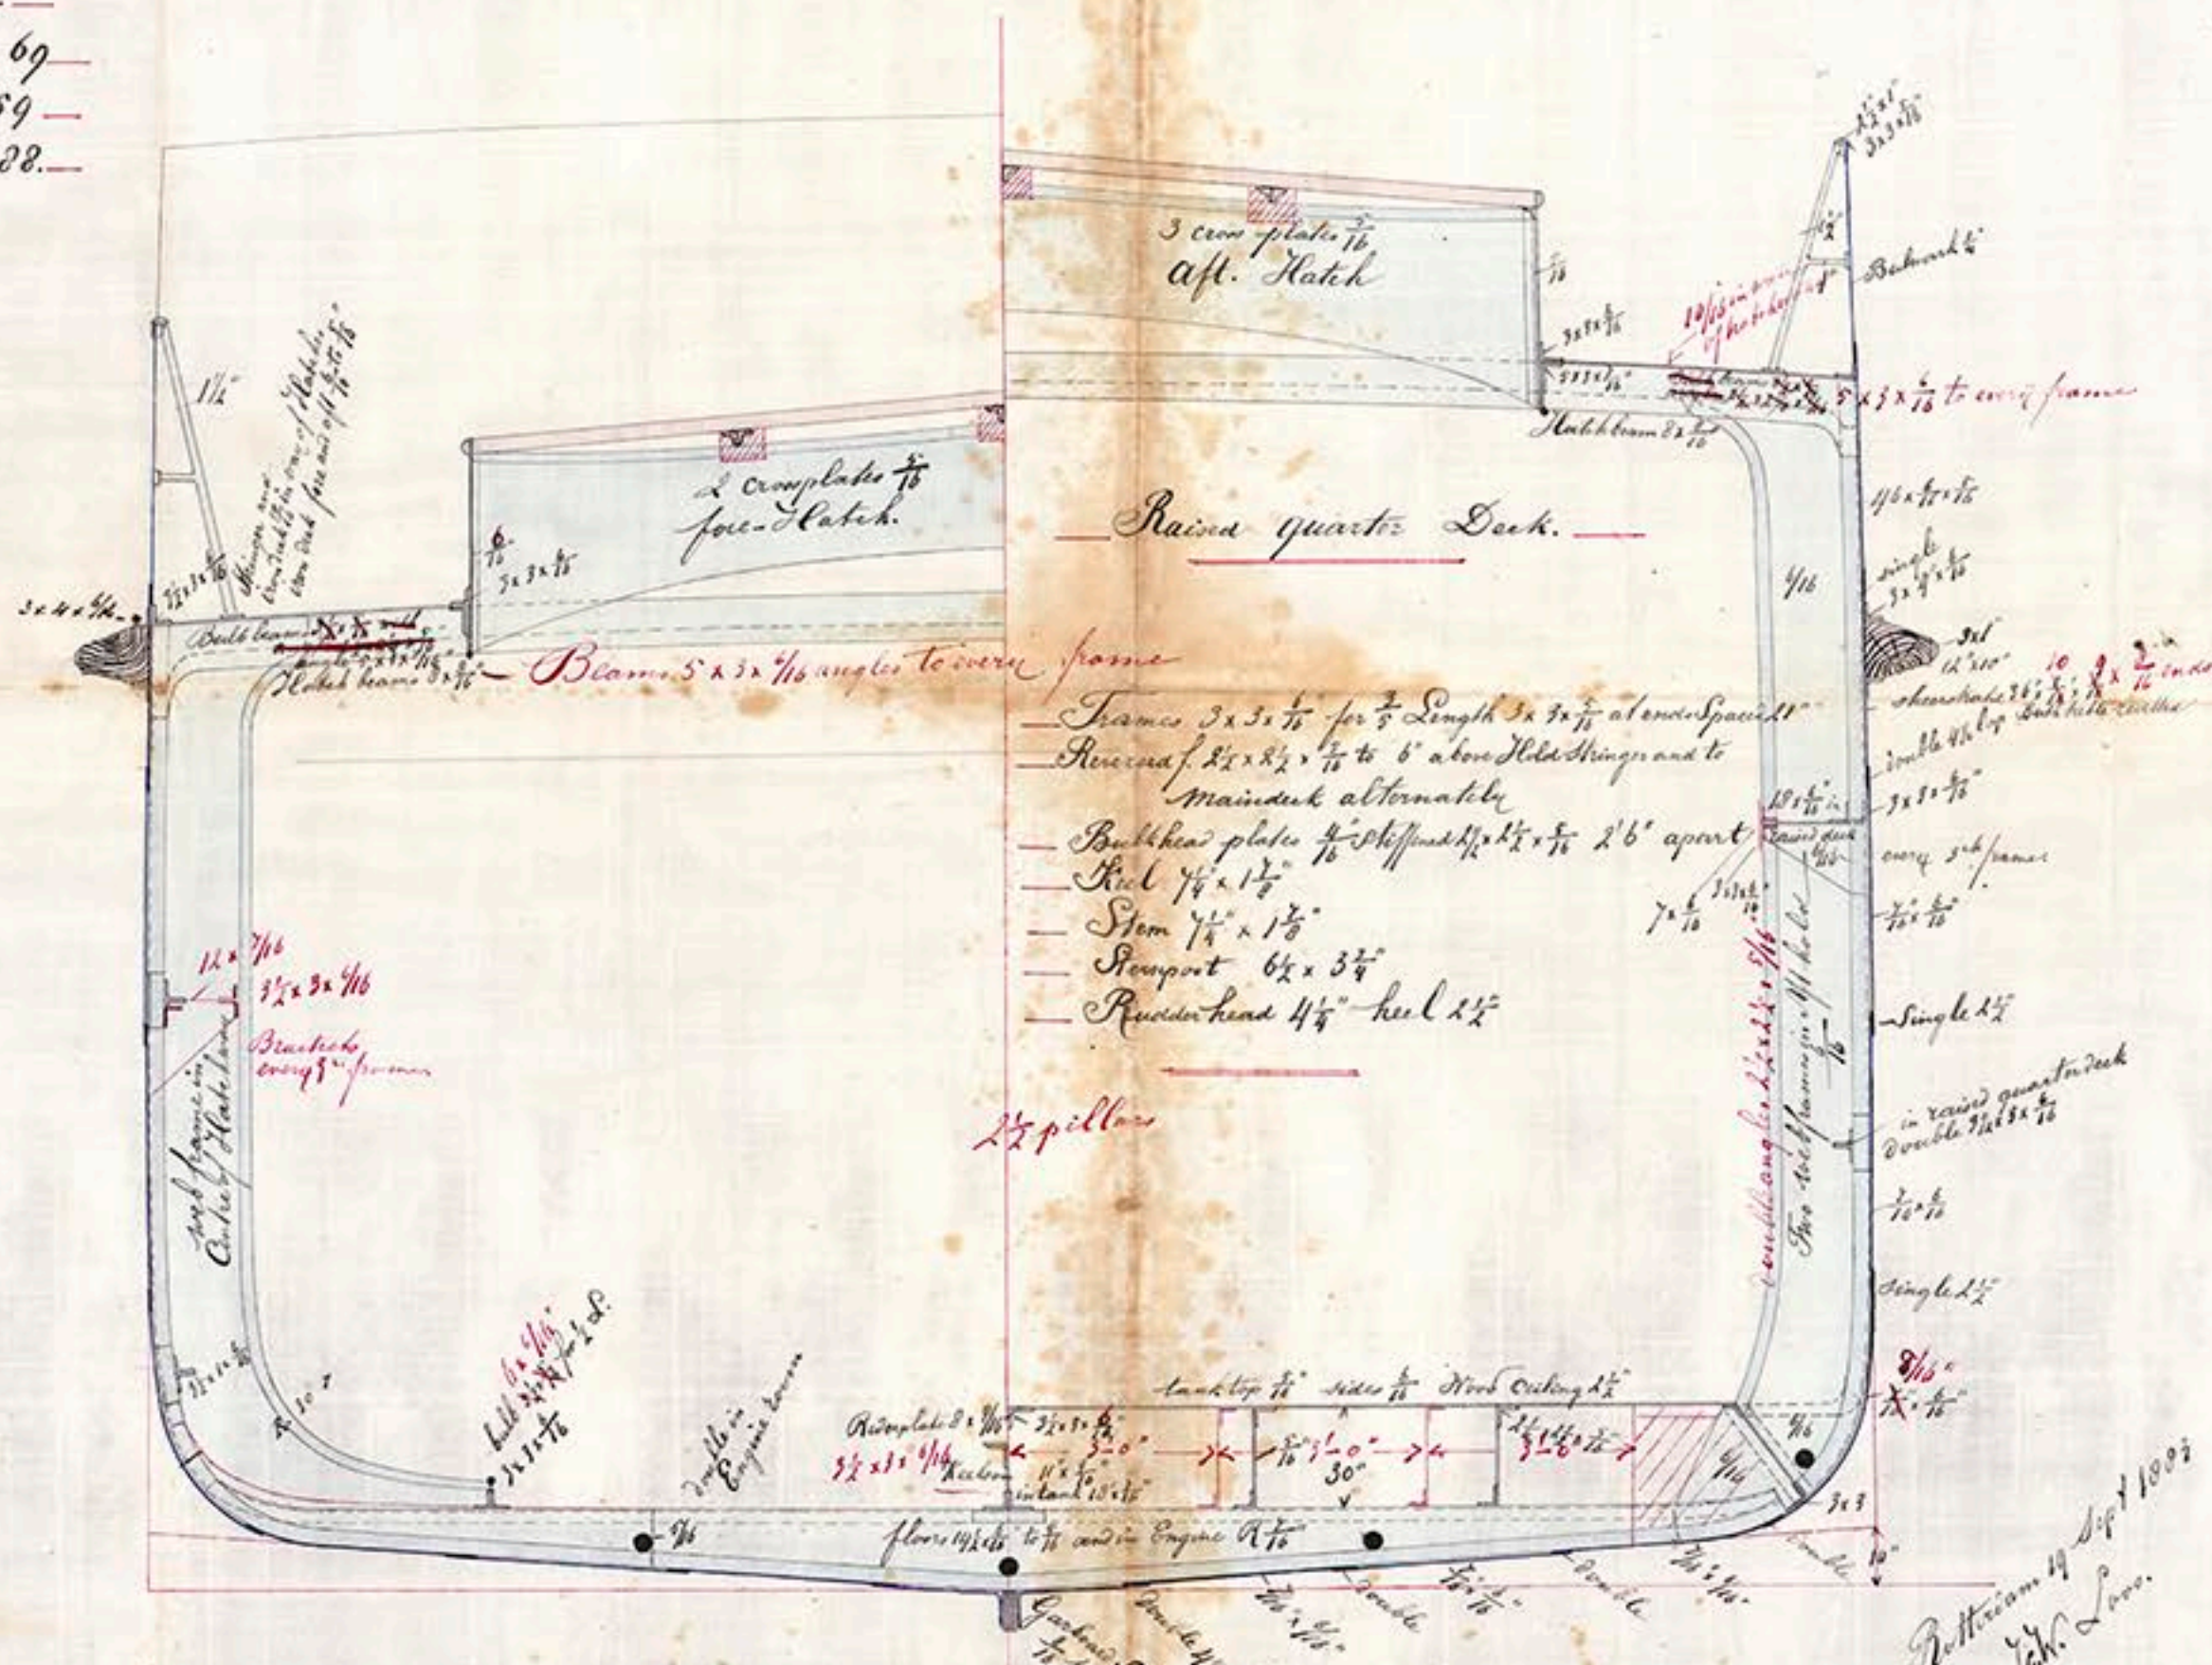

Scale 1 inch = 1 foot.


 two

twas get/ *AM*
24/10/83

15 Sept. 1983.



© 2018

Lloyd's Register
Foundation

