

241 - 1411

Machine Section
Iron Screw Steamer N° 41. 3 1/2.
Class 100 H. Special Steamer


Principal Dimensions

Length over all	185' 8"
in between Perpendiculars	177' 2"
Breadth extreme over frames	27' 0"
Depth of Hold	12' 5"
Depth moulded	13' 1 1/2"
Tonnage U.B.M	624

Proposed
 Ltr to Rot
 29/9/83

Cost for Steelings

Length	176
1/2 Breadth	13.50
1/2 Girth	24.78
Depth	13.62
Cost for Frames	51.90
Plating	9134.40
Equipment	10047.80
Length to Depth	12.92
in Breadth	6.52

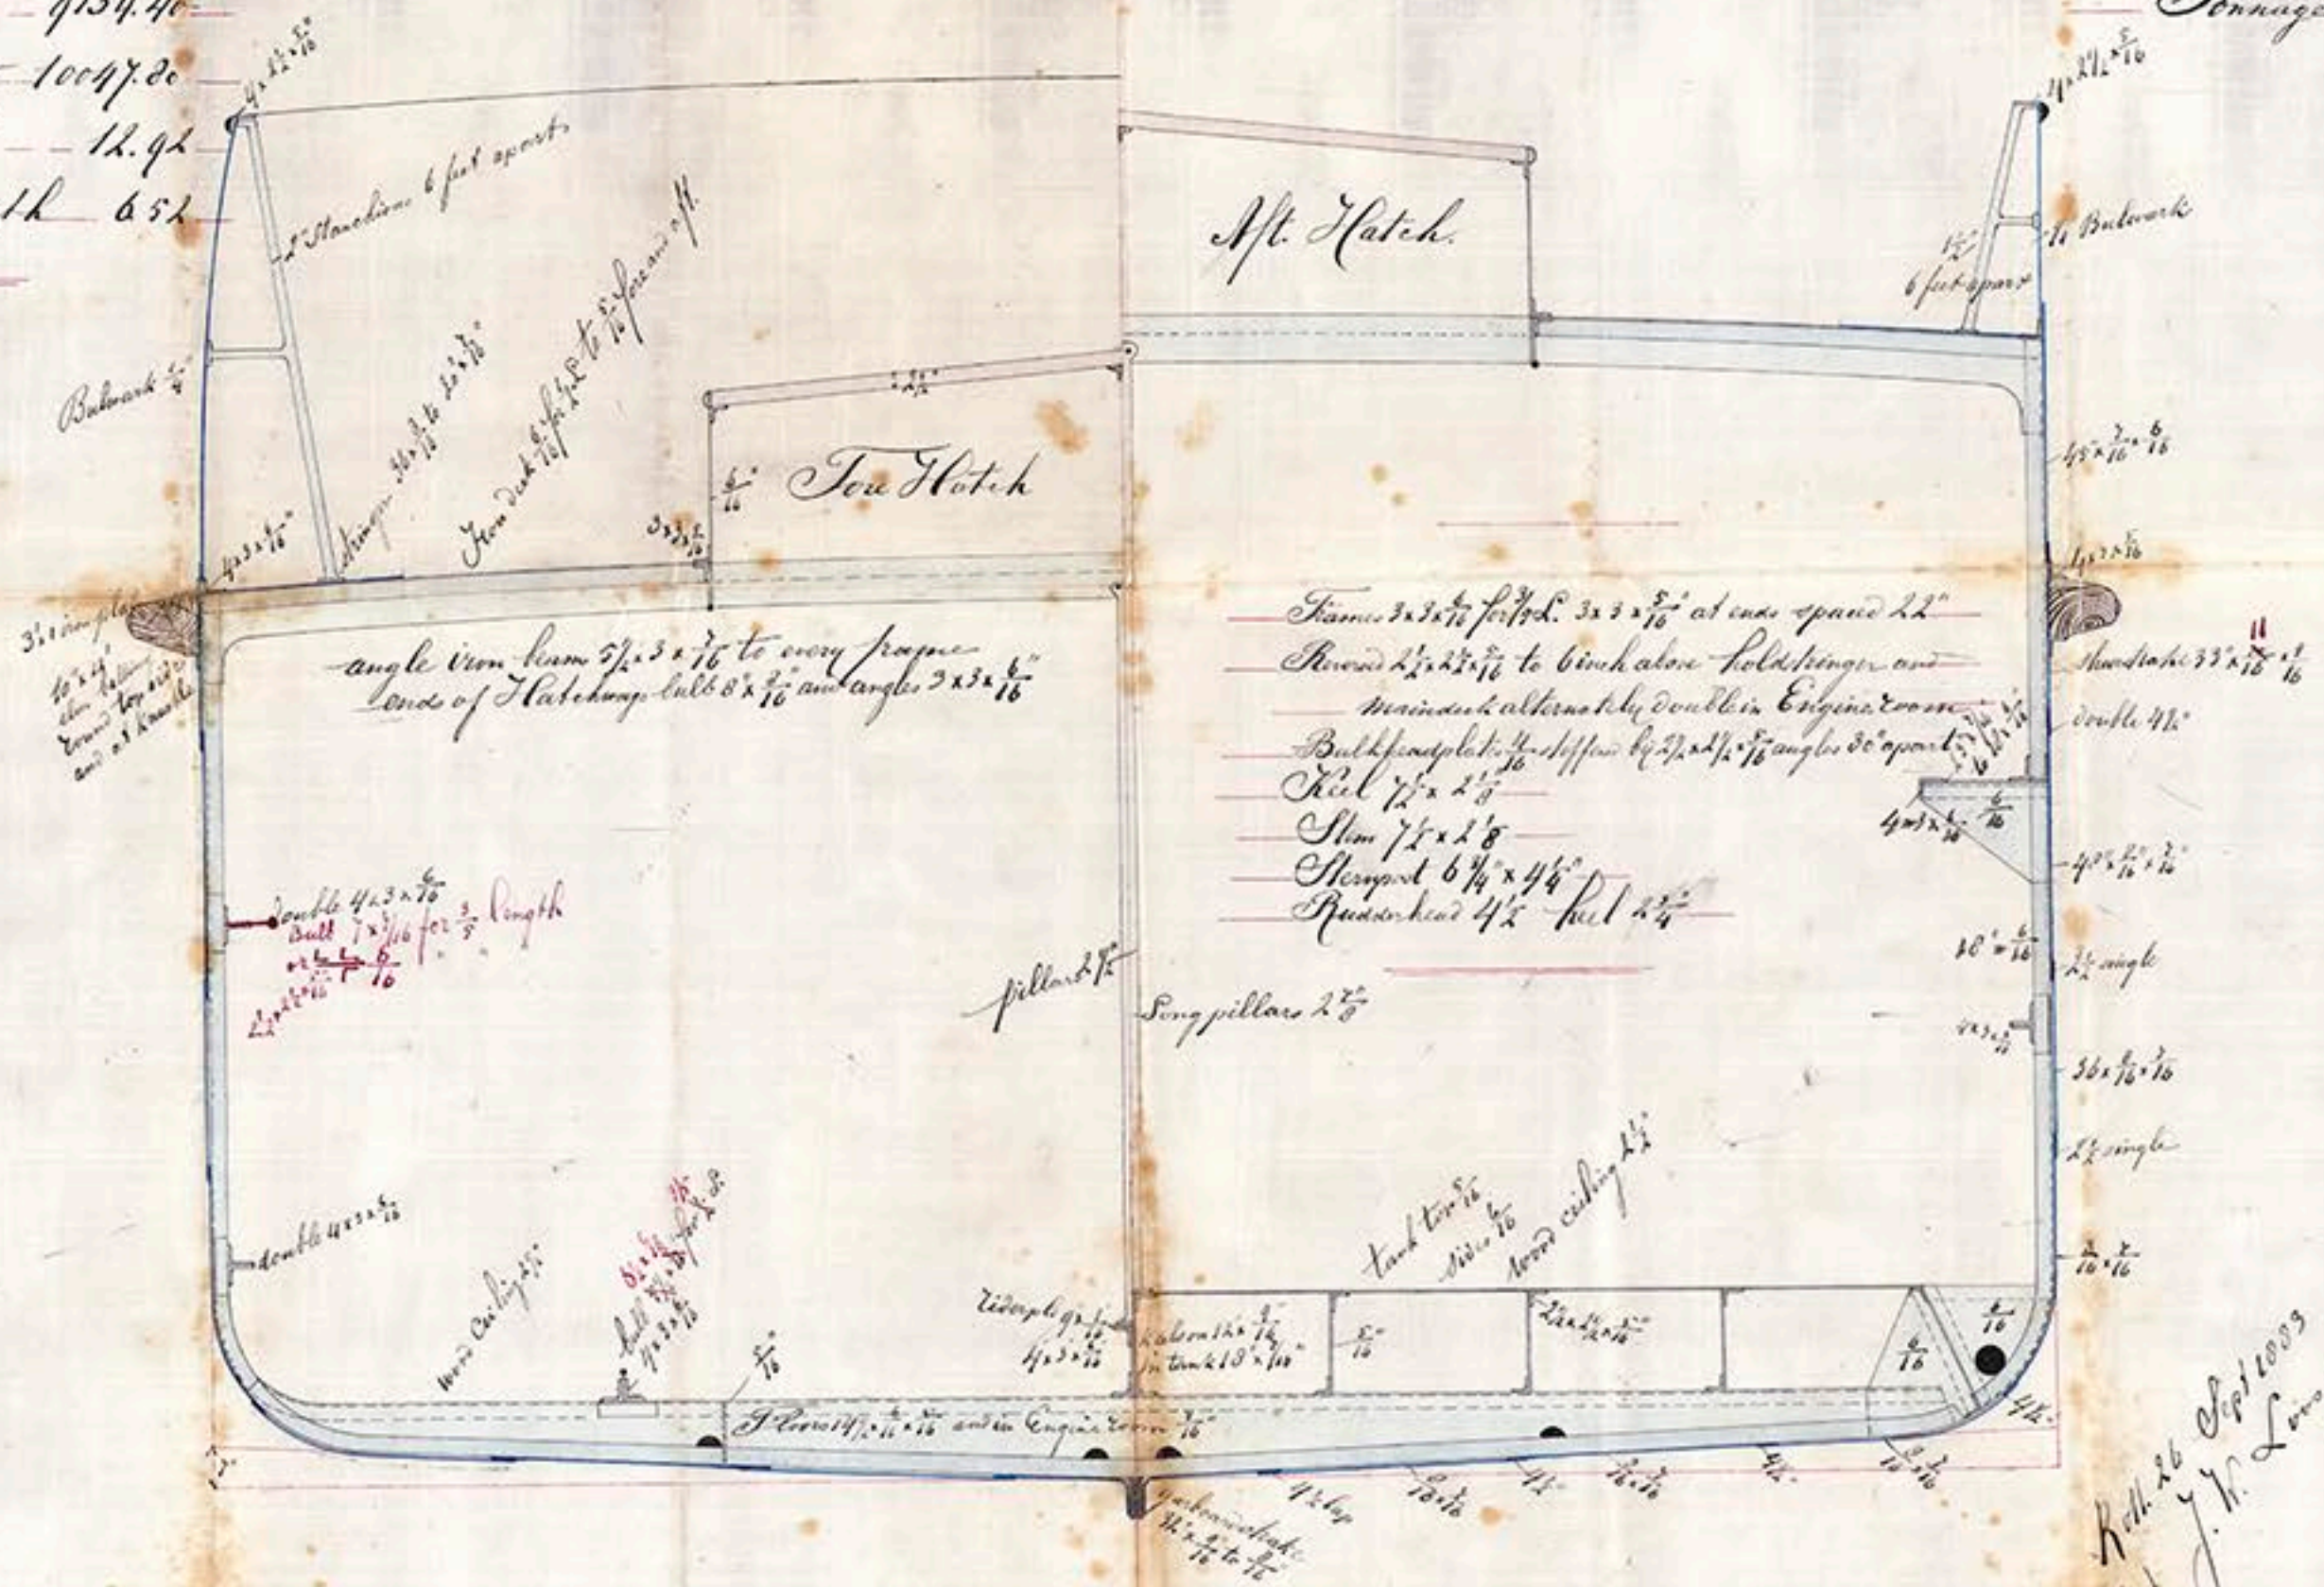

Scale 1/2 inch = one foot.

KONINKRIJKE MAATSCHAPPIJ
 DE SCHEDEL
 SCHEEPSBOUW EN VERSTUIGEN FABRIEK
 VLISSENGEN

Rotterdam 26 Sep 1883
 J. W. Looze

N 41 ~ 42.



1/2



© 2018

Lloyd's Register
Foundation