

No. for scantlings


Length	176
1/2 Breadth	13.50
1/2 Girth	24.78
Depth	13.62
No. for Frames	51.90
Plating	9134.40
Equipment	10047.80
Length to Depth	12.92
is Breadth	6.52

Midship Section
Iron Screw Steamer No. 42.
Class 100 A.1. Special Survey.


Principal Dimensions

Length over all	185' 8"
id between Perpendiculars	177' 2"
Breadth extreme over frames	27' 0"
Depth of Hold	19' 5"
Depth moulded	18' 1 1/2"
Tonnage O.B.M.	624

Stk 15
29/9/83

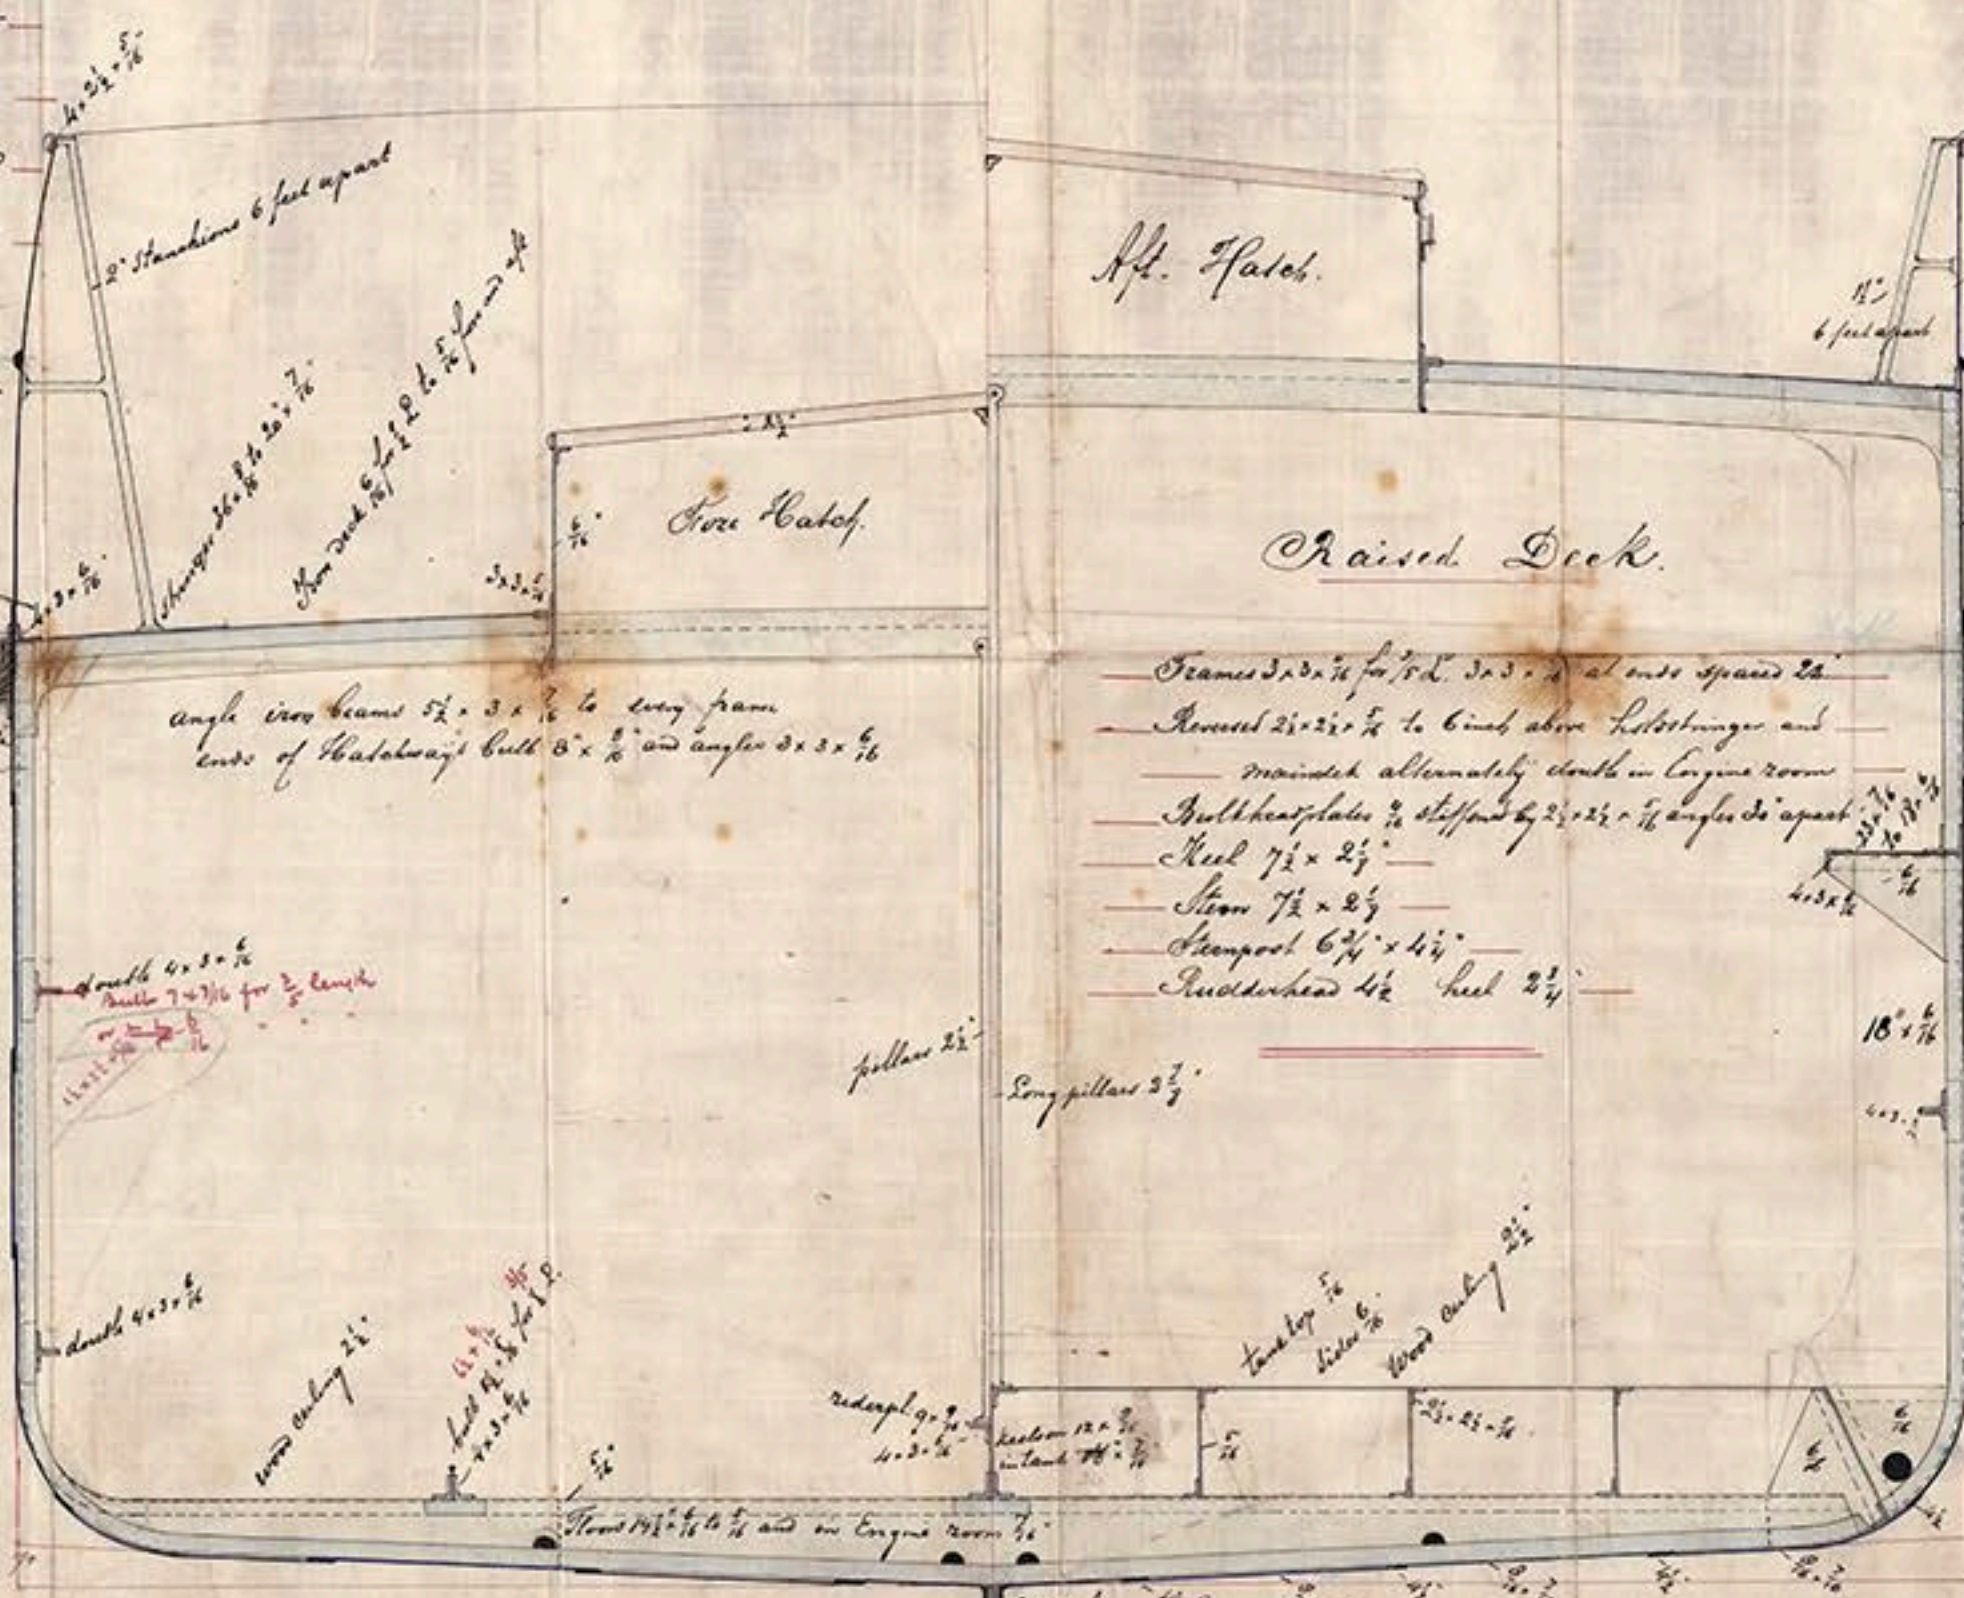

Bolting angle irons to be 5 x 5 x 7/8
double zig zag riveted
Calum bulkhead stiffened with
angle iron frames not more
than 2 feet apart & with
good bracket plates to secure
frames to deck thus

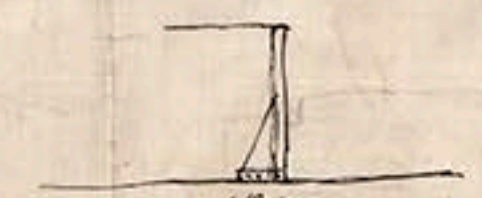

at least 3 painting beams
in fore peak
Butt straps of hatch
coarings inside
7/8/84.

Scale 1/2 inch = one foot

KONINKRIJKE MAATSCHAPPIJ
"DE SCHELDE"
SCHEEPSBOUW EN WERKTUIGEN FABRIEK

VLISSINGEN
28/9/83
Lloyd's Register
Foundation