


Elevation & ^{ms} Deckplan — Iron Screw Steamers No: 41 & 42 Class 100 A.1. Pajaro (Special Survey).

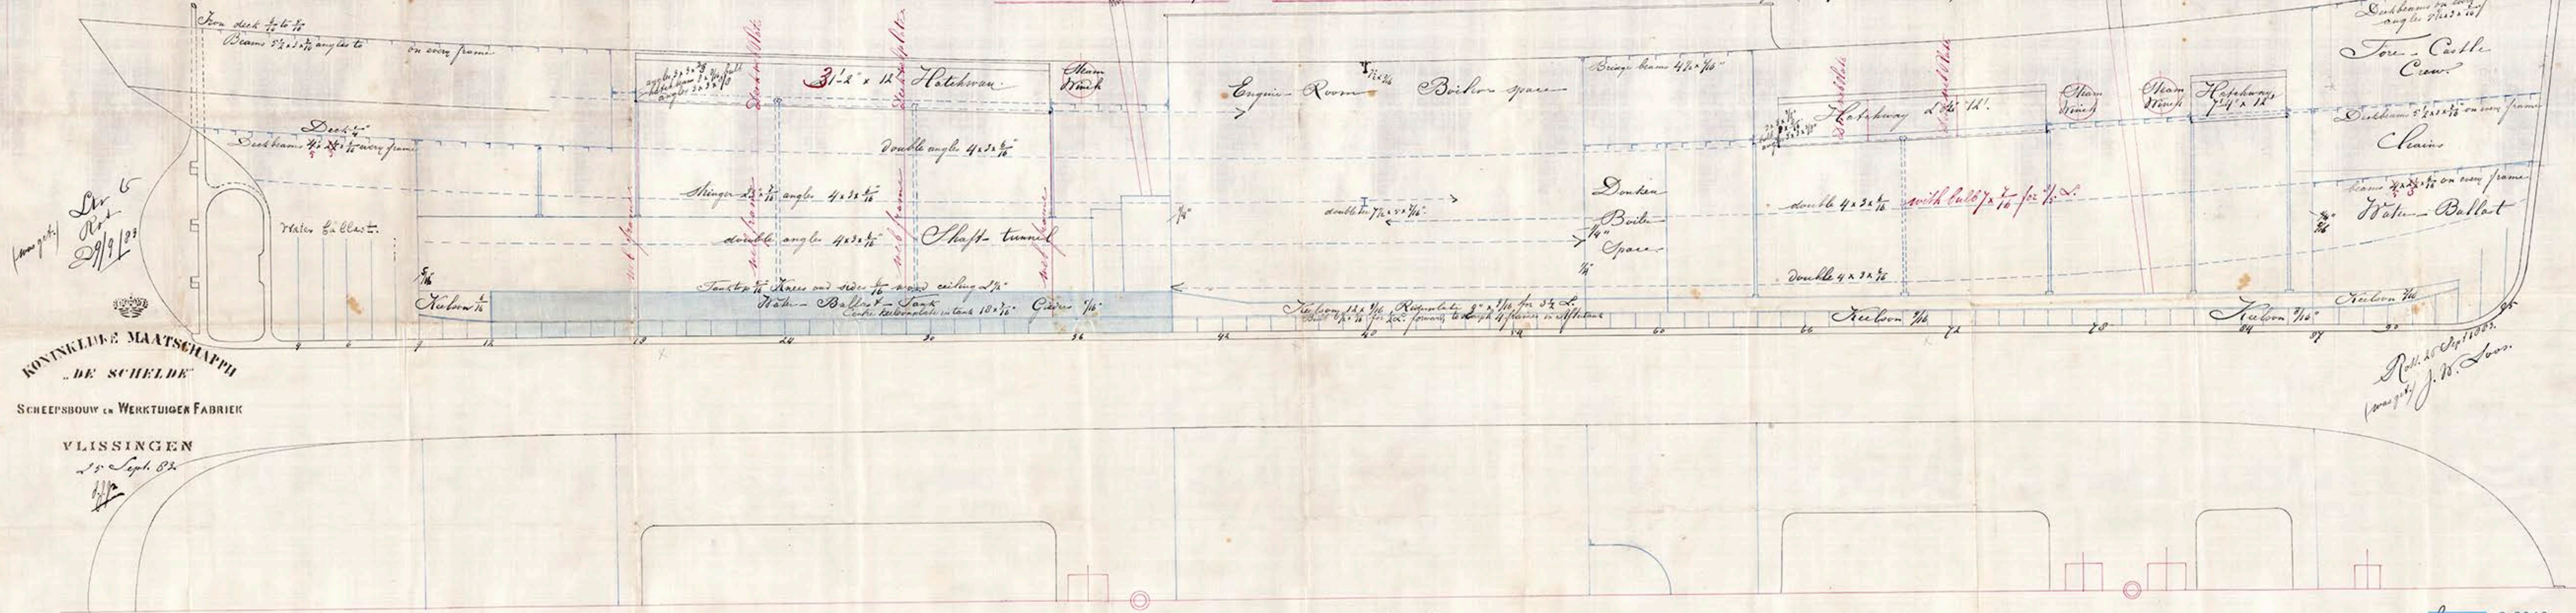

Scale $\frac{1}{4}$ " inch to the foot.

S.S. N° 41, 42.



© 2018

Lloyd's Register
Foundation