


offered and showed plan van Sloot  
 from sketch -  
 in accordance with the present plan.  
 J.M.

Elevation & Deckplan Iron Screw Steamer N° 417 <sup>42</sup> Class 100 A.1. Lloyd's (Special Survey)

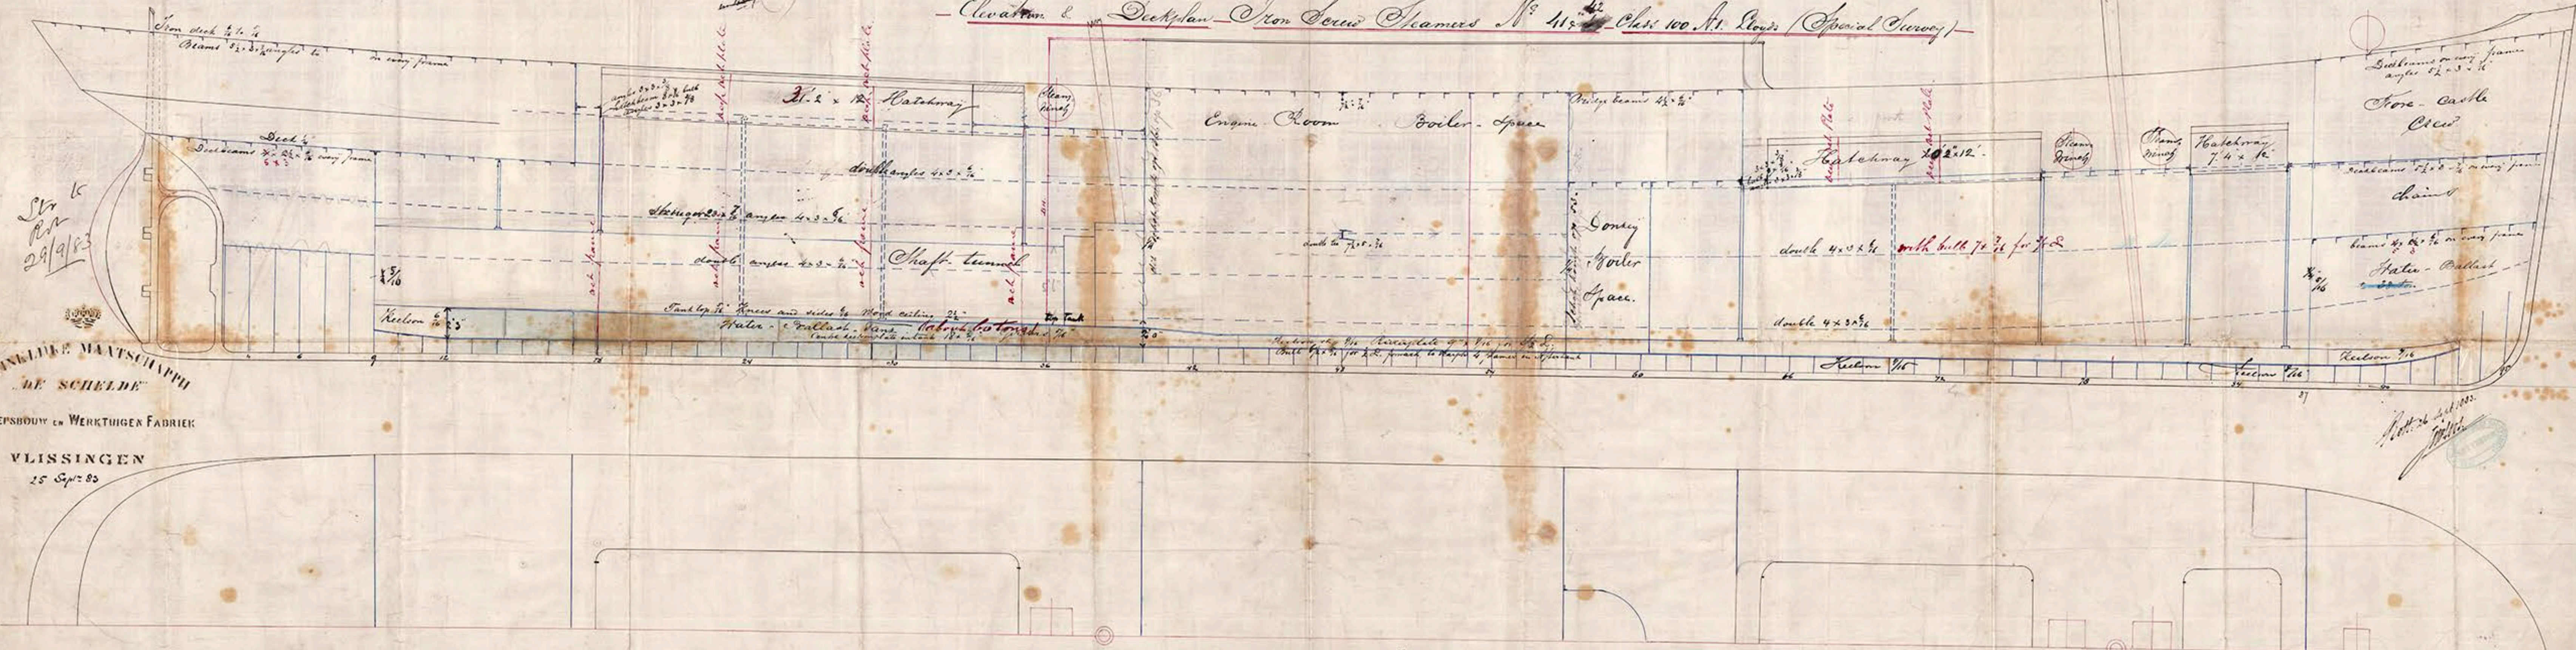

Scale 1/4 inch to the foot.

KONINKLIJKE MAATSCHAPPIJ  
 "DE SCHELDE"  
 SCHEEPSBOUW EN WERKTUIGEN FABRIEK  
 VLISSENGEN  
 25 Sept 83

Noted and  
 J.M.