28 MAR 84

Lr: to Rotterdam,
31st March, 1884.

Built at Slipkenweer.
Mr J. Smit, Jnr.

"Burgemeester van Vollenhoven"

Class 100 A1 at Lloyd's

Dimensions.

Length	120' 0"
Breadth	19' 0"
Depth	9' 9"

Scale ½ inch = 1 foot.

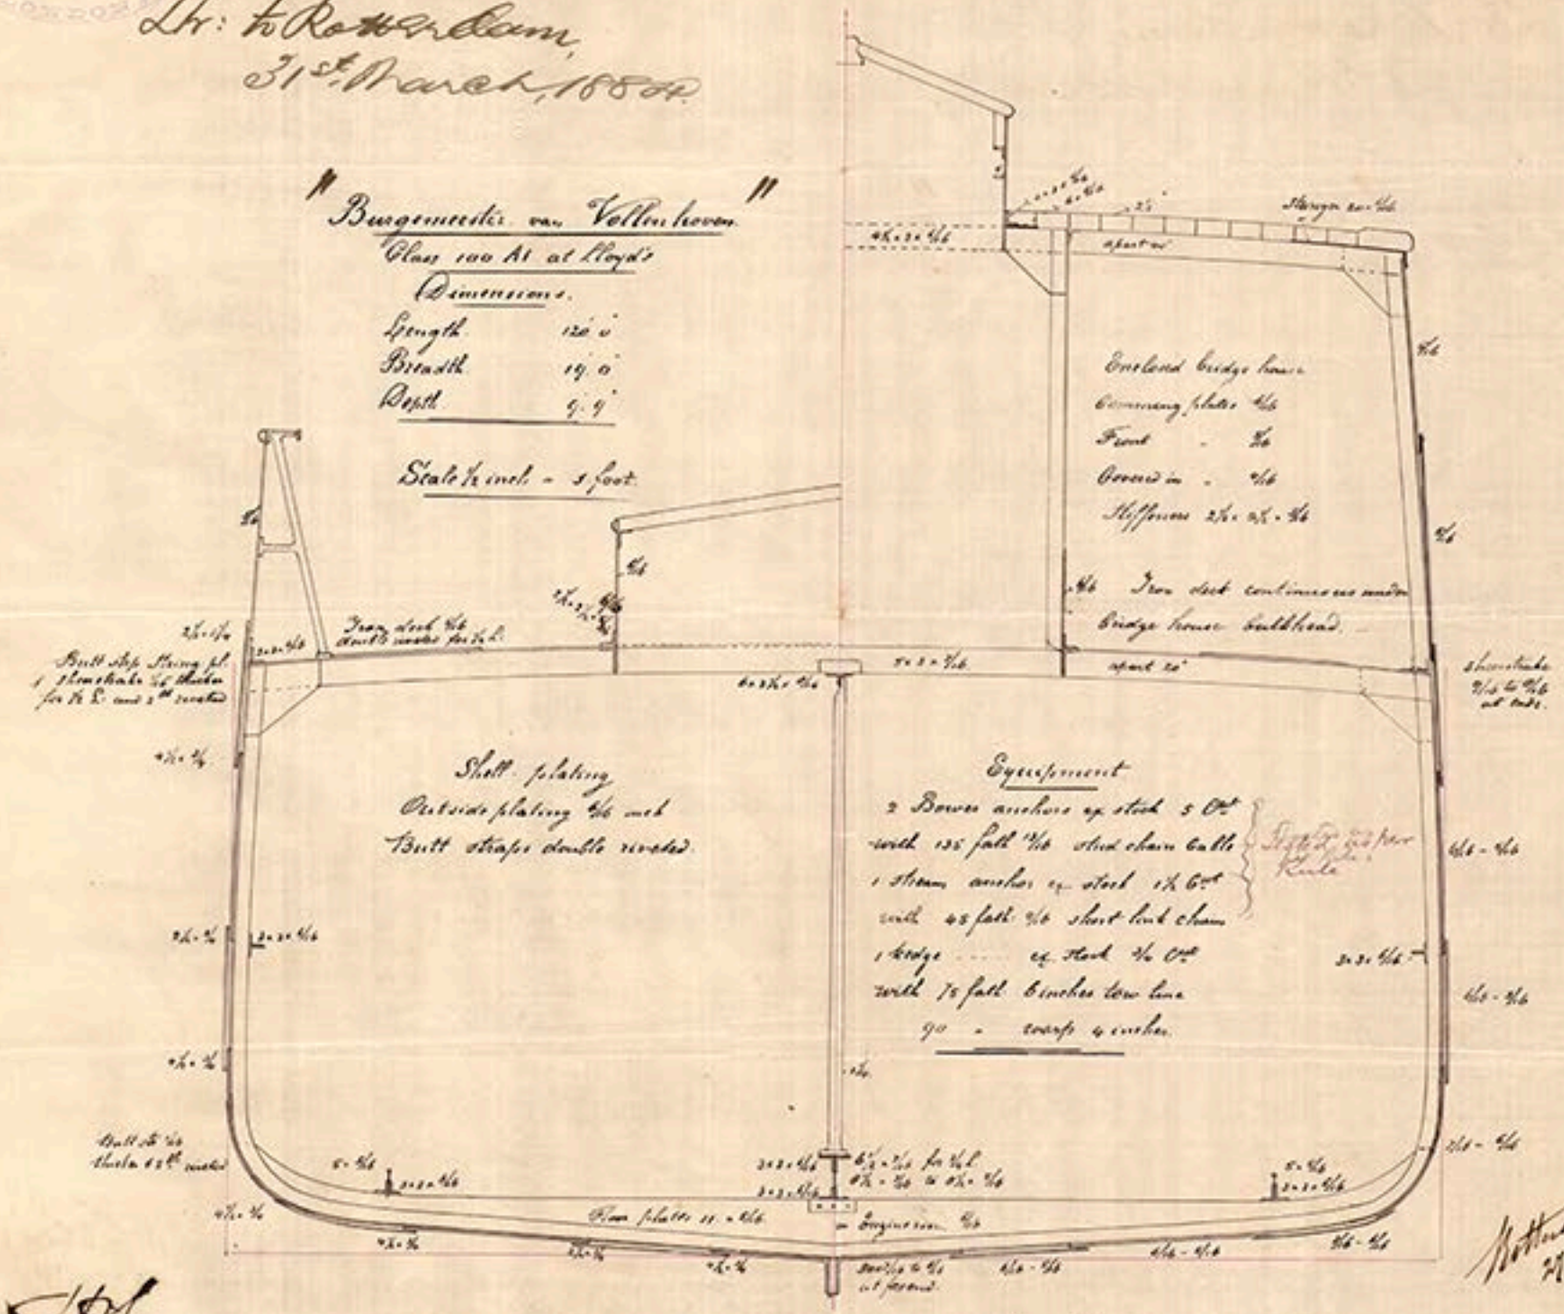

Numbers

Half Girth	17.1
" Breadth	9.6
Depth	9.9
Number for frames, &c.	36.9
" " plating	4428
Length to depth	12.3
" " breadth	6.2
Number for Equipment	4124

Frames spaced 20 inches
" 2½ × 2½ × ⅜
Beam Frames 2½ × 2½ × ⅜
extending alternately to gunwale
and top of angle iron on hatch stringer
Double reversed angle irons in engine & boiler room.
Bulkheads ⅜ Stiffeners 2½ × 2½ × ⅜
Bed stringer plates 10 × ⅜ to 15 × ⅜ at ends
Wooden ceiling in hold 2 inches
Pillars 2½
Keel 6½ × 1½
Stem 6 × 1½
Stem frame 6 × 2½
Rudder head 3½ heel 2"
Keelson 8½ × ⅜
Angle irons in hold and on deck stringer 3 × 3 × ⅜
Windlass spindle 2½ inch
" Main piece 13 "

Rotterdam 27 March 1884
J. W. Lod.

J.F.G. 29/3/84

J.F.G. 29/3/84

© 2018
Lloyd's Register Foundation