


9. 8. 97

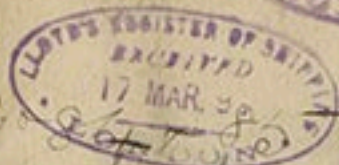

Profile Deck plan



Dyke & Co. No. 847

St. Kalabari No. 847
Ref. Report 2291



© 2018

Lloyd's Register
Foundation