

8-8-99

# Sketch of a Rudder and Stern-frame.


Scale 1 inch = 1 Foot.

Building number 182.

A. B. Ruyk Shipbuilder

Capelle 1/2 Y. Holland.

Section to B.C.

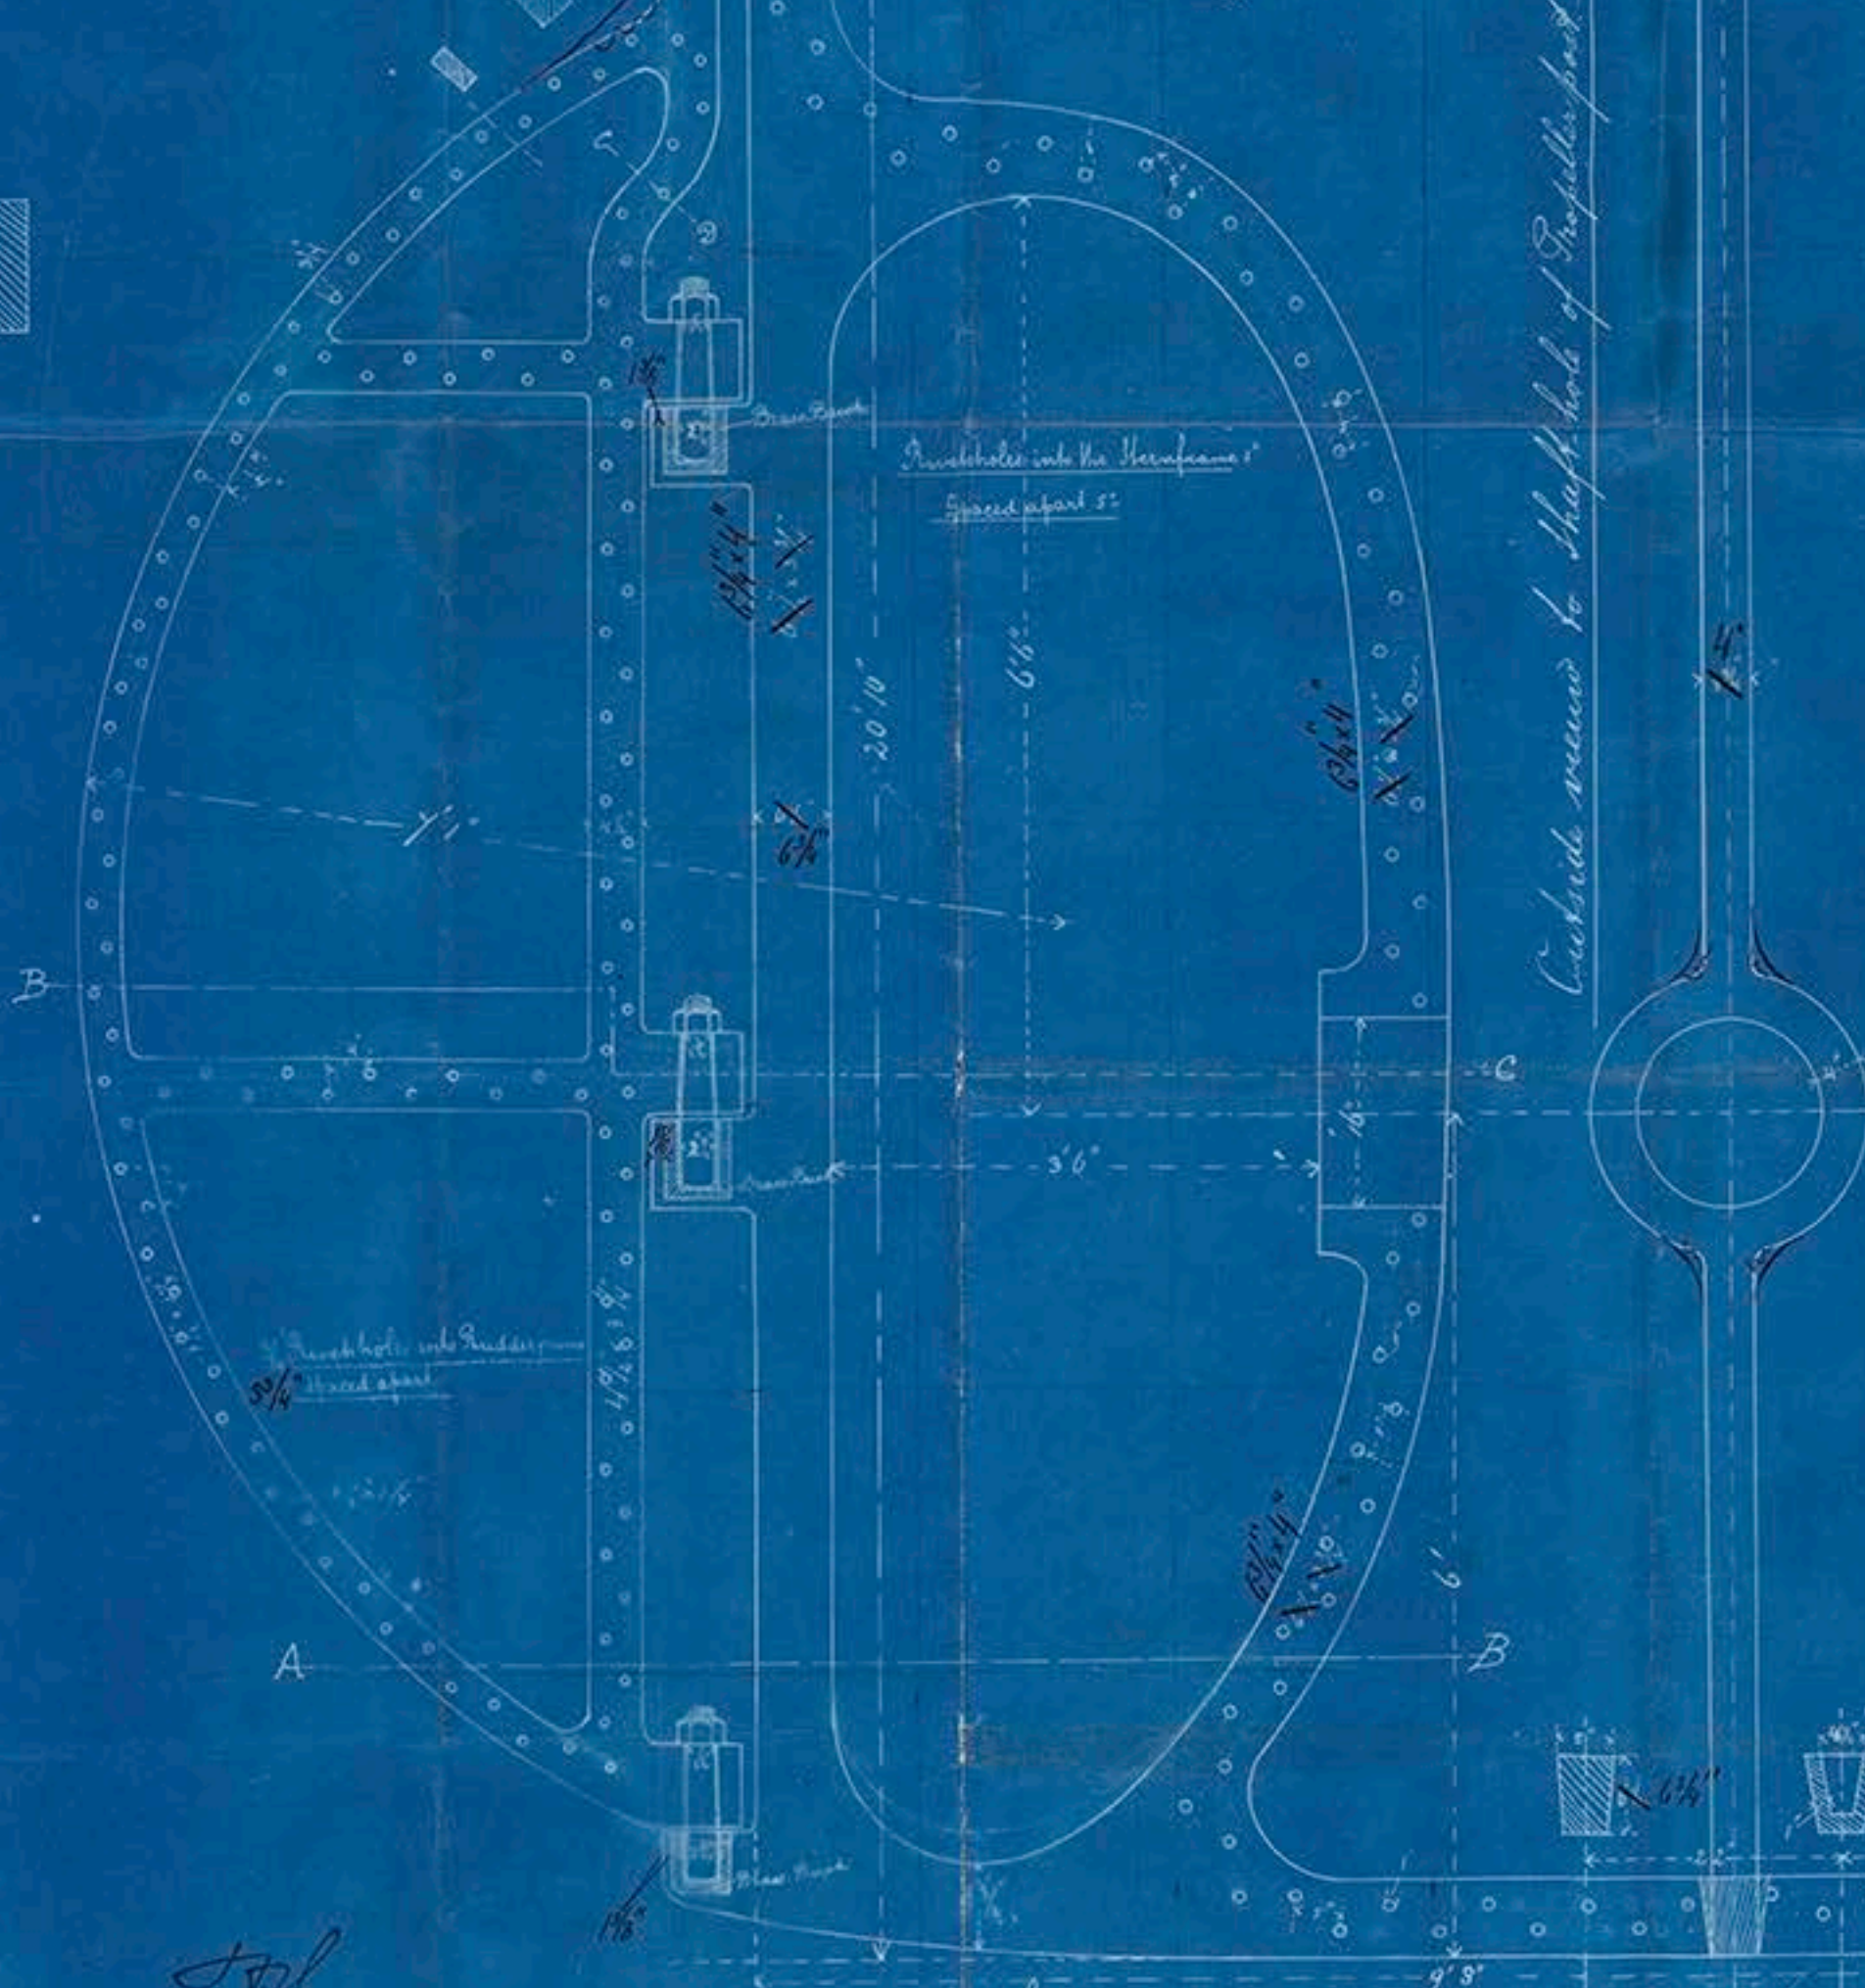

Section to A.D.



8/8/99



© 2018 Lloyd's Register Foundation



Part. of Rotterdam

S. V. "Island Queen"

Report No. 2959

Stern frame & Rudder