



SS N^o 104.

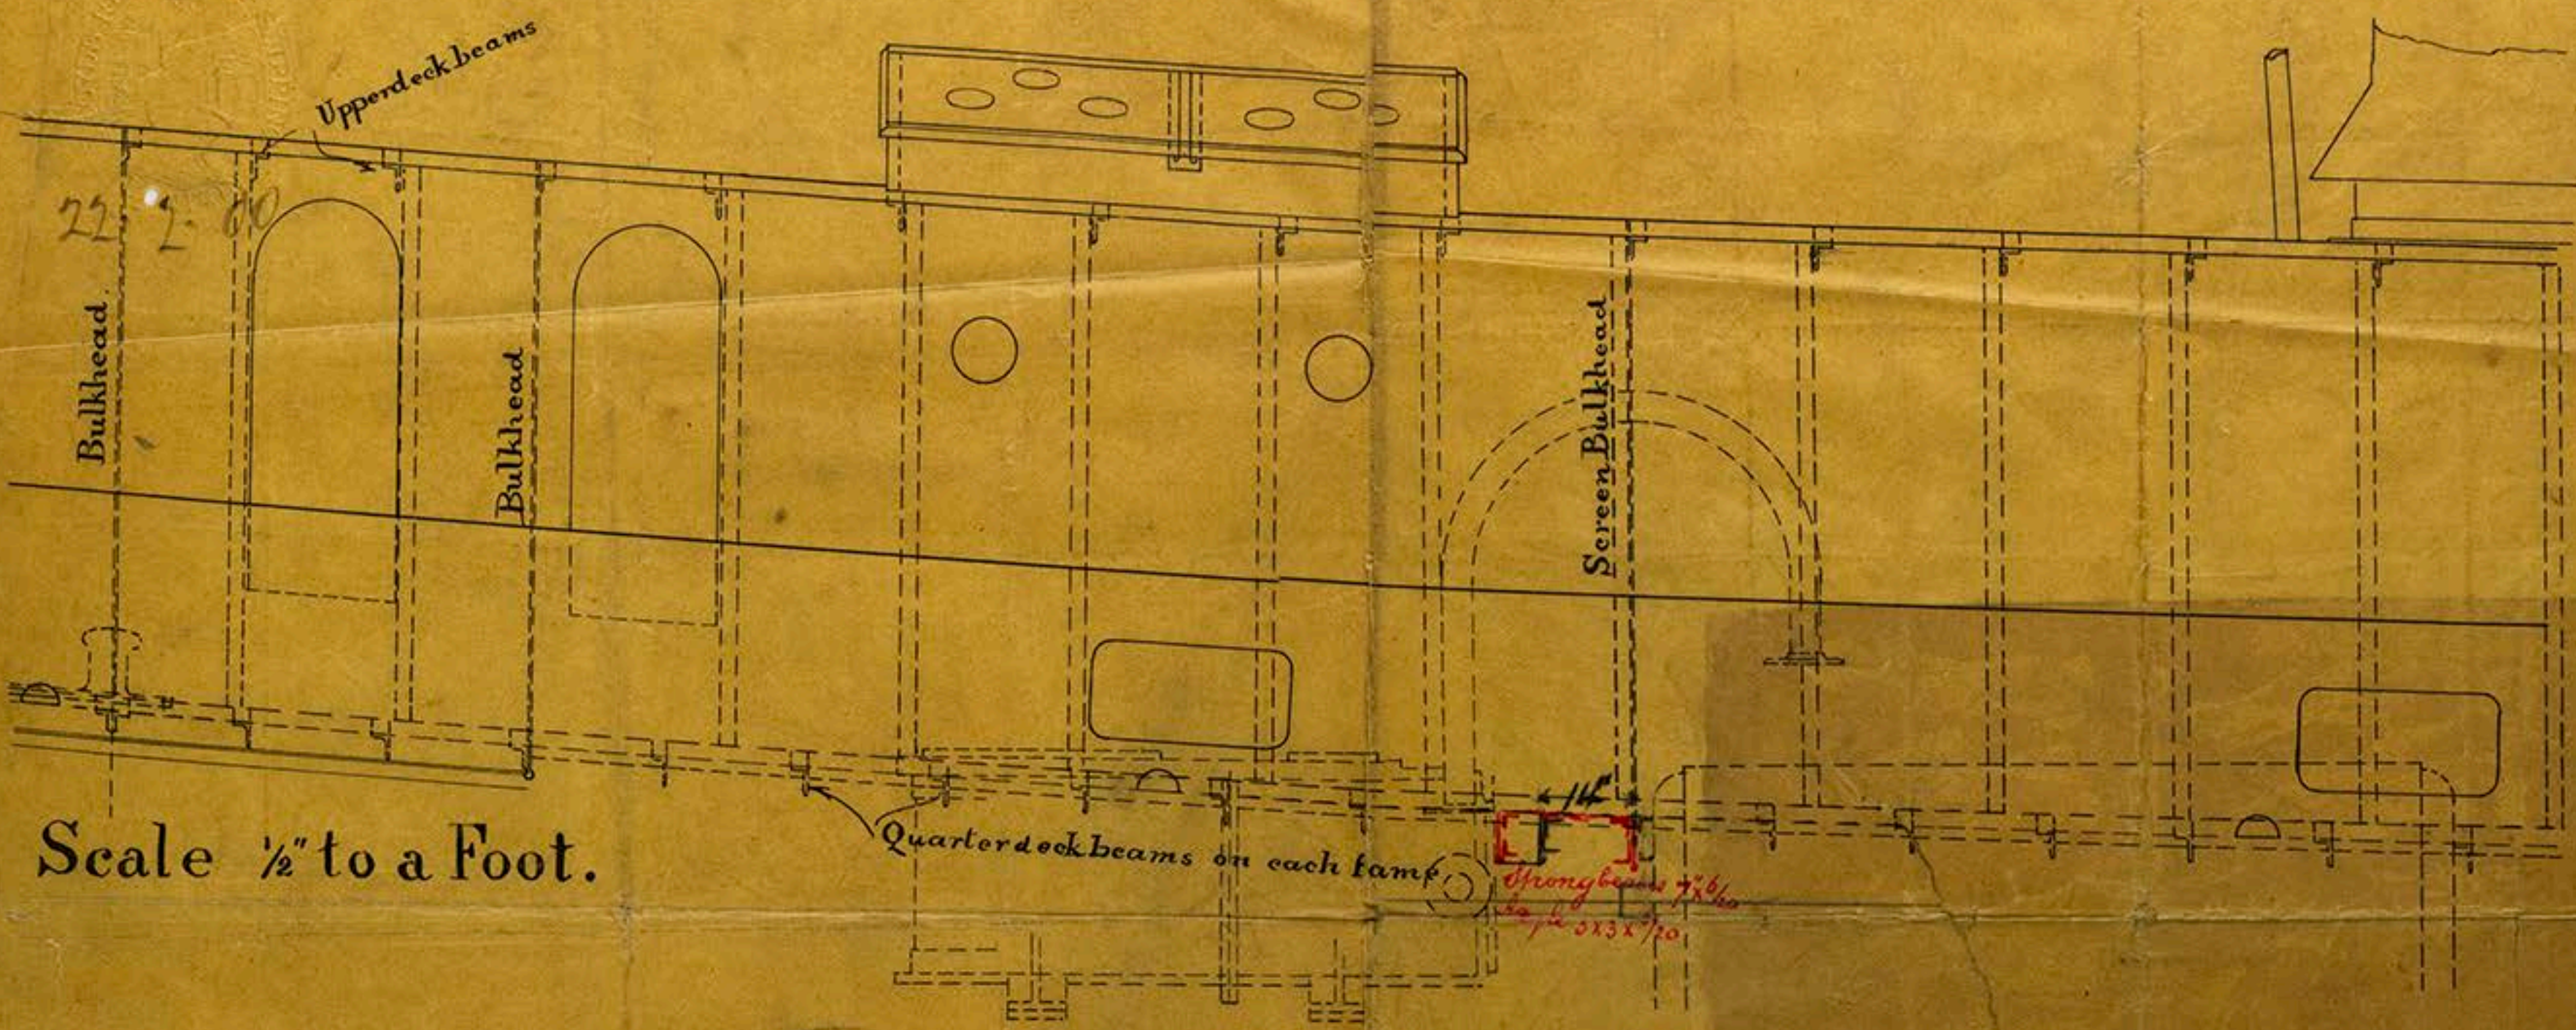

Scale 1/2" to a Foot.

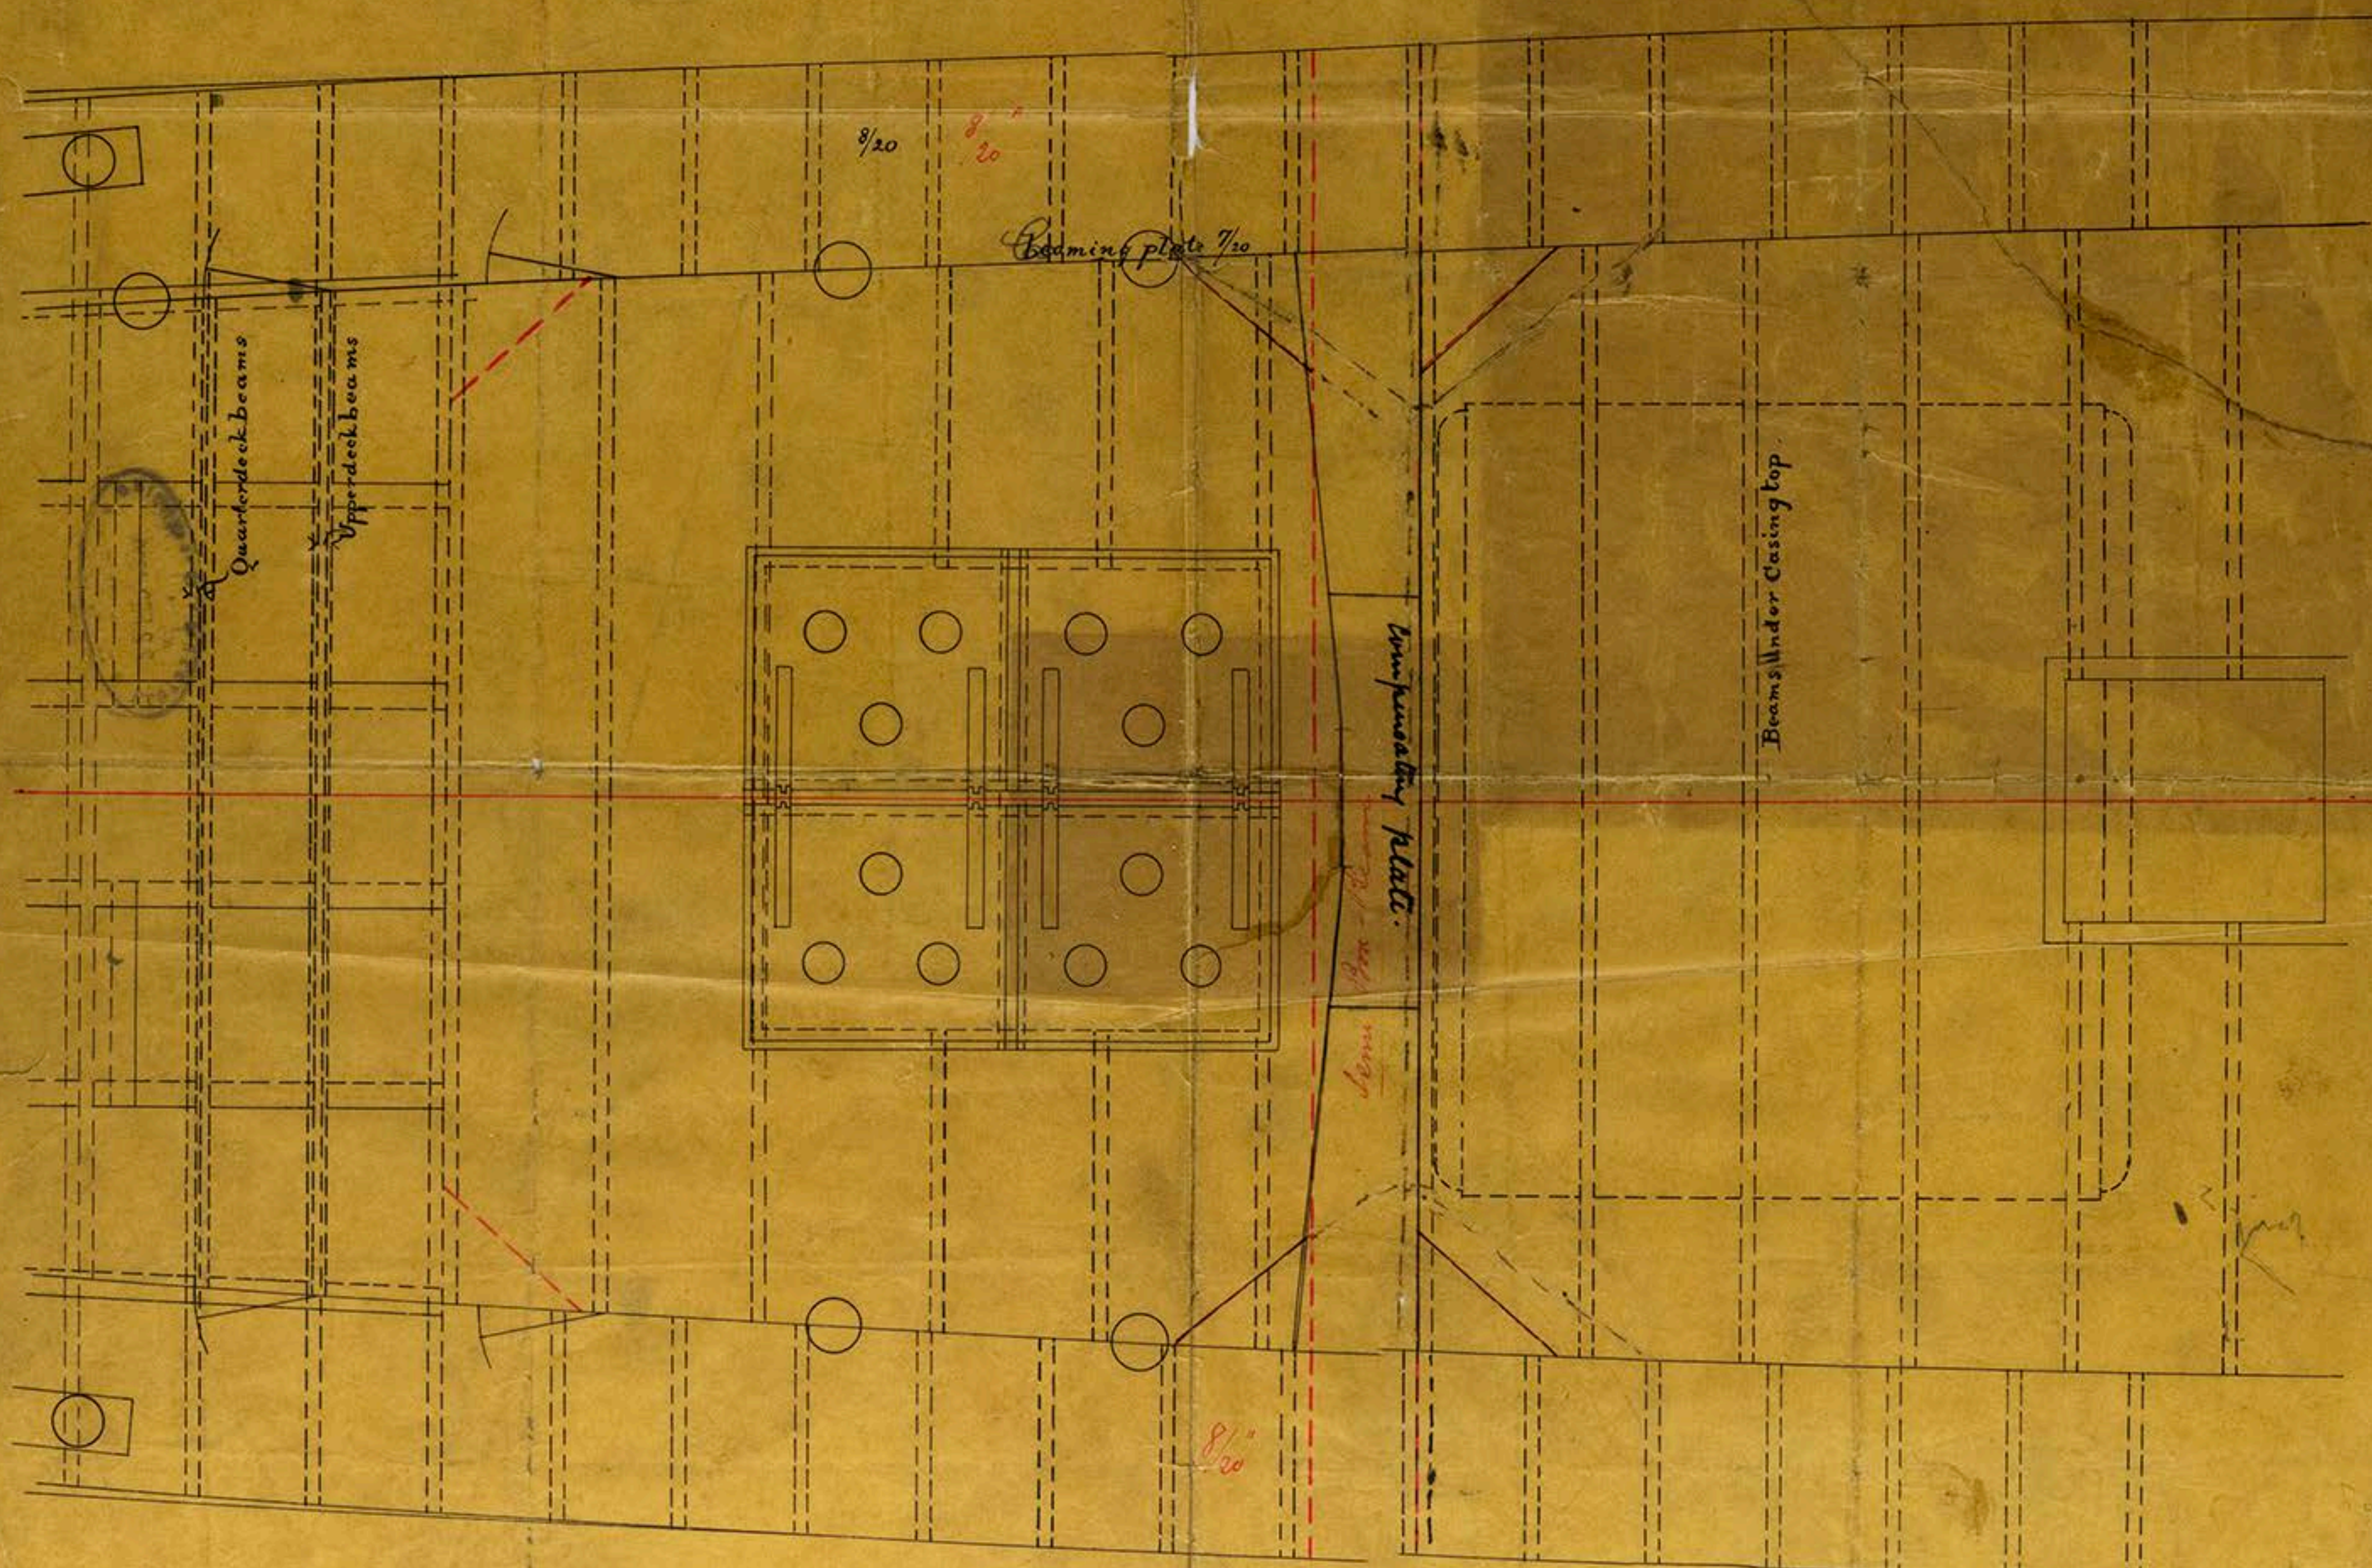

247
22/2/00