


S.I. No. 104



1/50

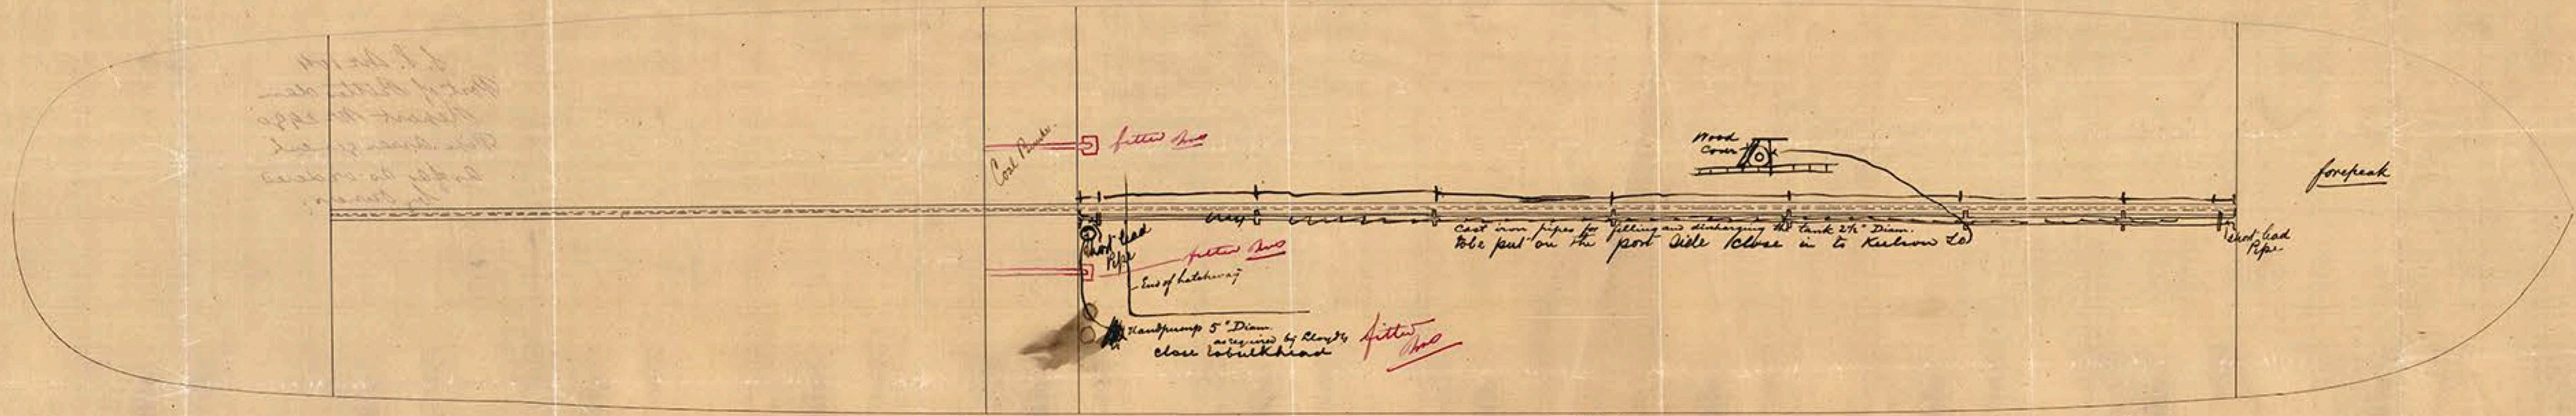

*Faint handwritten notes on the left side of the diagram.*



S. S. No 104  
Port of Rotterdam  
Report No 2930  
Pipe arrangement  
as far as ordered  
by owners.

