


One Steel Donkey Boiler off thus under L.L.'s Survey

for No. 1044 $\frac{L}{S}$, building by J. Meijer of Zalt-Boemel, Holland.

Boiler No. 24 & 5-

Working Press. 100 lbs. Test 200 lbs per sq. inch

Scale $1\frac{1}{2}" = 1 \text{ foot}$

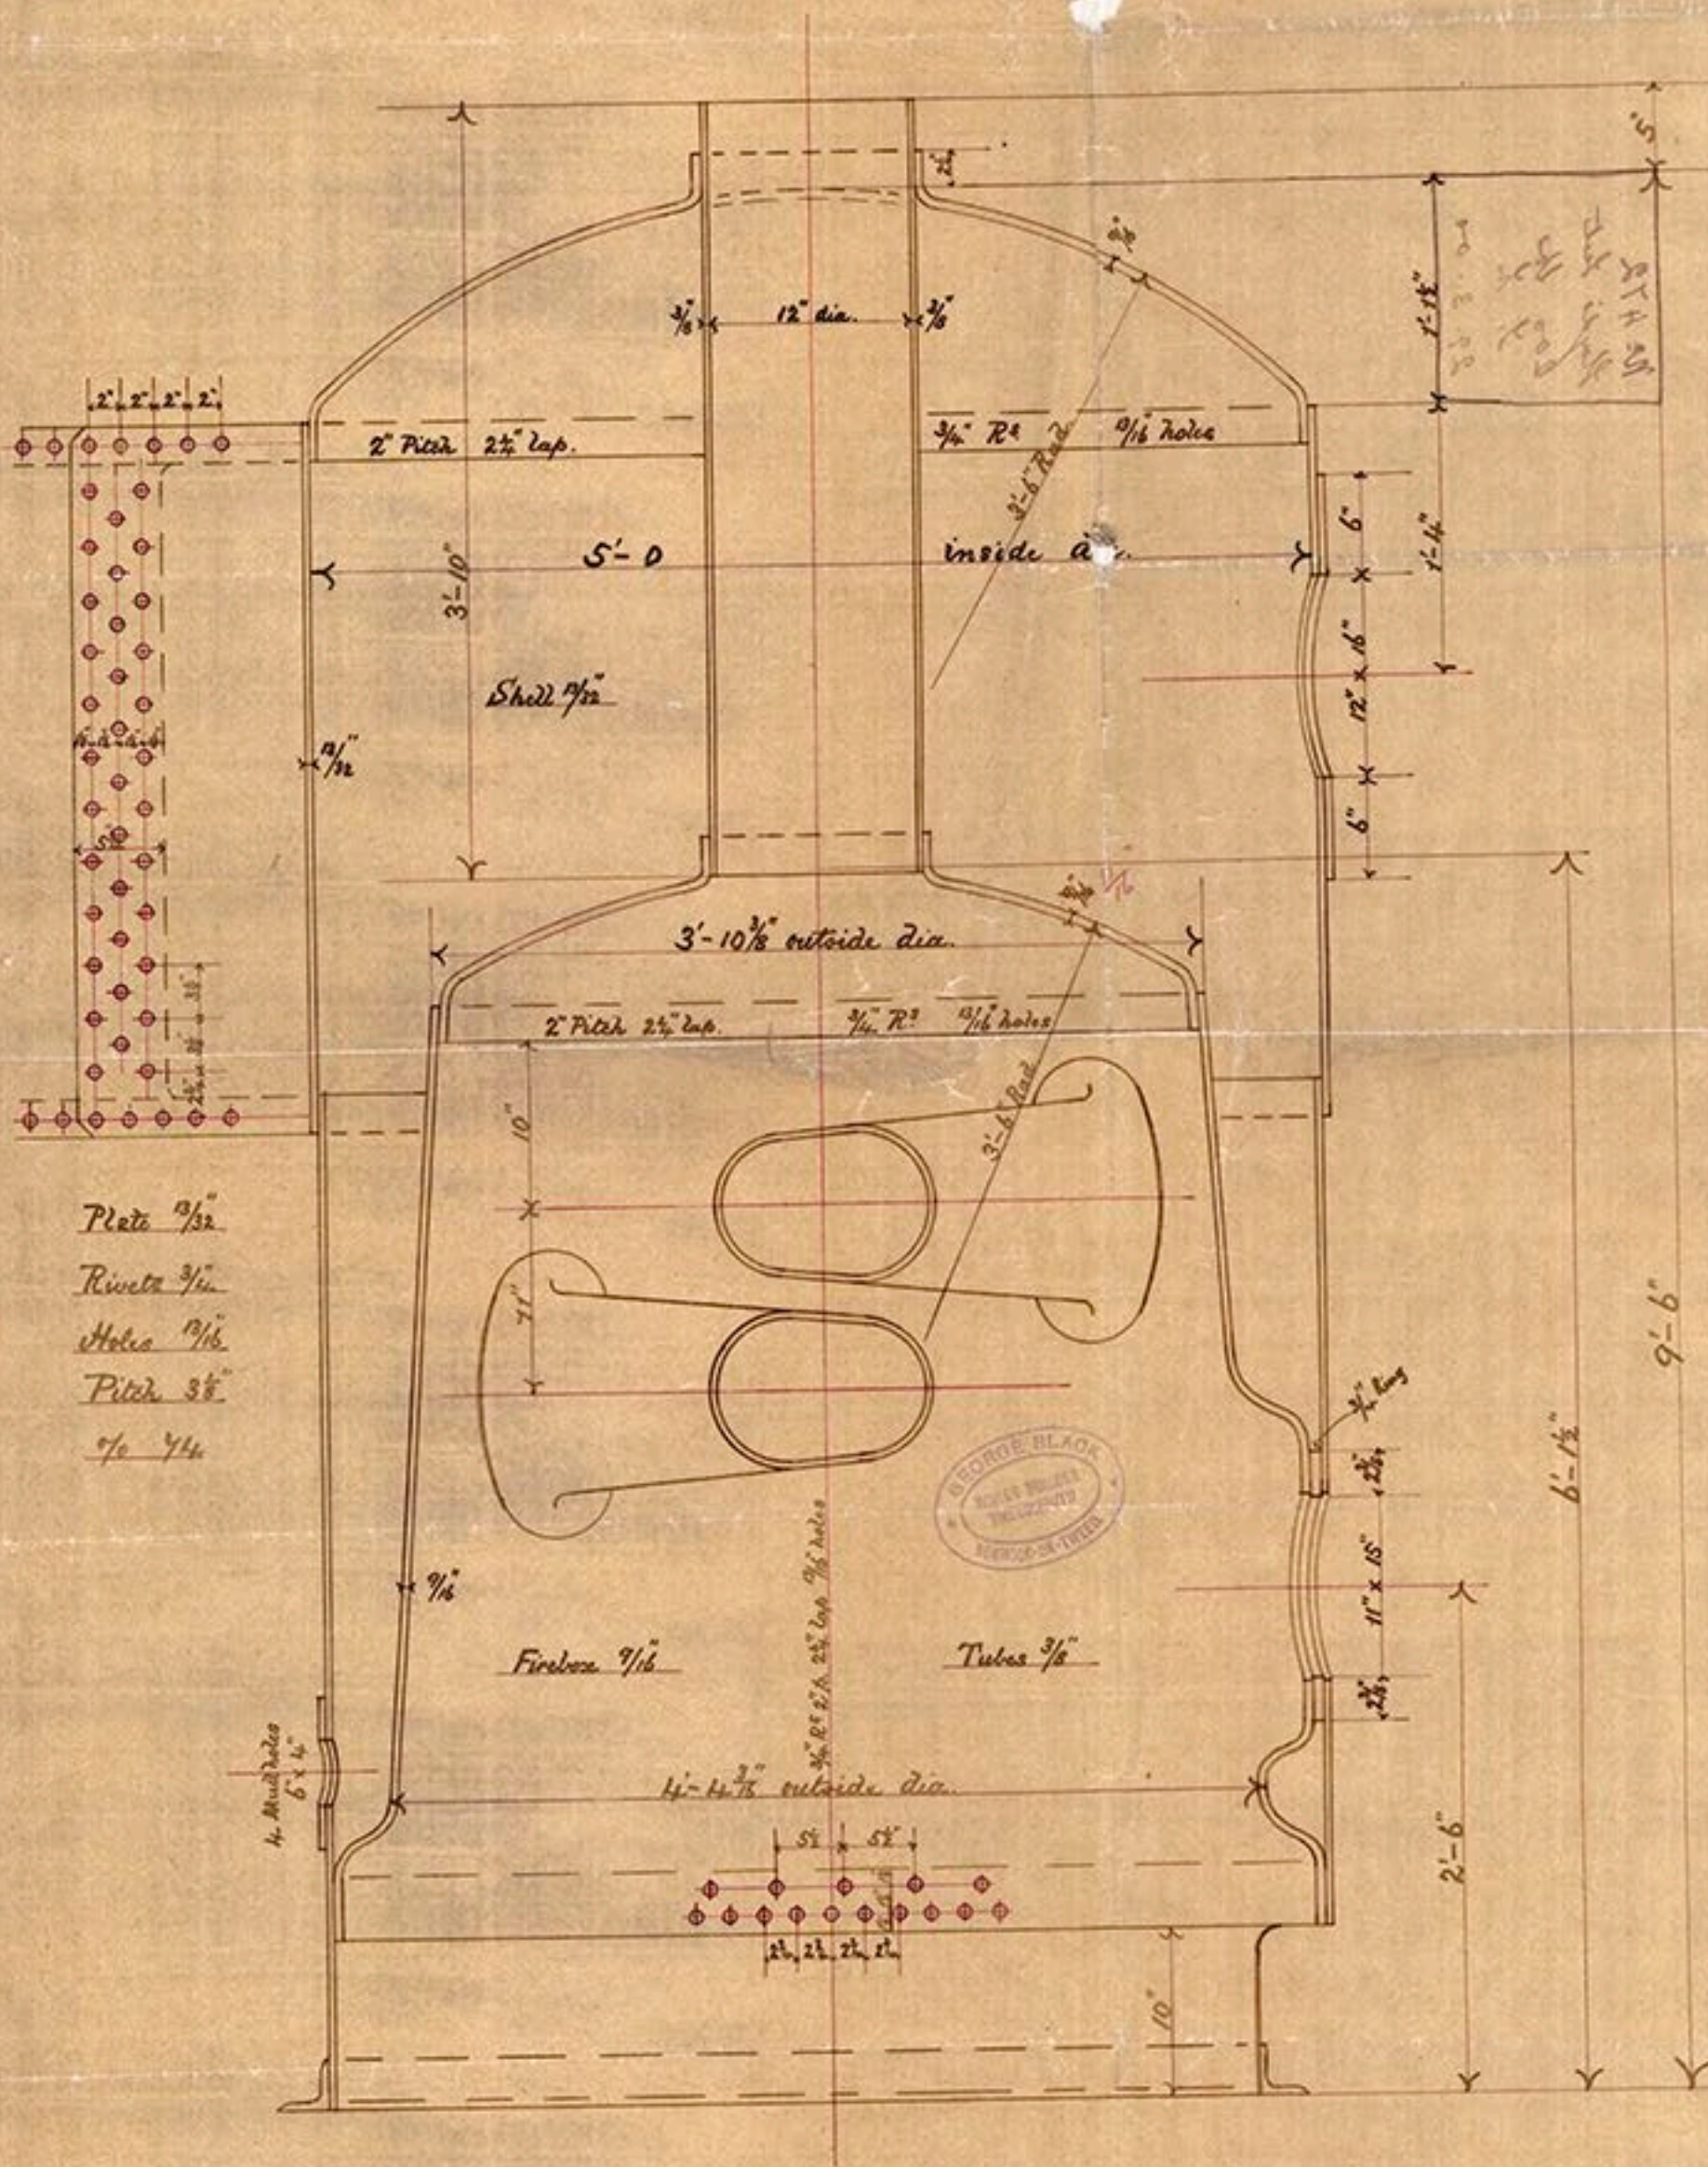

10/1/18

1892. 2. 2. 1892. 2. 2.

Plate $13\frac{1}{2}$ Rivets $\frac{3}{4}$ "Holes $13/16$

Pitch $3\frac{1}{8}$ "

7/0 74

Firebox 9/16²

Tubes $\frac{3}{8}$ "

4'-4 $\frac{3}{8}$ " outside dia.

4. Mud holes
L. J. 1.5"

21/10/99

25.10.99

472/3

Steel Donkey Boiler
G. Black No. 24 1/2
for shipment to Holland
100 lbs



S. I. No. 104
Part of Rotterdam
Report No. 2980

Boiler No. 24 1/2

No. 472
Hoyde test
200 lbs
1. 1.
29. 3. 00
1. 12"

15" x 19" 9"



© 2010
Lloyd's Register
Foundation