

205


157 3098
4. 4. 98

Plan shewing Shell in way of Bridge
N^o 196 1/2
Scale 1/8" = 1 Foot



*in one block of 1/2
the whole of the
main deck was
cut out and
the hull was
strengthened
with steel
plates and
beams.*

II

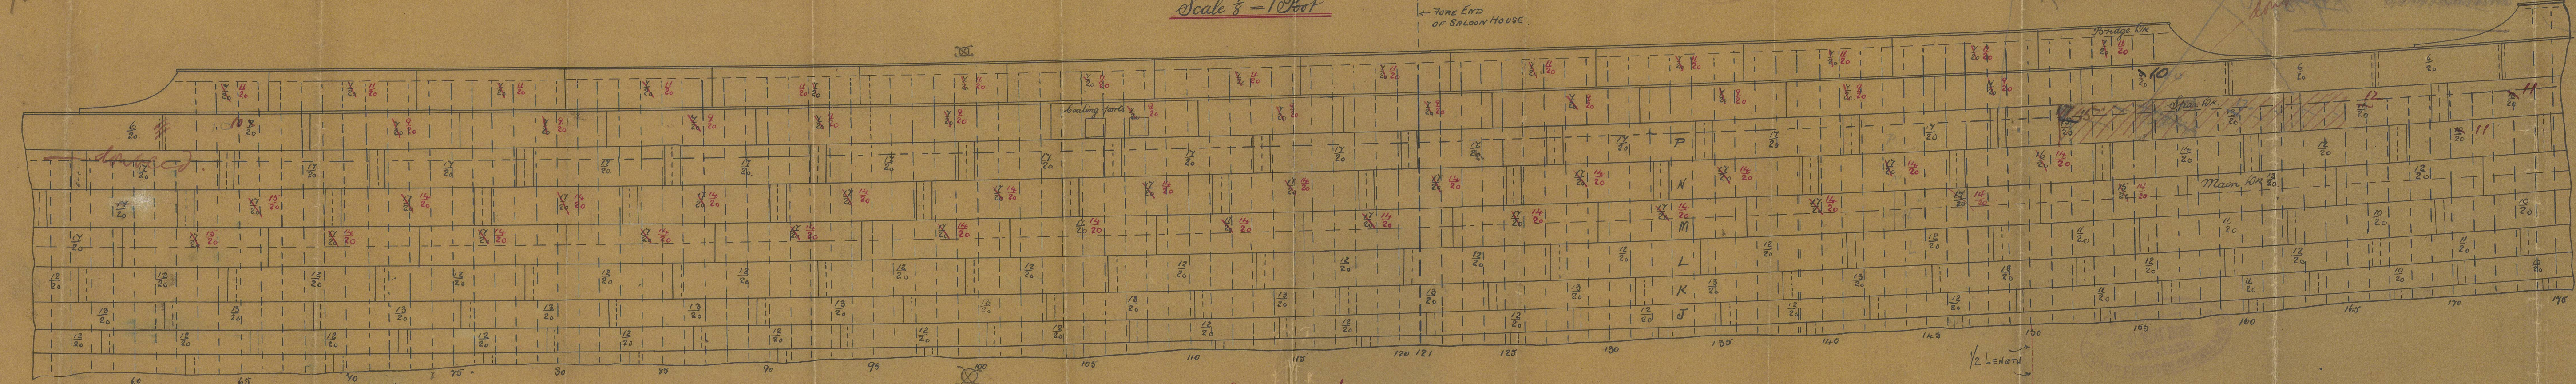

17/15/3/98

Sld. S. B. Co.

LV. N. 196

Shell in way of
bridge

~~Shannon~~ 9/13/96

S/S Hakool

SUNDERLAND. NO 19431

Notes sent to
St. Harrington
Sea 18447.



© 2021

Lloyd's Register
Foundation