
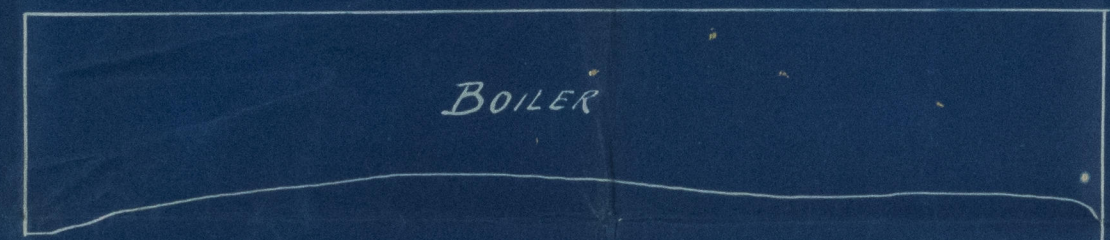


REGISTERED  
 SHIPBUILDING  
 OFFICE  
 Jan 14 1896  
 SUEDEALMA

24.1.96.  
 1.12.97 (N<sup>o</sup> 196)


MIDDLE HOLD STRINGER IN WAY OF BOILERS.

— N<sup>o</sup> 186. S/S. — Also N<sup>o</sup> 196  
 appo. 1/12/97

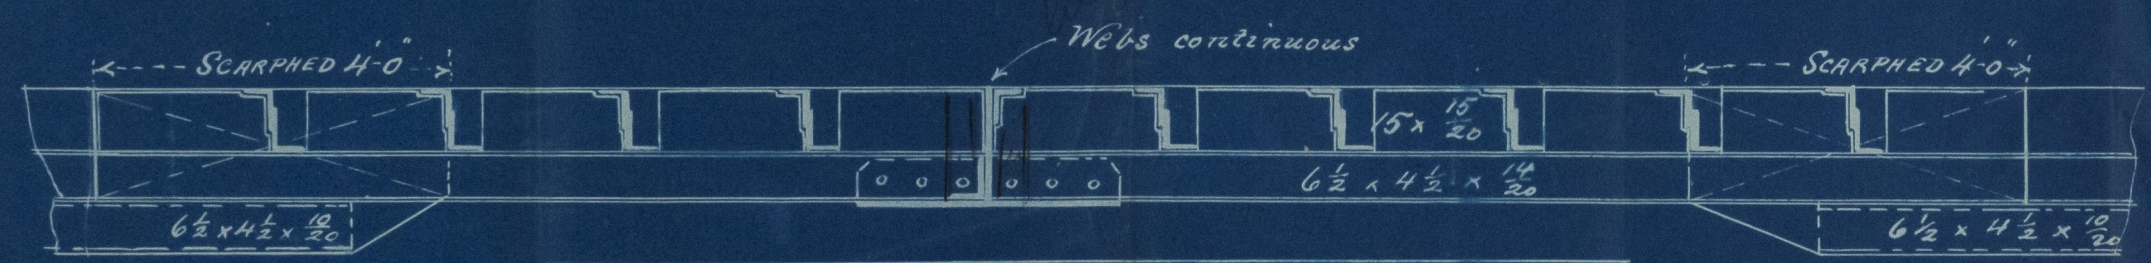

SHIPBUILDING  
 DRAWING OFFICE  
 Jan 14 1896  
 SUEDEALMA

J.H.  
 23/1/96

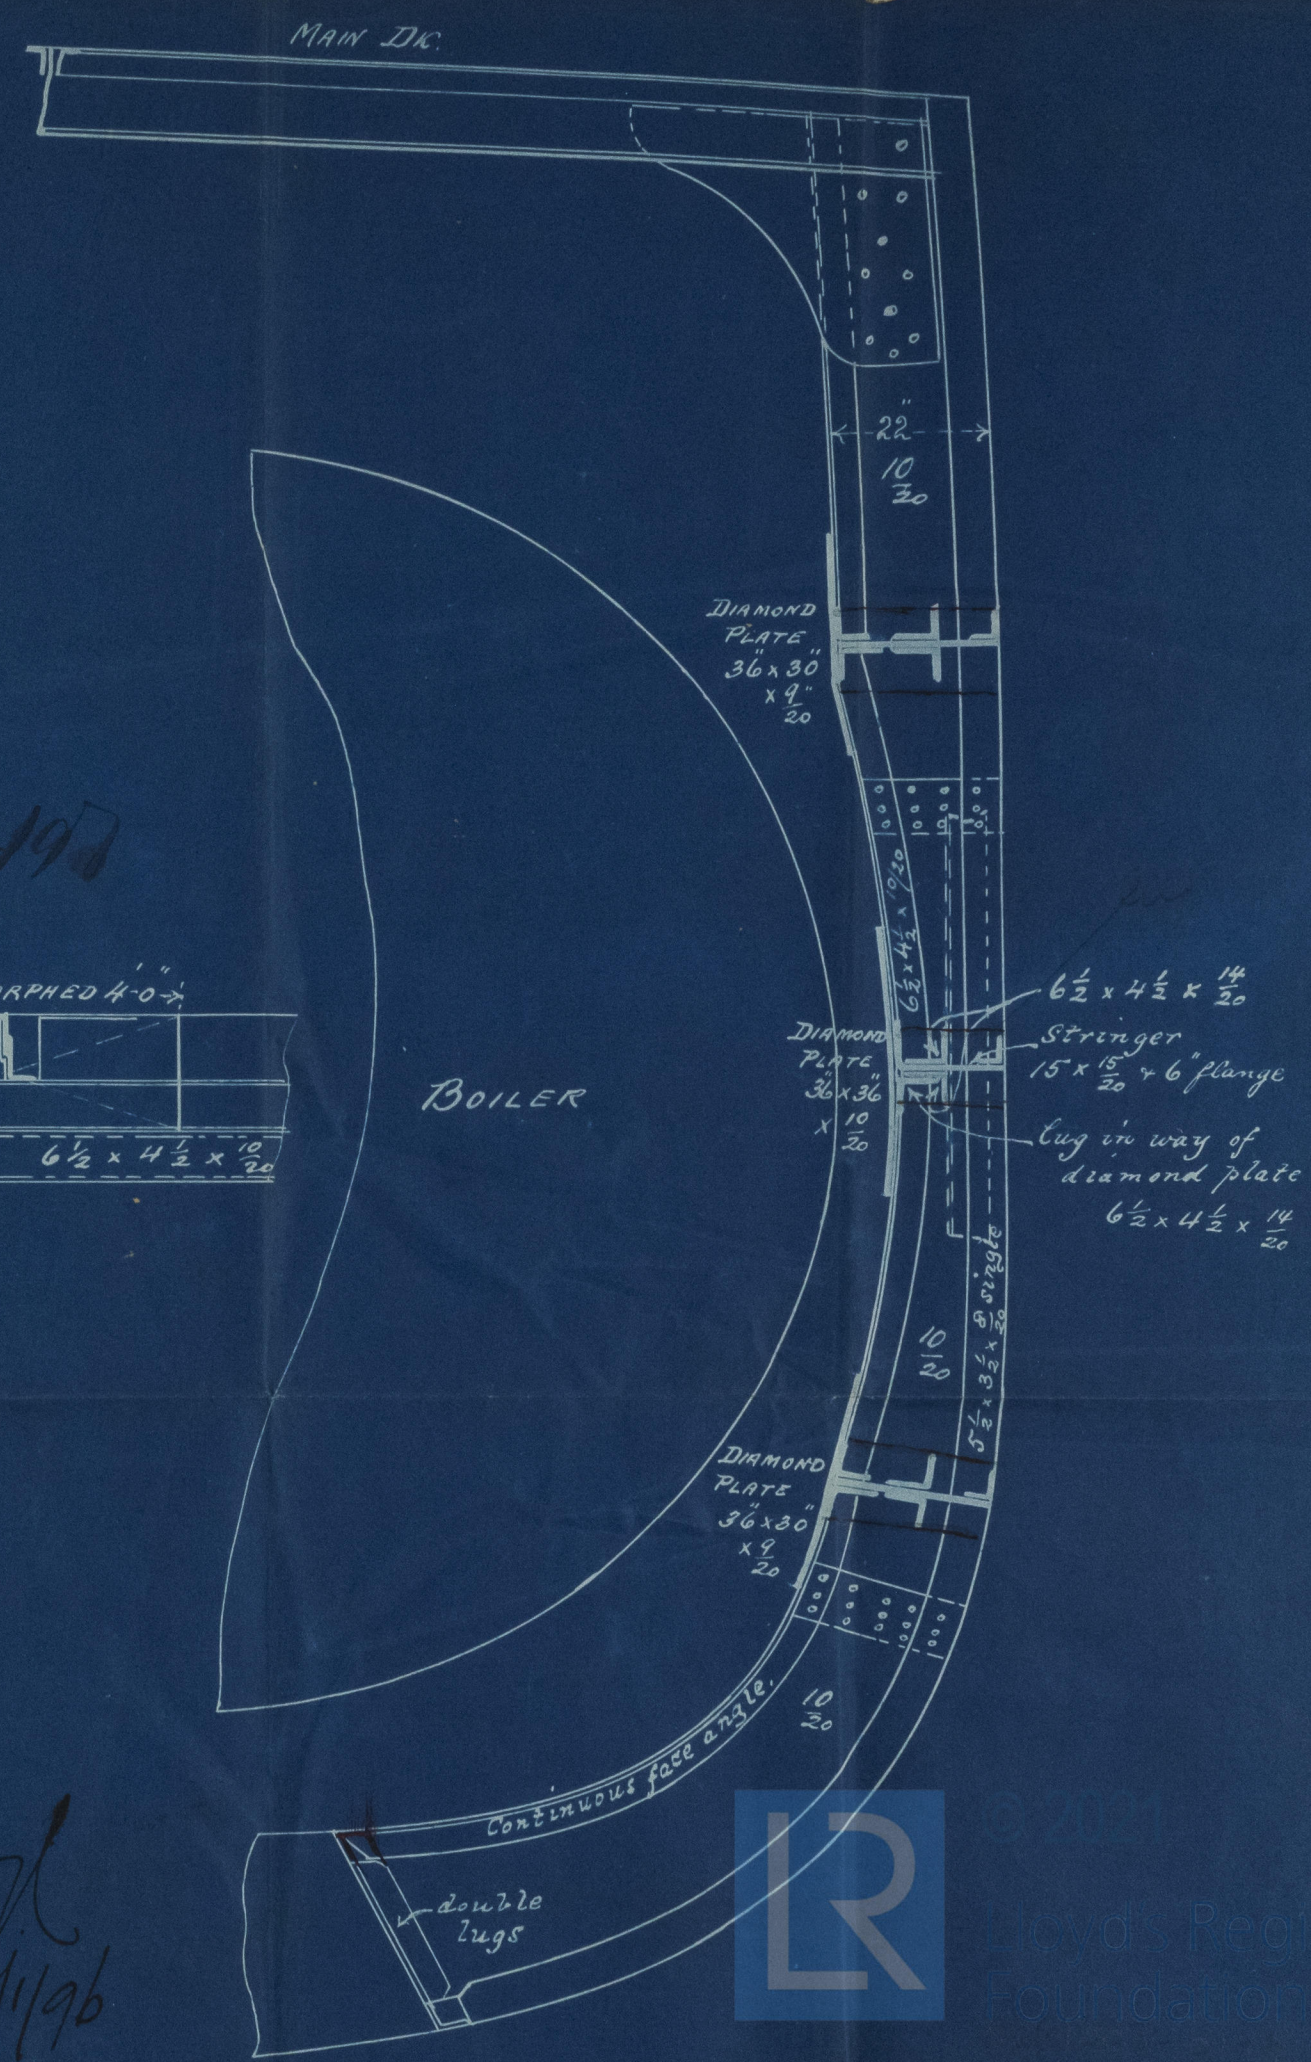

© 2021  
 Lloyd's Register  
 Foundation




SLD. L.B. Co. & 186

Web frame & Strips  
in boiler room

S. S. "NARRUNG"

- SLD Report 18447-

silver vessel to  
S. S. "Wakob"  
SLD 19431.

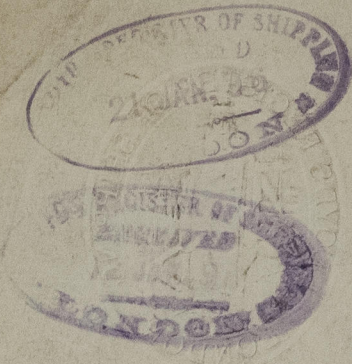

SLD1003-0199



© 2021

Lloyd's Register  
Foundation