


SLD1003 - 0200

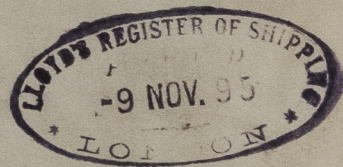



Newcastle on Tyne  
Wigham Richardson & Co  
Main Boiler  
No 319  
Sunderland Ship Co  
S-S- No 186.  
S. S. "Harrington"

LLOYD'S TEST  
4074-

Cancelled

See amended

Cancelled Dec: 1895  
amended 1896

See  
SLP1003 - 02.00

SUNDERLAND. No 18647.

