


NORTHUMBERLAND ENGINE WORKS

STEAM BOILER

TRACING 3056 SCHEDULE L

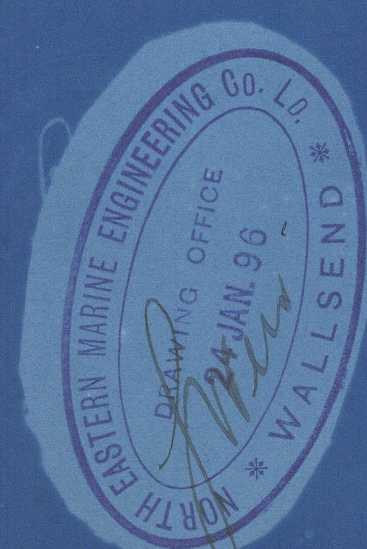





29/1/16
29/1/16

MANHOLE 16x12
COMPENSATING PLATE 2'-6"x2'-3"x1/32"

BUTT STRAPS { INSIDE 1 1/32
OUTSIDE 1 1/32

WORKING PRESSURE = 200 LBS.
TEST = 400

NOTE: ALL PLATES STAYS & TO BE OF STEEL EXCEPT OTHERWISE SHOWN.
TENSILE STRENGTH OF SHELL PLATES TO BE NOT LESS THAN 28 TONS PER SQ. INCH.

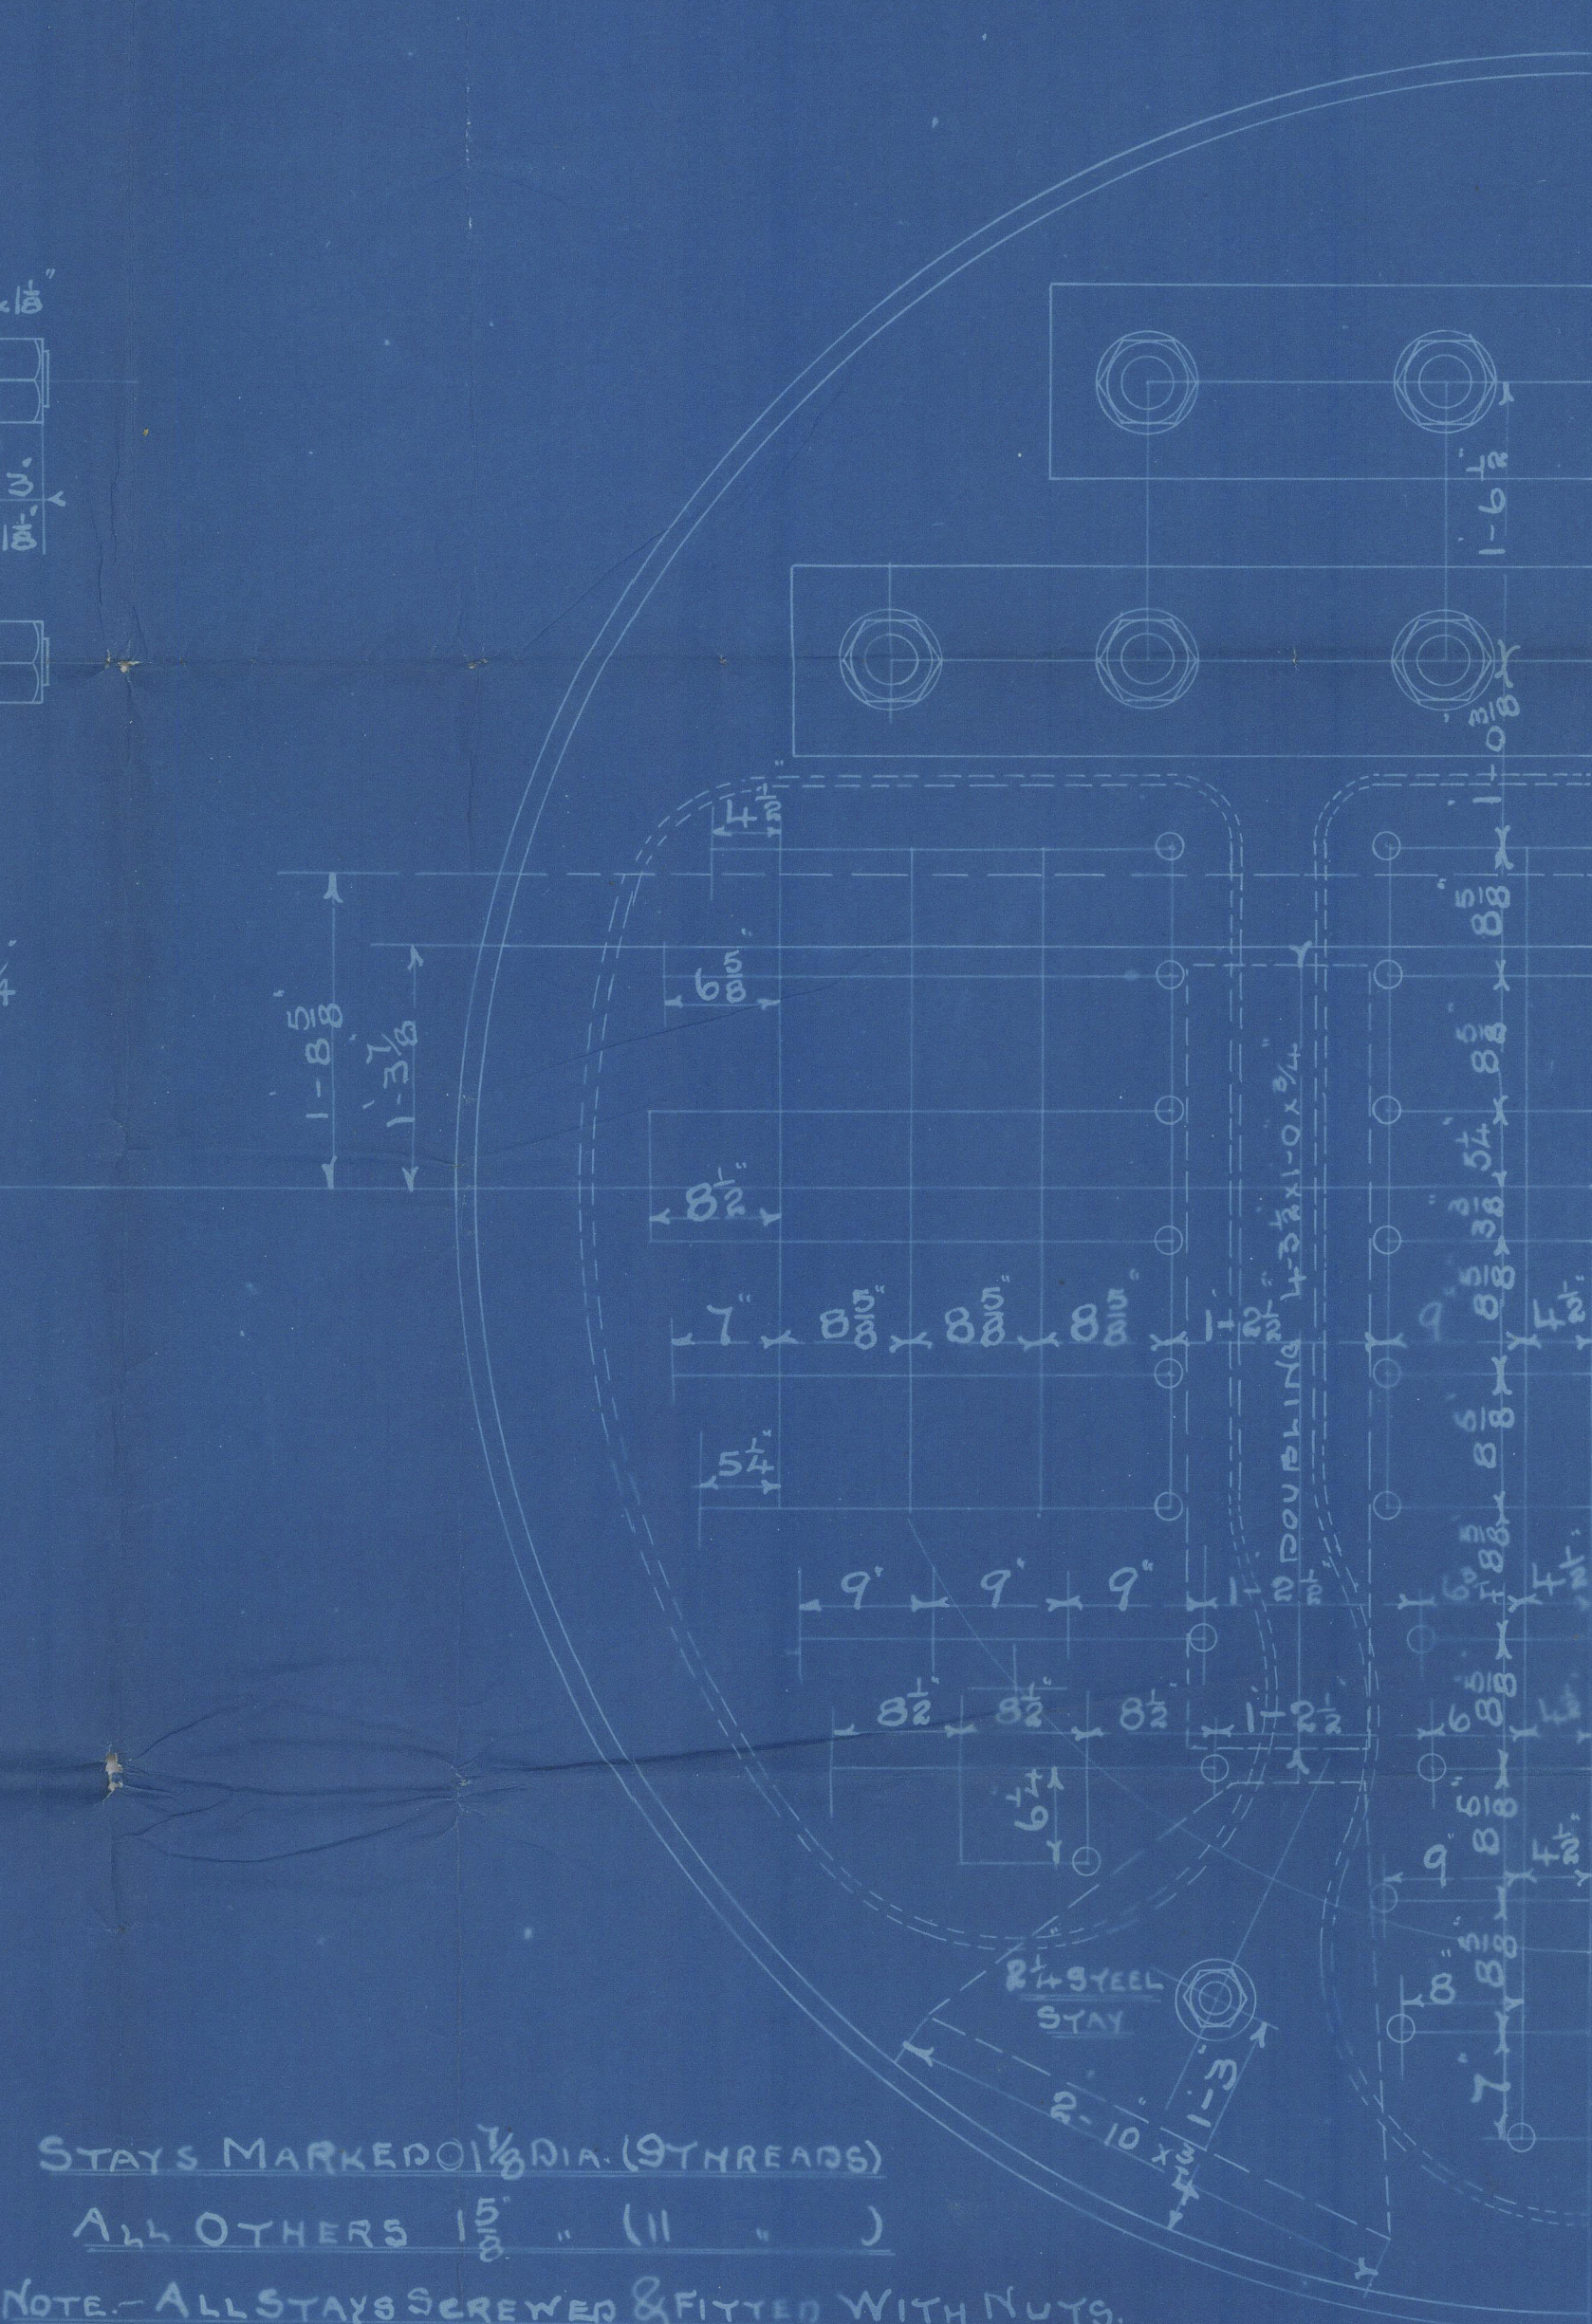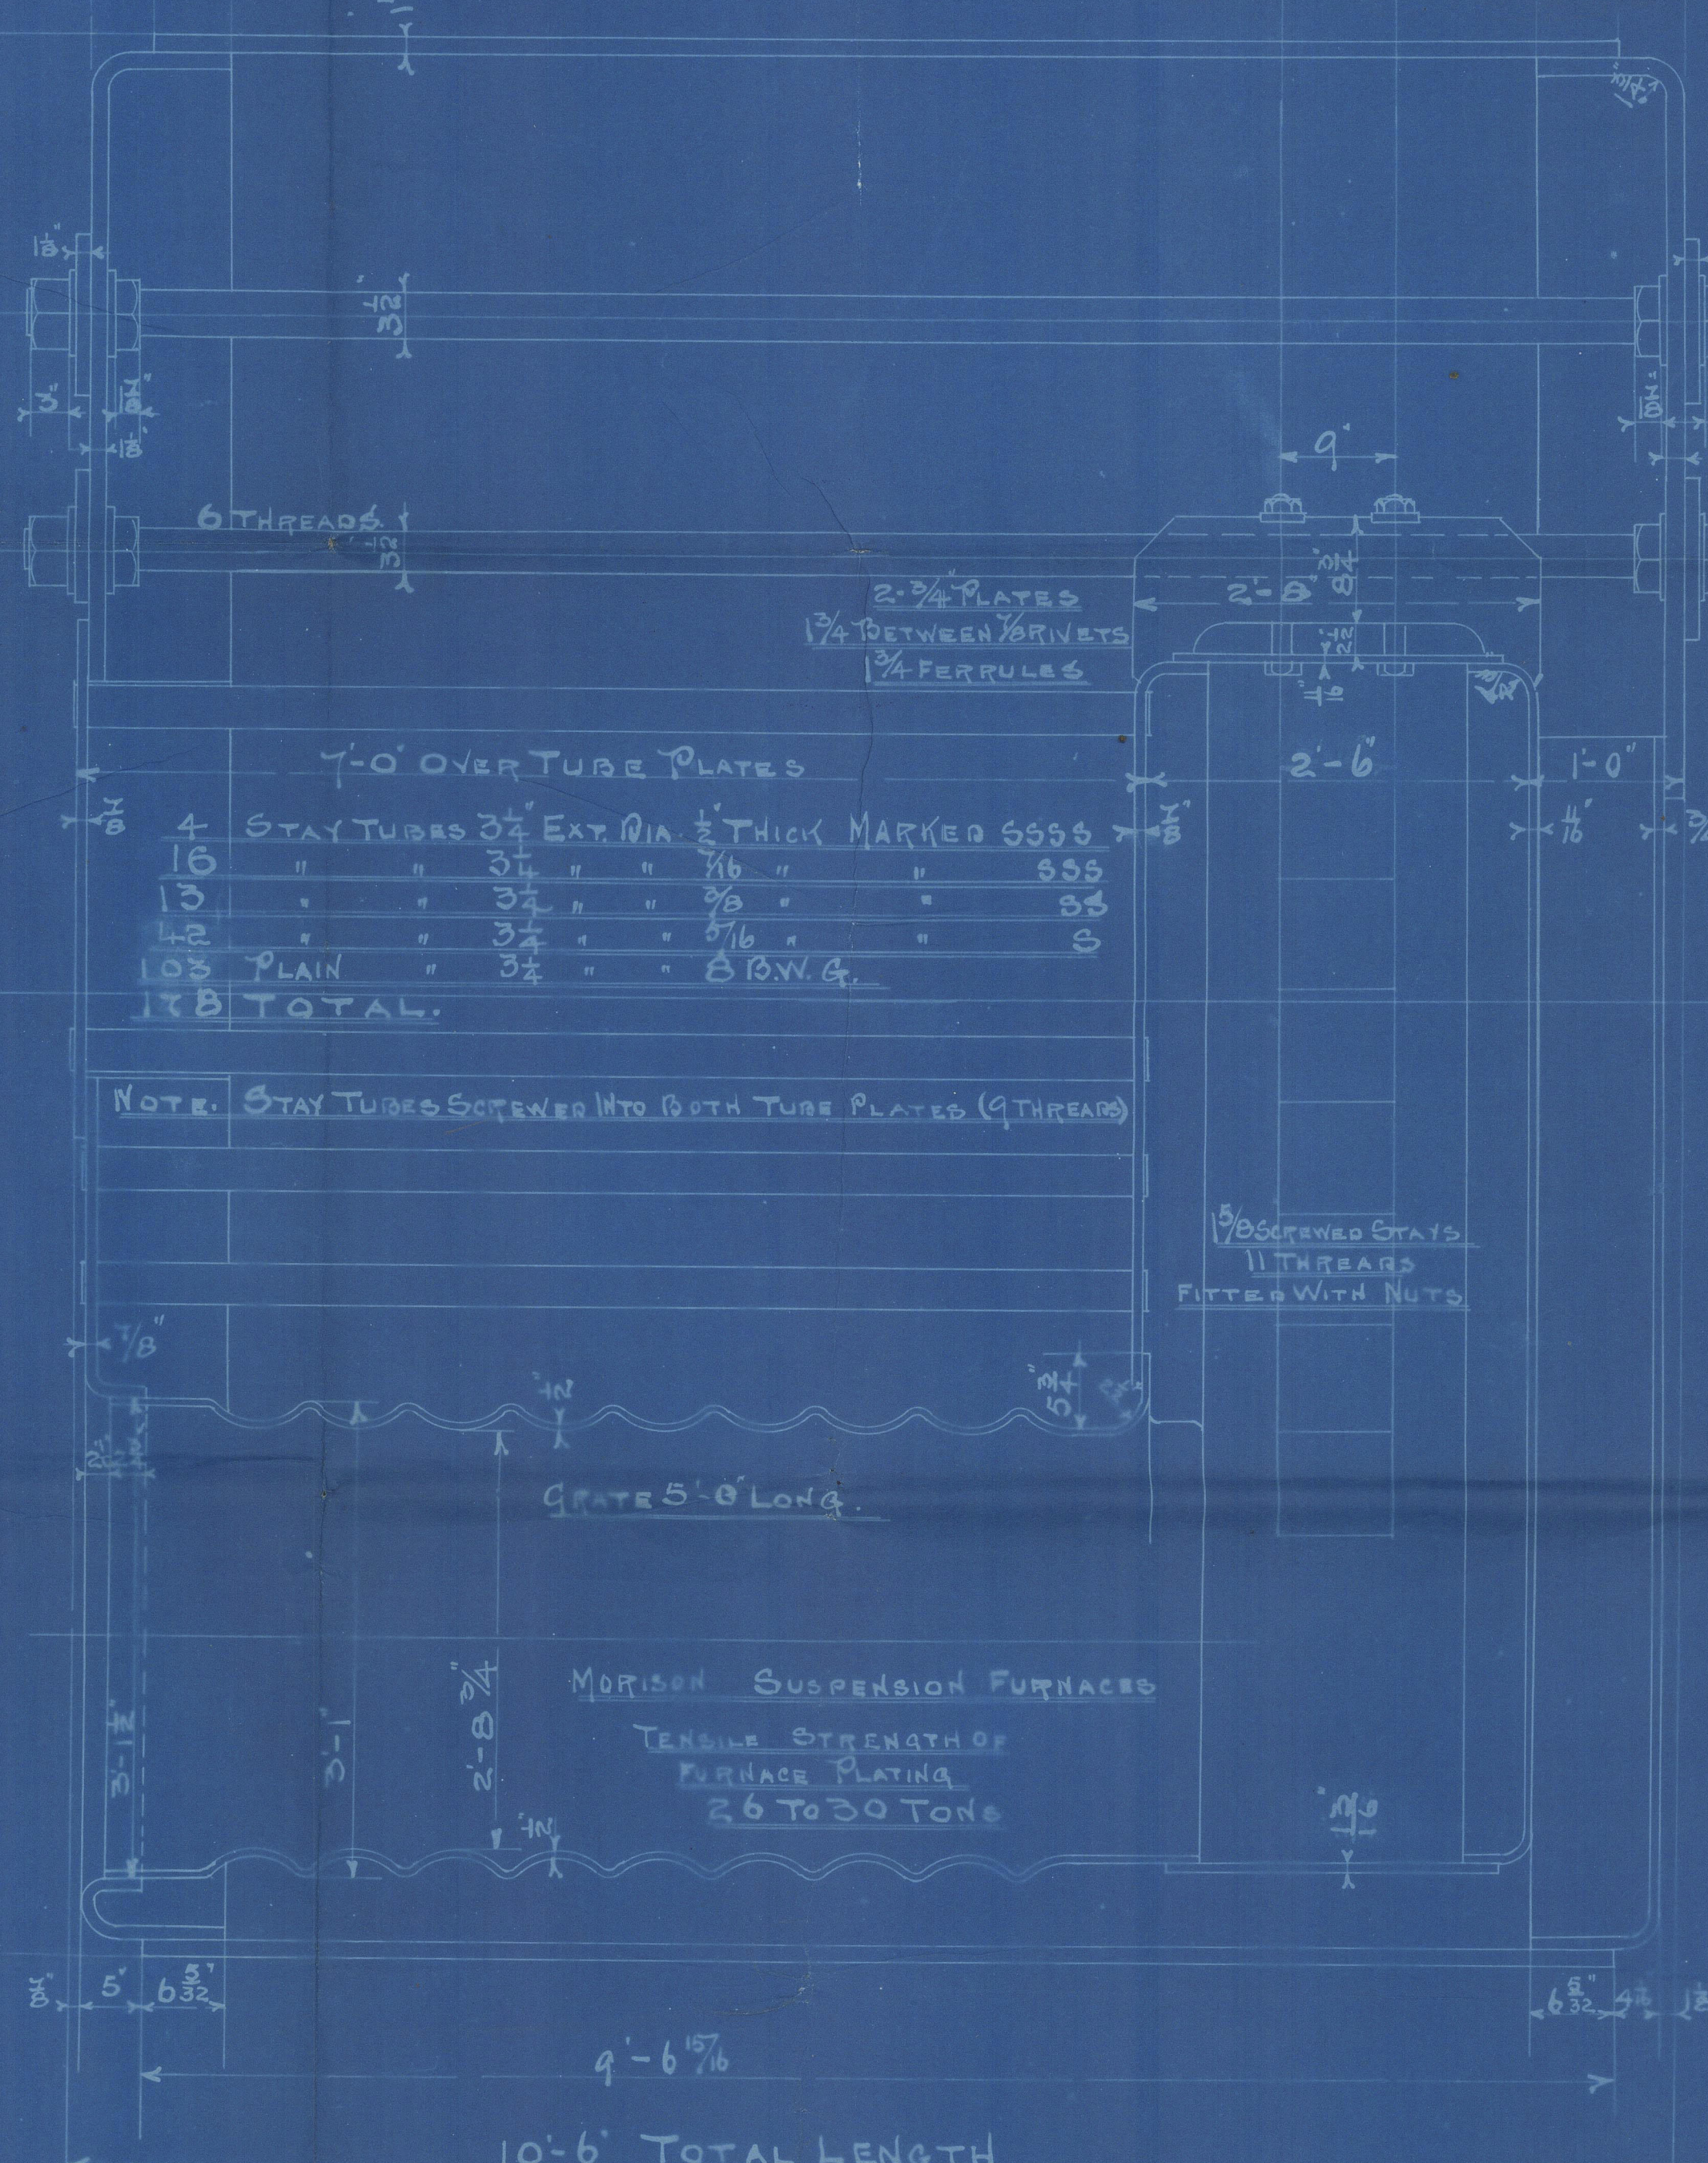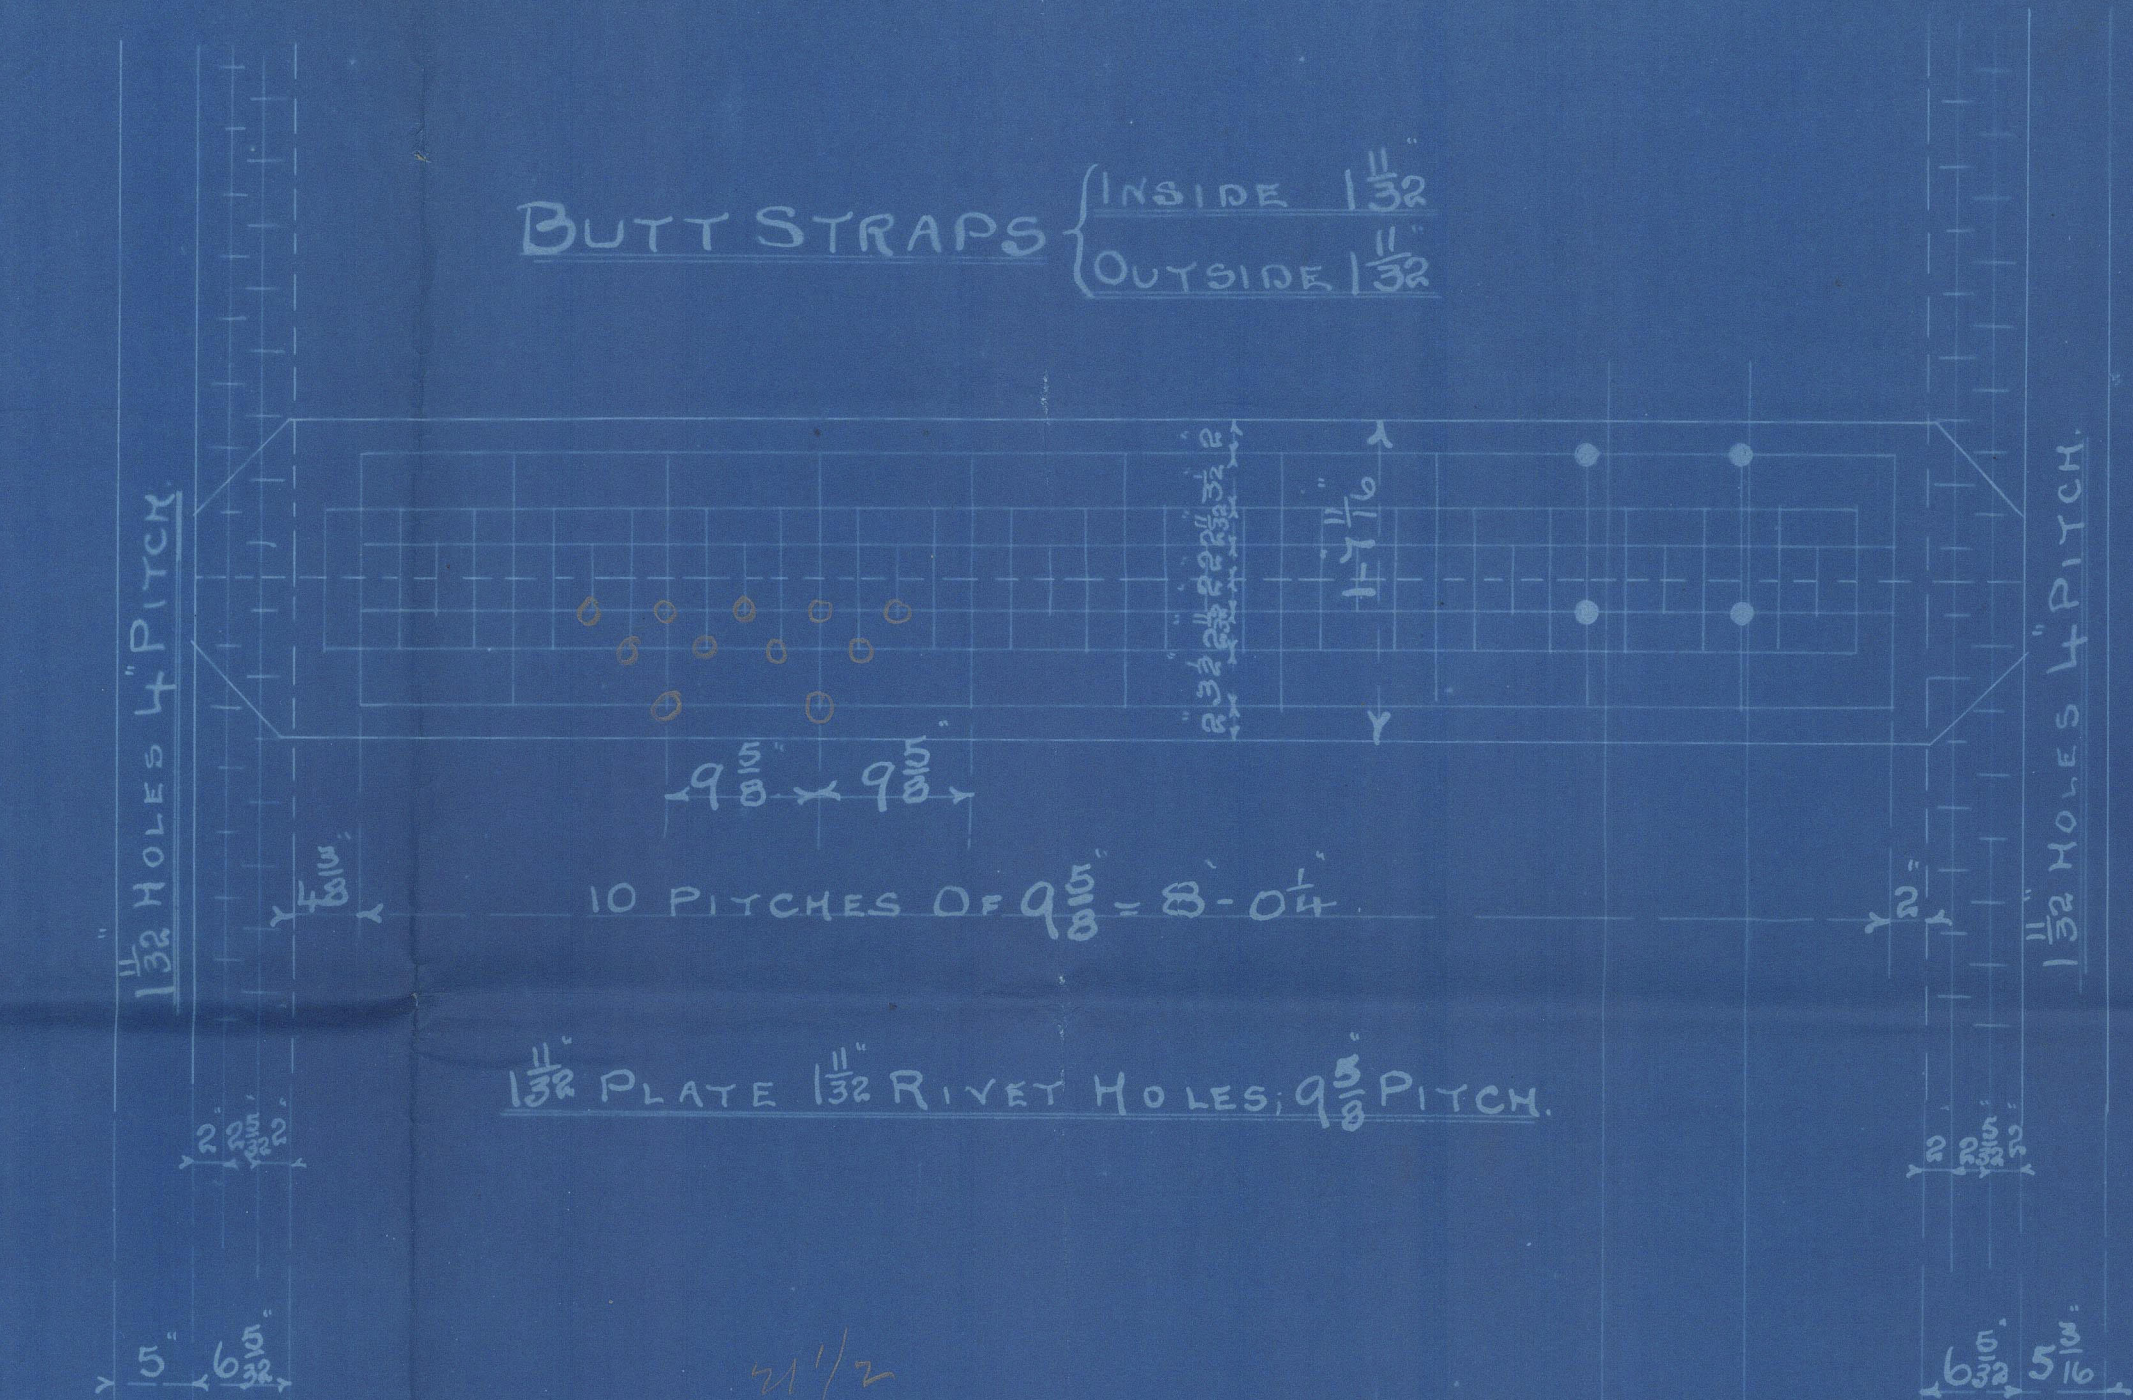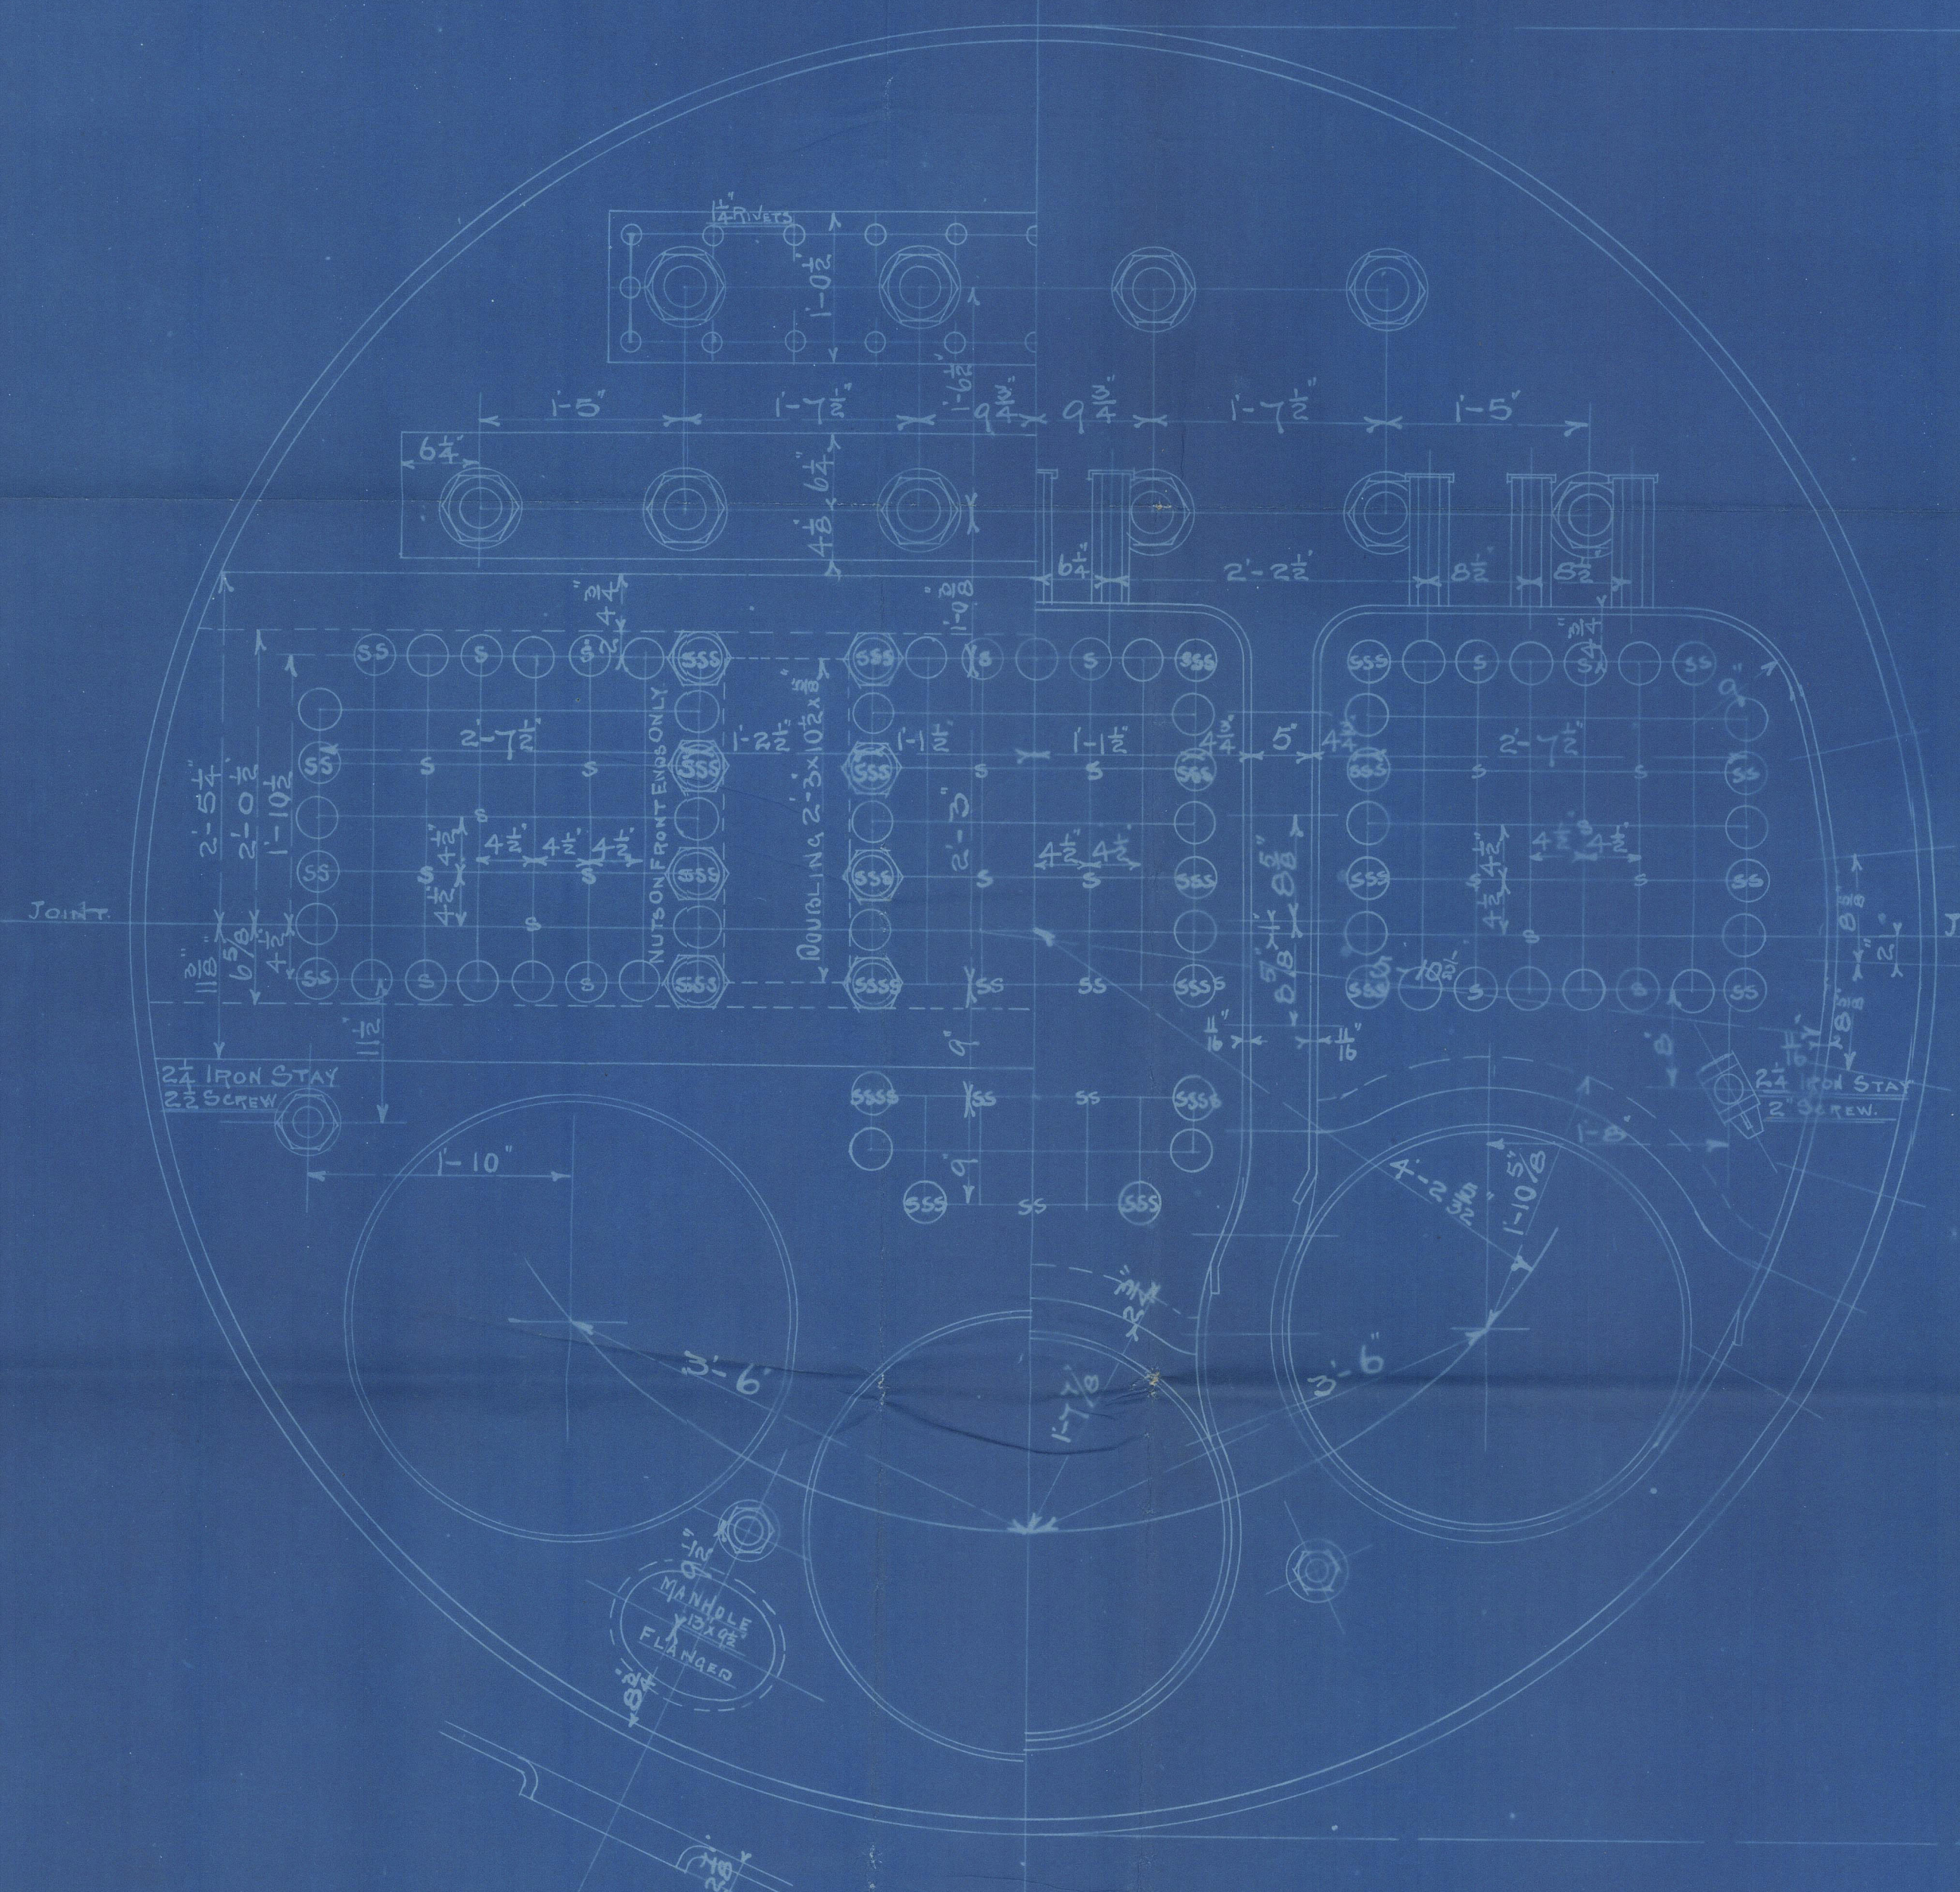


STAYS MARKED 1/8" DIA. (9 THREADS)
ALL OTHERS 1/8" (11)
NOTE: ALL STAYS SCREWED & FITTED WITH NUTS.

I. THUS

CONTRACT



Lloyd's Register
FOUNDATION

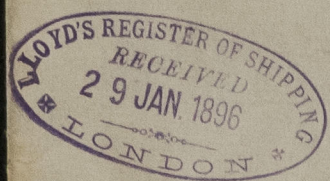

- DONKEY -

NRM & Co 729

Sunderland & B.L. 186 1/2

S.S. "Harrington"

N^o 4849
Lloyds test
400. lbs.
G.S.A.
10. 6. 96.

New Rpt No 33814

SUNDERLAND. 18447.

1020-500175



© 2021

Lloyd's Register
Foundation