




✓ Nov 196

appo. 1/14/97

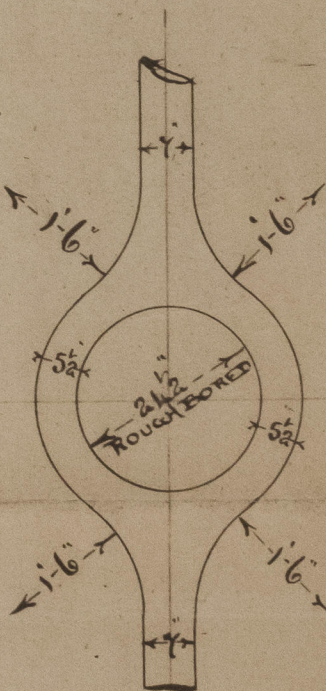

8.11.95

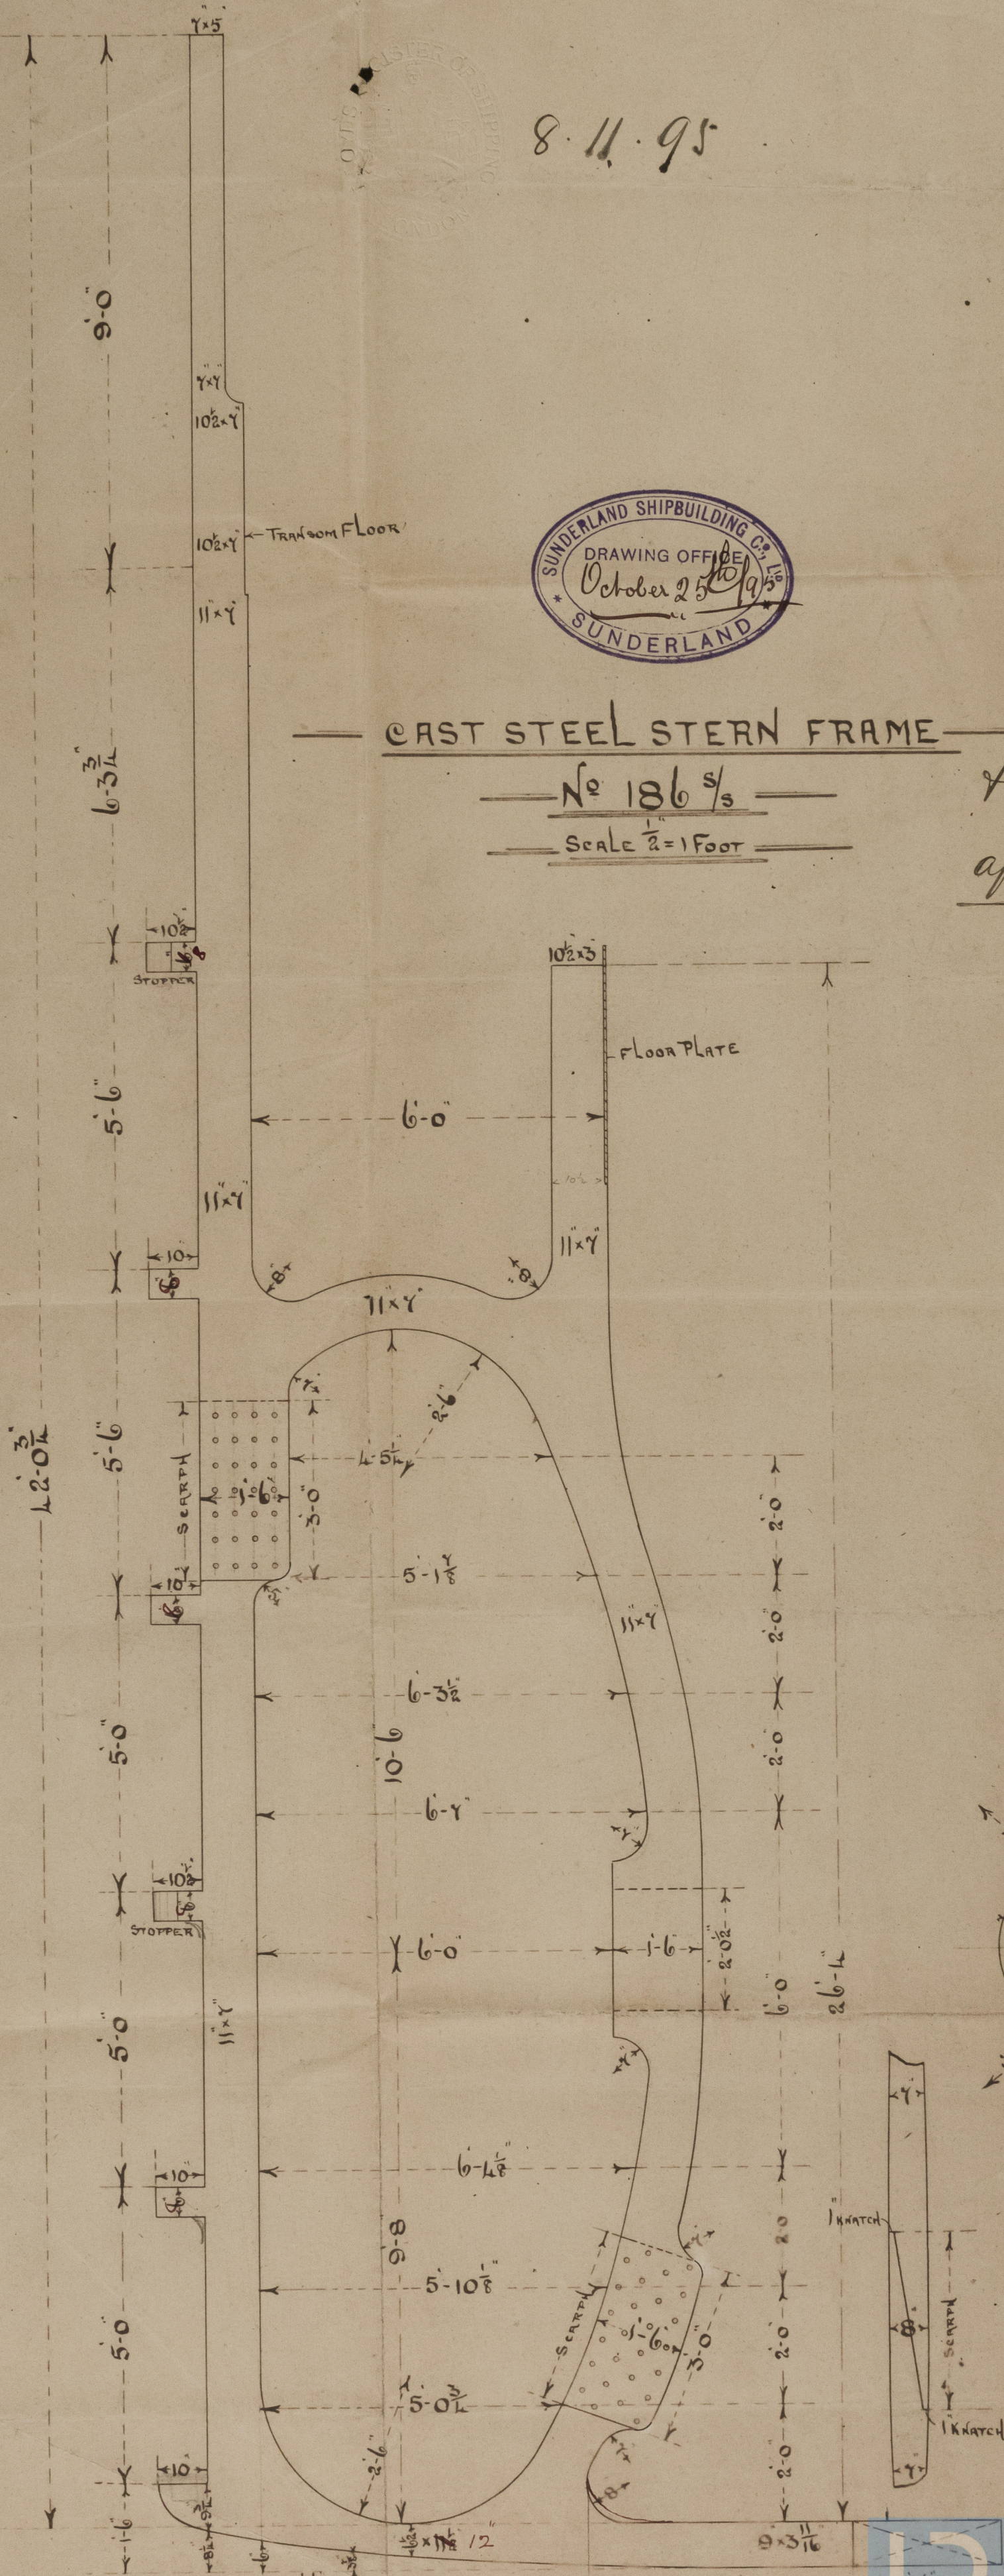

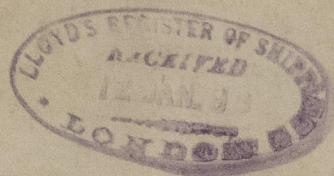

SUNDERLAND S.B. CO. (LIM.)  
- STERN POST -

- S.S. No 186 -

S.S. "NARRUNG"

- SLD. Report 18447 -

sister vessel to  
S.S. "Wakool"  
Sea 19431.

SLD1003-0205



© 2021

Lloyd's Register  
Foundation