

Lloyd's Register of British and Foreign Shipping.

(Report on Vessel No. 18455 Port SUNDERLAND.)

Sund

No. 3275 a SHIP FORGINGS OR CASTINGS.

The words FORGINGS or CASTINGS, IRON or STEEL, should be struck out as may be required.

I have to report that the undermentioned Iron or Steel Forgings or Castings, manufactured by Messrs R S Bagnall Son of Wylton for the Vessel No. 192, being built by Messrs J P Austin Son of Sunderland have been inspected by me as set forth below, and found to be, so far as can be seen, sound

Mark on Forgings.

Lloyd's
No. 3275 a
R. S.



Wugh Cameron

Sunderland

15. 8. 96

	STERN FRAME.	RUDDER FRAME.	STEM.
Material*	<u>Scrap iron</u>	<u>Scrap iron</u>	<u>Scrap iron</u>
How made	<u>Forged</u>	<u>Forged</u>	<u>Forged</u>
Dimensions	<u>8" x 4 3/4</u>	<u>5 3/4 - 5 7/8</u>	<u>7 1/2 x 2 3/8</u>
Progress on Inspection	<u>Forged & Smithed</u>	<u>Forged & Smithed</u>	<u>Forged</u>
Date when Inspected	<u>March 12th to 31/96</u>	<u>June 1st to July 29/96</u>	<u>March 21/96</u>

SKETCHES OF FRAMES SHOWING POSITION AND DESCRIPTION OF WELDS OF FORGINGS, OR PARTICULARS OF TESTS APPLIED TO CASTINGS.

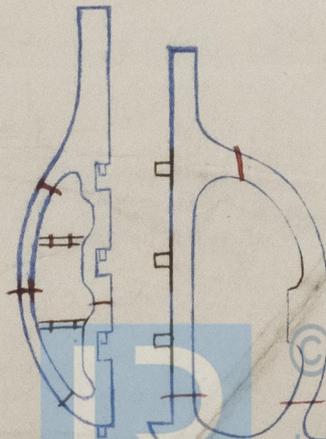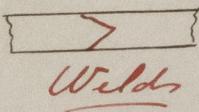

Fee (if any chargeable) £ : :

To be paid at _____

* If of Iron, state whether scrap or puddled Iron.