

Lloyd's Register of British and Foreign Shipping.

(Report on Vessel No. 18524 Port SUNDERLAND.)SundNo. 3390.2 SHIP FORGINGS OR CASTINGS.

I have to report that the undermentioned Iron or Steel Forgings or Castings,
manufactured by Messrs W Reed & Co.

of Sunderland for the Vessel No. 188, being built

by The Sunderland SBC. of Sunderland

have been inspected by me as set forth below, and found to be, so far as can be seen,

sound.

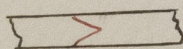
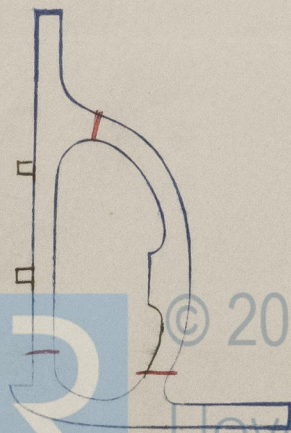
Mark on Forgings.

Lloyd's

No. 3390.2No. 6Hugh CameronSunderland15. 8. 96.

	STERN FRAME.	RUDDER FRAME.	STEM.
Material* ...	<u>Scrap iron</u>		
How made ...	<u>forged</u>		
Dimensions ...	<u>6 1/2 x 3 3/4</u>		
Progress on Inspection	<u>forged & smithed</u>		
Date when Inspected	<u>July 27th to Augt. 14/96</u>		

SKETCHES OF FRAMES SHOWING POSITION AND DESCRIPTION OF WELDS OF FORGINGS, OR PARTICULARS OF TESTS APPLIED TO CASTINGS.

Welds

Fee (if any chargeable) £ : :

To be paid at

* If of Iron, state whether scrap or puddled Iron.